



State of Rhode Island and Providence Plantations
Coastal Resources Management Council
Oliver H. Stedman Government Center
4808 Tower Hill Road, Suite 3
Wakefield, RI 02879-1900

(401) 783-3370
Fax (401) 783-3767

PUBLIC NOTICE

File Number: 1995-02-008 Modification Date: November 30, 2016

This office has under consideration the application of:

Thavenius Patricia Revocable Trust
51 Tolcott Notch Road
Avon, CT 06001

for a State of Rhode Island Assent to construct and maintain: Modification to previously approved residential boating facility for "As-built" steps along the side of fixed pier portion of facility.

Project Location:	26 Hunters Harbor Road
City/Town:	Charlestown
Plat/Lot:	77 / 31
Waterway:	Ninigret Pond

Plans of the proposed work may be seen at the CRMC office in Wakefield.


In accordance with the Administrative Procedures Act (Chapter 42-35 of the Rhode Island General Laws) you may request a hearing on this matter.

You are advised that if you have good reason to enter protests against the proposed work it is your privilege to do so. It is expected that objectors will review the application and plans thoroughly, visit site of proposed work if necessary, to familiarize themselves with the conditions and cite what law or laws, if any, would in their opinion be violated by the work proposed.

If you desire to protest, you must attend the scheduled hearing and give sworn testimony. A notice of the time and place of such hearing will be furnished you as soon as possible after receipt of your request for hearing. If you desire to request a hearing, to receive consideration, it should be in writing (**with your correct mailing address, e-mail address and valid contact number**) and be received at this office on or before December 30, 2016.

DOCK MODIFICATION PLAN
 PREPARED FOR
 ROBERT F. THAVENIUS
 A.M. 7 LOT 31
 SITUATED IN THE TOWN OF
 CHARLESTOWN, RHODE ISLAND

NO.	REVISION	DATE
1.	CRMC COMMENTS	09/01/18
2.	CRMC COMMENTS	09/27/18

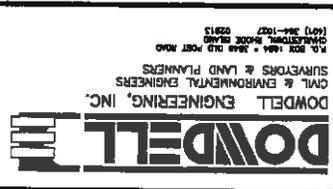

DATE: JULY 13, 2018	SCALE: 1"=20'
DESIGNED BY: W.D.	APPROVED BY: W.D.
DRAWN BY: W.D.	CHECKED BY: W.D.
SHEET: 1 OF 1 SHEETS	





A.M. 7/LOT 31-1

A.M. 7/LOT 31
 2.1526 ACRES±

REFERENCE:
 ORIGINAL ASSESS #1995-02-0008

OCT 26 2016

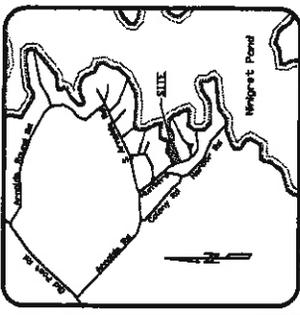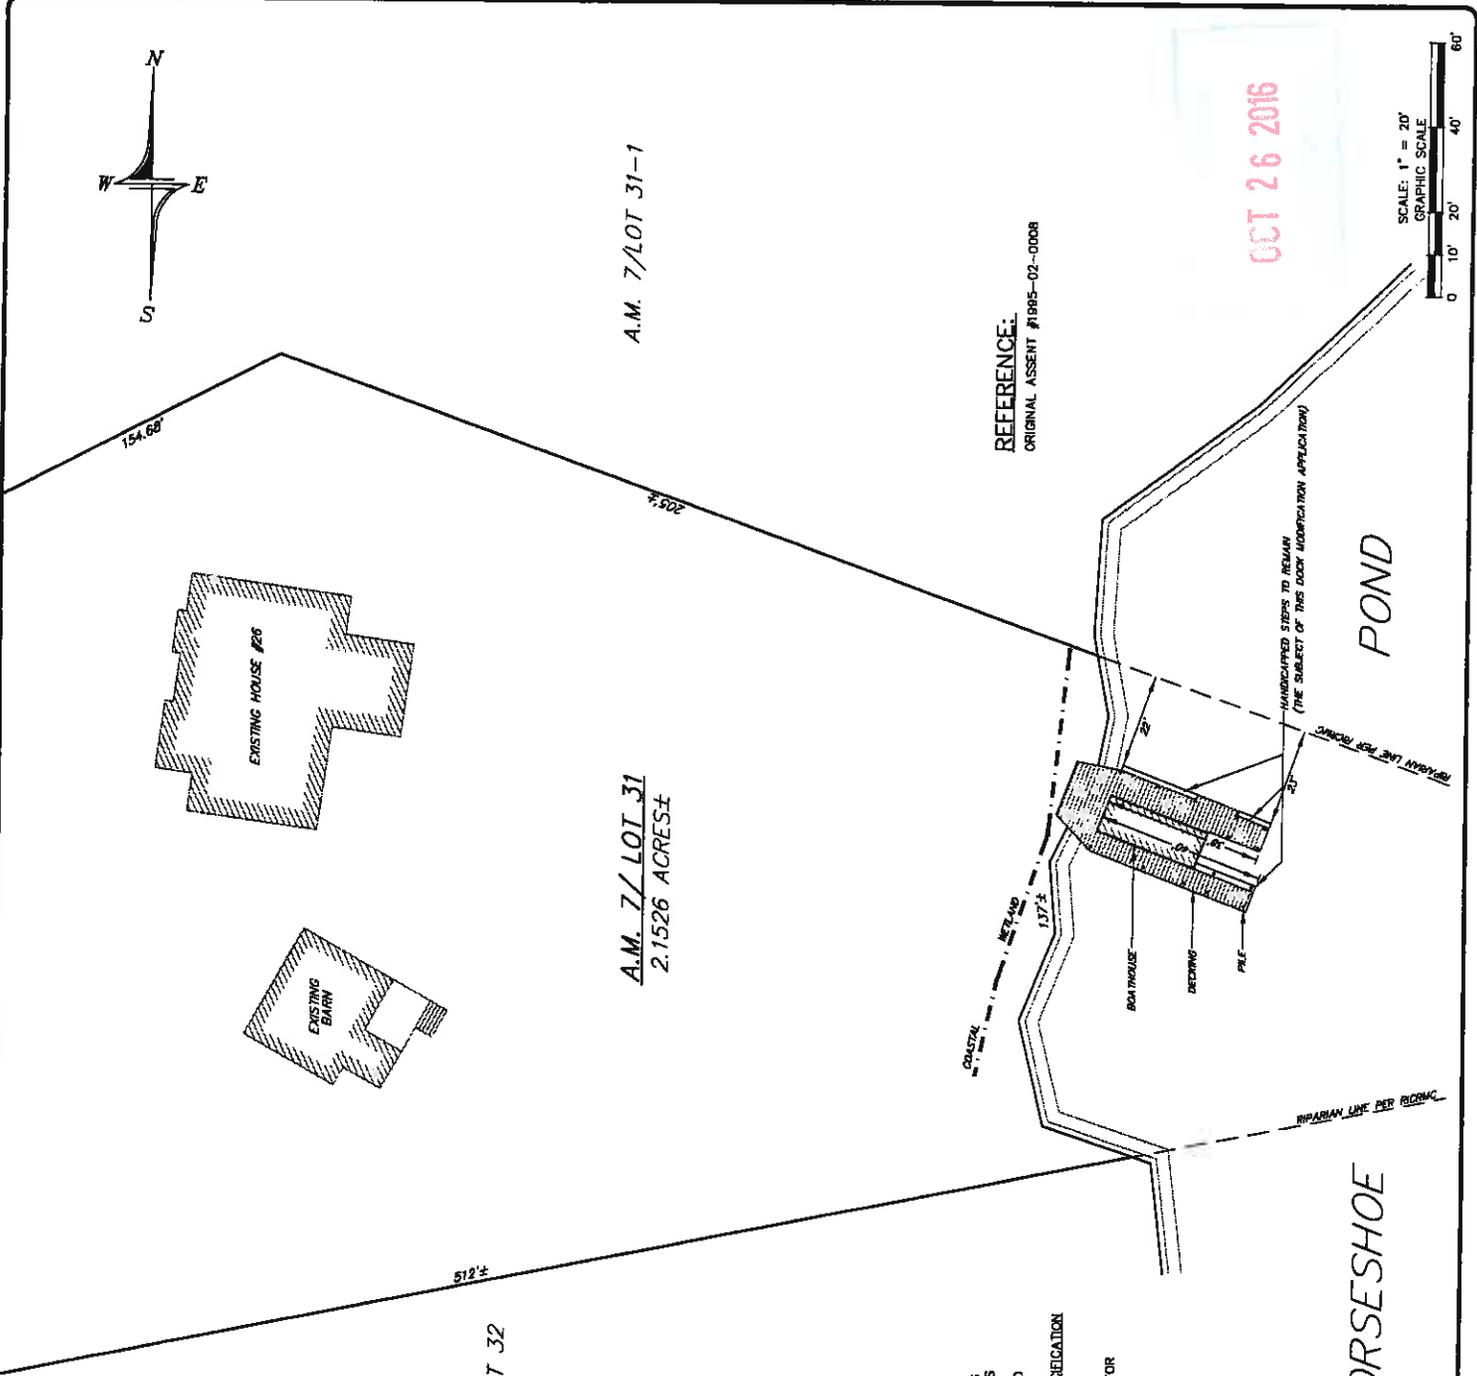

A.M. 7/LOT 32



CERTIFICATION:
 THIS SURVEY HAS BEEN CONDUCTED AND THE PLAN HAS BEEN PREPARED PURSUANT TO SECTION 9 OF THE RULES AND REGULATIONS ADOPTED BY THE THE RHODE ISLAND STATE BOARD OF REGISTRATION FOR PROFESSIONAL LAND SURVEYORS ON JAN. 15, 2016, AS FOLLOWS:
 TYPE OF BOUNDARY SURVEY: MEASUREMENT/SEGREGATION
 STATEMENT OF JURISDICTION: III
 THE PURPOSE FOR THE CONDUCT OF THE SURVEY AND FOR THE PREPARATION OF THIS PLAN IS AS FOLLOWS:
 TO DETERMINE THE POSITION OF THE EXISTING HANDICAPPED STEPS TO THE RICMC RIPARIAN LINE.

BY: RICHARD L. COUCHON, RIPLS #1820
 CERTIFICATE OF AUTHORIZATION #0004428

FLOOD ZONE:
 ZONE "AE"
 ELEV. = 12' NAVD 1988

OWNER/APPLICANT:
 ROBERT F. THAVENIUS
 51 TALCOTT NOTCH
 AVON, CT 06001

POND

HORSESHOE