



State of Rhode Island
Coastal Resources Management Council
Oliver H. Stedman Government Center
4808 Tower Hill Road, Suite 3
Wakefield, RI 02879-1900

(401) 783-3370
Fax (401) 783-2069

PUBLIC NOTICE

File Number: 2005-04-071 Modification Date: August 31, 2022

This office has under consideration the application of:

**Sameh & Nancy Said
14 Honeysuckle Lane
Portsmouth, RI 02871**

for a State of Rhode Island Assent to Modify existing residential boating facility. Modification to include: Removal of unauthorized stairway adjacent to dock, “as-built” approval of fixed pier extending from platform at top of Coastal Feature (footpath over portion of Feature originally approved).

Project Location:	14 Honeysuckle Lane
City/Town:	Portsmouth
Plat/Lot:	29 / 127A
Waterway:	Sakonnet River

Plans of the proposed work can be requested at Cstaff1@crmc.ri.gov.

In accordance with the Administrative Procedures Act (Chapter 42-35 of the Rhode Island General Laws) you may request a hearing on this matter.

You are advised that if you have good reason to enter protests against the proposed work it is your privilege to do so. It is expected that objectors will review the application and plans thoroughly, visit site of proposed work if necessary, to familiarize themselves with the conditions and cite what law or laws, if any, would in their opinion be violated by the work proposed.

If you desire to protest, you must attend the scheduled hearing and give sworn testimony. A notice of the time and place of such hearing will be furnished you as soon as possible after receipt of your request for hearing. If you desire to request a hearing, to receive consideration, it should be in writing (**with your correct mailing address, e-mail address and valid contact number**) and be received at this office on or before September 30, 2022.

Please email your comments/hearing requests to: cstaff1@crmc.ri.gov; or mail via USPS to: Coastal Resources Management Council; O. S. Government Center, 4808 Tower Hill Road, Rm 116; Wakefield, RI 02879.

/lat



EXISTING DECK
WAS PARTIALLY
REMOVED AS OF
07/05/2022.
NEW 4'W x 7.5'L
LANDING AREA

STAIRS REMOVED
AS OF 07/05/2022

AS-BUILT CONDITIONS OF
DOCK/STAIRS & LANDING
SHOWS CHANGES FROM ORIGINAL
APPROVAL OF CRMC ASSENT
#2005-04-071

BRICK PATIO
AREA TO REMAIN

EXISTING DOCK
CRMC ASSENT
#2005-04-071

PROPOSED DOCK
ADDITION & BOAT LIFT
CRMC ASSENT
#2022-02-020

#14
EXISTING
DWELLING

MAP 29
LOT 127A


LANDSCAPE
AREA

EXISTING STAIRS &
PATH TO REMAIN

EL. 3.6 MHW

EL. 0.0 MLW

SAKONNET
RIVER
(TYPE 2 WATERS)

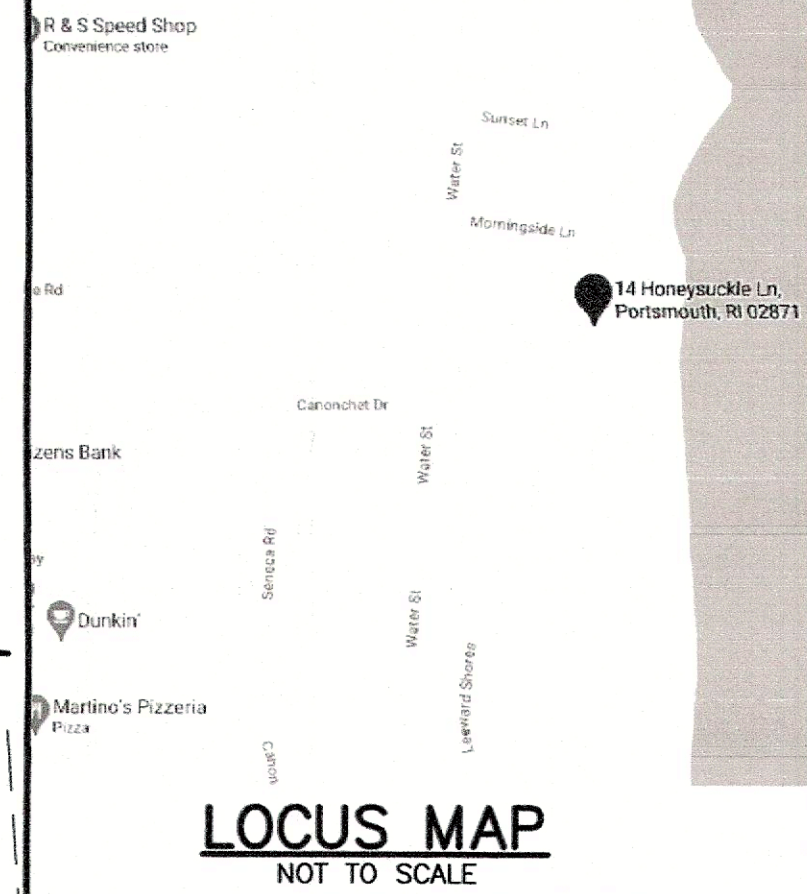

LEGEND

- (56) --- EXISTING CONTOURS
- (56) --- PROPOSED CONTOURS
- D --- DRAIN LINE
- SF --- PROPOSED SILT FENCE



PLAN TO ACCOMPANY CRMC APPLICATION	
PREPARED FOR: SAMEH SAID 14 HONEYSUCKLE LANE PORTSMOUTH, RI 02871	SCALE: 1" = 20' DATE: 07/12/22
OWNED BY: SAMEH SAID	DRAWN: AB
LOCATION: MAP 29, LOT 127A 14 HONEYSUCKLE LANE, PORTSMOUTH	DESIGN: TC
TODD CHAPLIN No. 533 REGISTERED PROFESSIONAL ENGINEER	CHECKED: TC
Mount Hope ENGINEERING CIVIL/ENVIRONMENTAL SERVICES Post Office Box 943 Portsmouth, Rhode Island 02871 (401) 683-1934/(508) 379-1234	PROJECT NO. 2021-498
	SHEET NO. 1 OF 1