



Oliver Stedman Government Center
4808 Tower Hill Road; Suite 116
Wakefield, RI 02879
401-783-3370

PUBLIC NOTICE

File Number: 2013-05-131 Date: June 5, 2013

This office has under consideration the application of:

Luis M. & Djamilia Junco
105 Budlong Farm Road
Warwick, RI 02889

for a State of Rhode Island Assent to construct and maintain: "as-built" structural shoreline protection facility (ref. Cease & Desist Order No. 12-0031, dated 5/9/12) and proposed additional structural measures (additional slope protection at west end; additional toe protection; additional pinning of structural components); approx. 163 linear feet total length.


Project Location:	105 Budlong Farm Road "Buttonwoods" vicinity
City/Town:	Warwick
Plat/Lot:	369 / 242
Waterway:	Greenwich Bay (type 2)

Plans of the proposed work may be seen at the CRMC office in Wakefield.

In accordance with the Administrative Procedures Act (Chapter 42-35 of the Rhode Island General Laws) you may request a hearing on this matter.

You are advised that if you have good reason to enter protests against the proposed work it is your privilege to do so. It is expected that objectors will review the application and plans thoroughly, visit site of proposed work if necessary, to familiarize themselves with the conditions and cite what law or laws, if any, would in their opinion be violated by the work proposed.

If you desire to protest, you must attend the scheduled hearing and give sworn testimony. A notice of the time and place of such hearing will be furnished you as soon as possible after receipt of your request for hearing. If you desire to request a hearing, to receive consideration, it should be in writing (**with your correct mailing address, e-mail address and valid contact number**) and be received at this office on or before July 5, 2013.

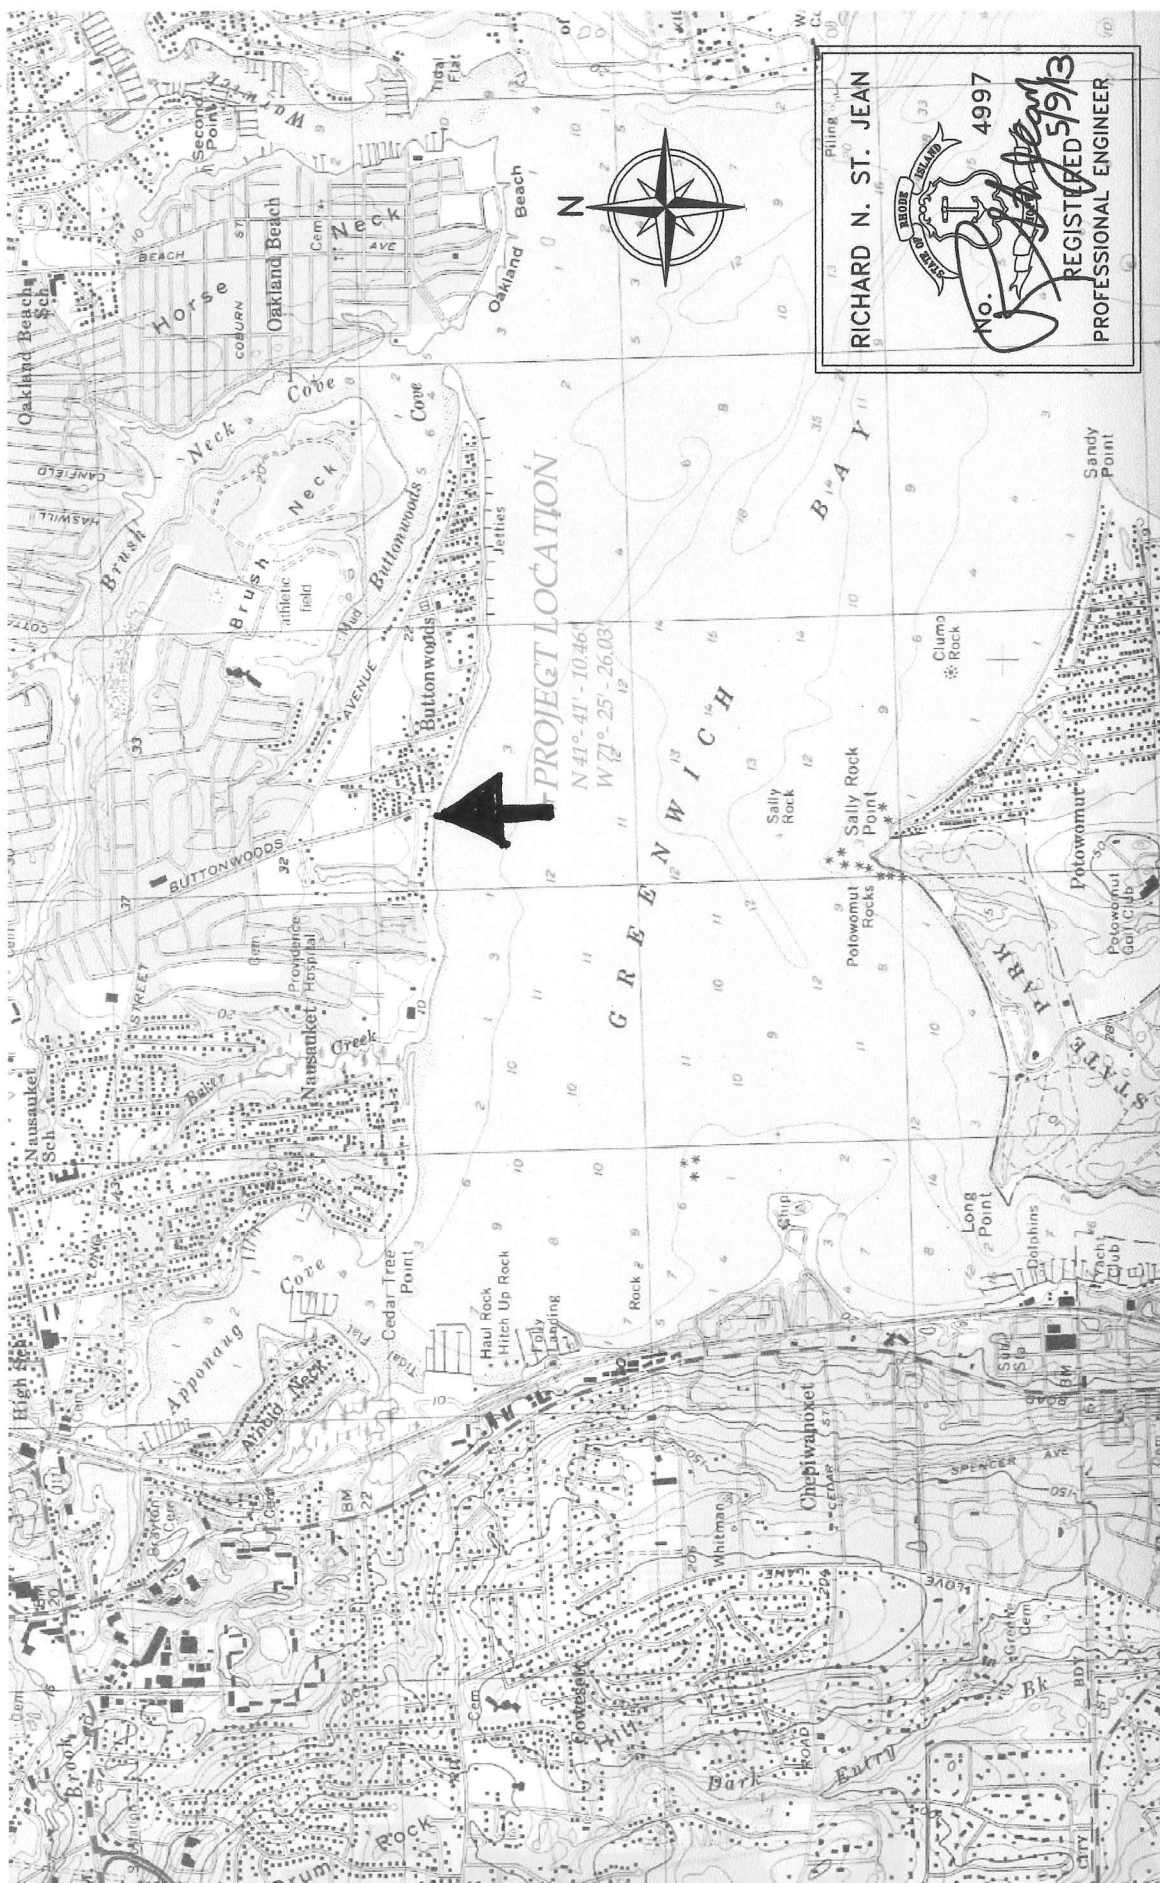

DATE
JANUARY 10, 2013

DWG.
SHT. 1 OF 10

Concrete Block Revetment USGS Map - East Greenwich 1996


REVISIONS:


APPLICATION BY:
Luis M. Junco
105 Budlong Farm Road
Warwick, Rhode Island 02889

LOCATION: GREENWICH BAY
105 BUDLONG FARM RD.
WARWICK, RI
A.P. 369, LOT 242

**ST. JEAN
ENGINEERING
LLC**

Civil, Marine & Structural Engineering
1145 Middle Road, East Greenwich, RI 02818
Tel: 401.398.0999
email: st.jean.engineering@verizon.net

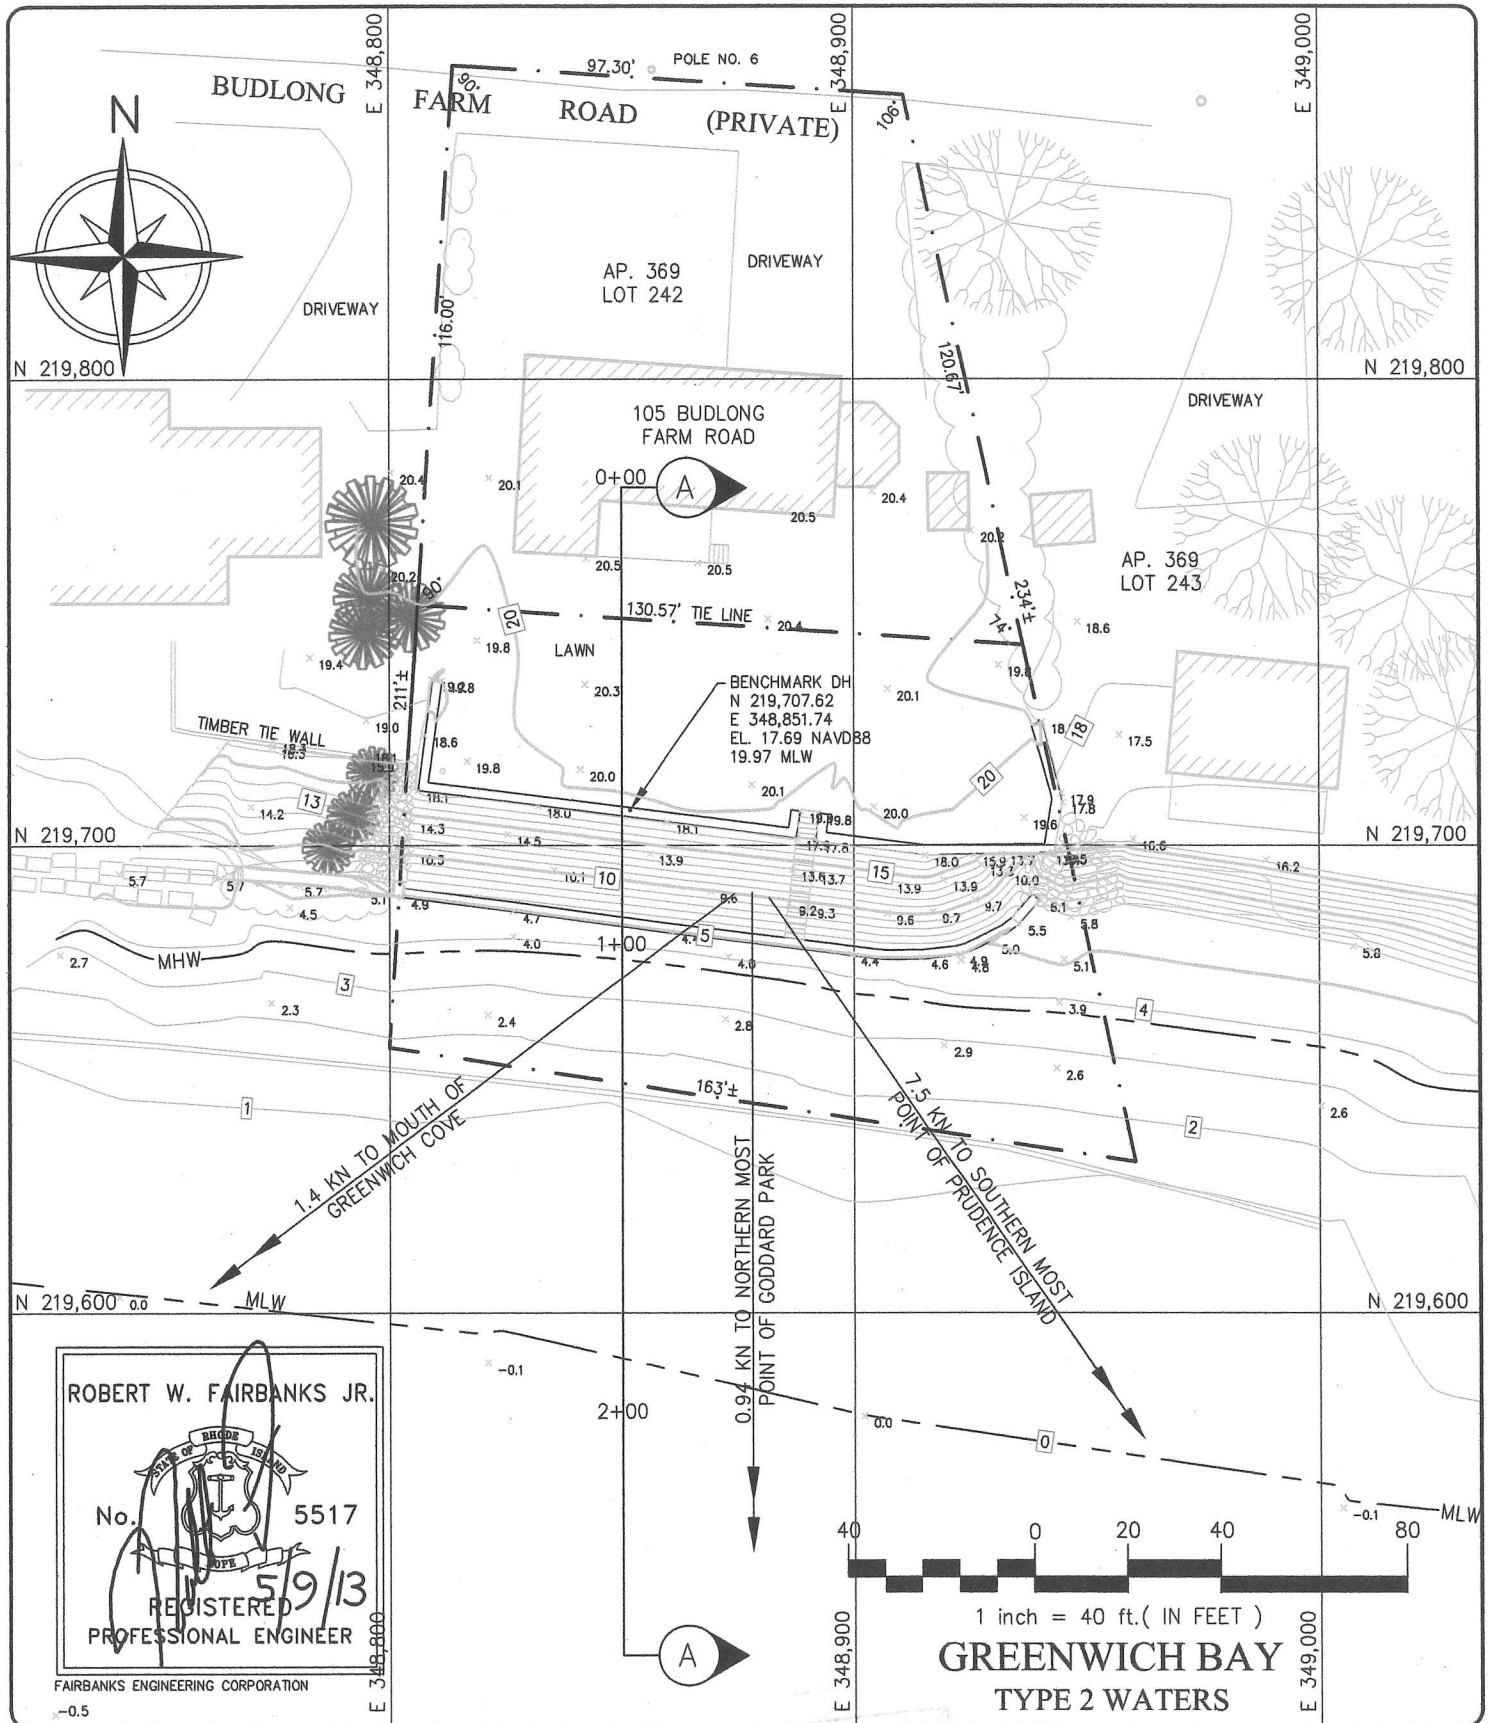

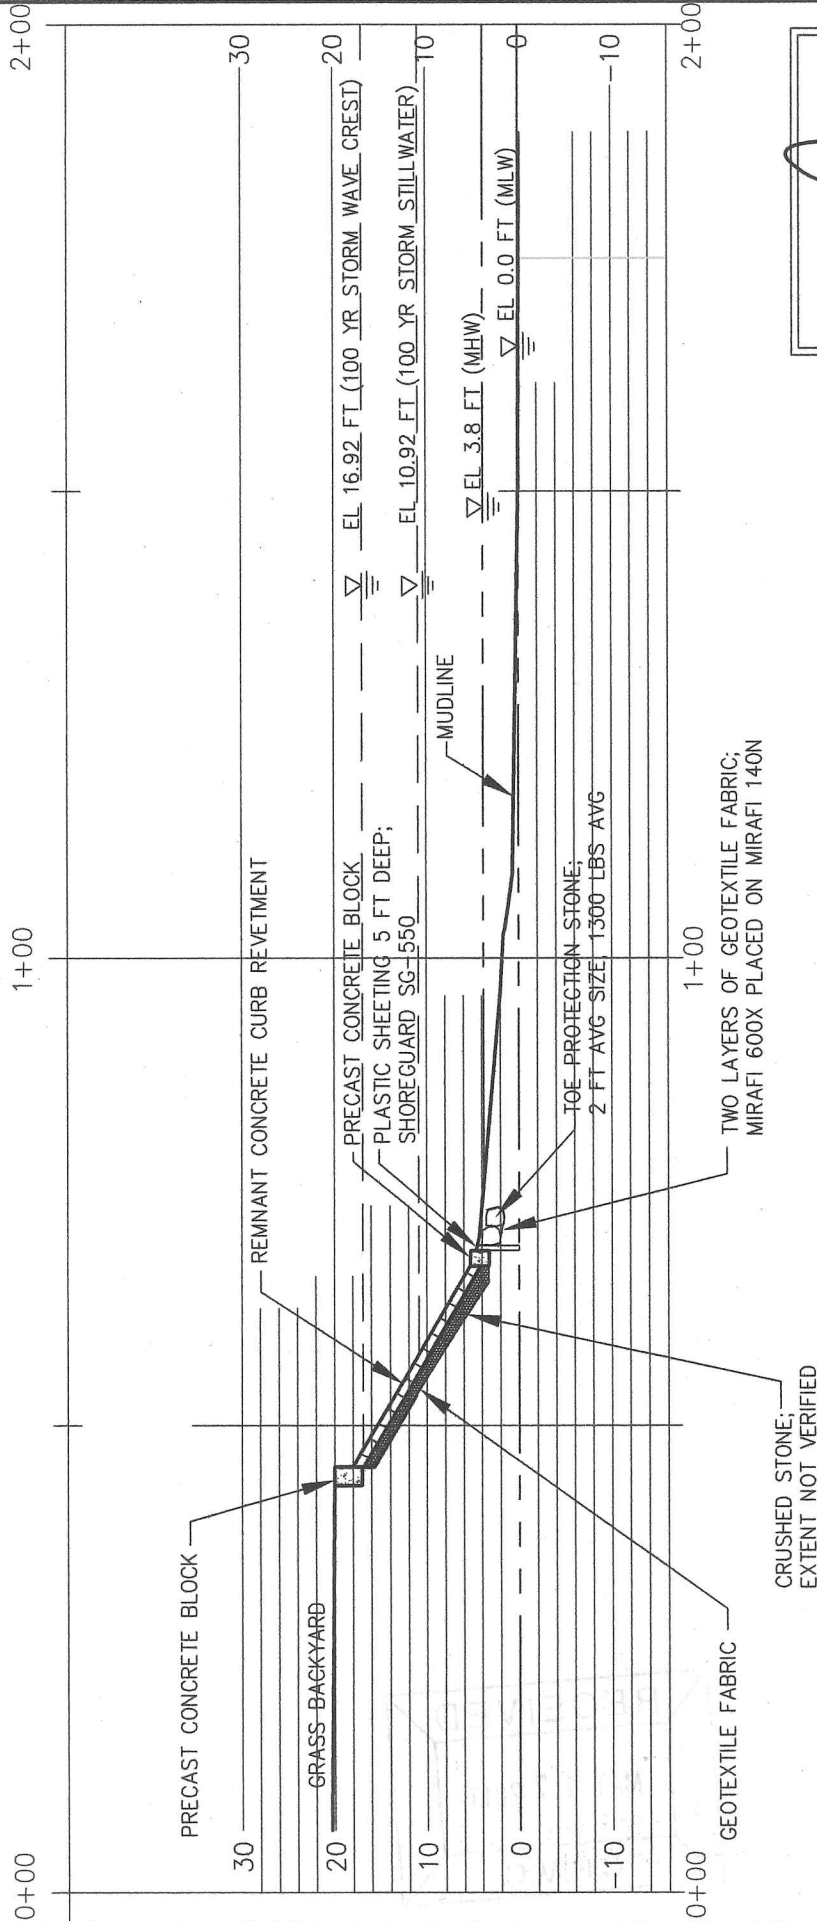

TYP. SECTION THROUGH PROPOSED RETEMENT B-B

SCALE: 1" = 20'

ROBERT W. FAIRBANKS JR.

No. 5517

5/9/13
REGISTERED
PROFESSIONAL ENGINEER

FAIRBANKS ENGINEERING CORPORATION

ST. JEAN
ENGINEERING
LLC

Civil, Marine & Structural Engineering
1145 Middle Road,
East Greenwich, RI 02818
Tel: 401.398.0999
email: st.jean.engineering@verizon.net

Concrete Block Retevment Section B-B

LOCATION: GREENWICH BAY
105 BUDLONG FARM RD.
WARWICK, RI
A.P. 369, LOT 242

APPLICATION BY:
Luis M. Junco
105 Budlong Farm Road
Warwick, Rhode Island 02889

REVISIONS:

DATE

JANUARY 10, 2013

DWG.

SHT. 9 OF 10