



Oliver Stedman Government Center
4808 Tower Hill Road; Suite 116
Wakefield, RI 02879
401-783-3370

PUBLIC NOTICE

File Number: 2016-09-012 Date: September 20, 2016

This office has under consideration the application of:

WH Properties, Inc.
8 Sound Shore Drive
Suite 140
Greenwich, CT 06830

for a State of Rhode Island Assent to: maintain an as-built boating facility consisting of a 3' x 12' wooden ramp and two 5'x 20' floats. The facility extends 47' beyond mean low water to a depth of approximately 7 feet. The boating facility is associated with a commercial property (Bridge Restaurant and Bar).

Project Location:	37 Main Street
City/Town:	Westerly
Plat/Lot:	56 / 10
Waterway:	Pawcatuck River

Plans of the proposed work may be seen at the CRMC office in Wakefield.



In accordance with the Administrative Procedures Act (Chapter 42-35 of the Rhode Island General Laws) you may request a hearing on this matter.

You are advised that if you have good reason to enter protests against the proposed work it is your privilege to do so. It is expected that objectors will review the application and plans thoroughly, visit site of proposed work if necessary, to familiarize themselves with the conditions and cite what law or laws, if any, would in their opinion be violated by the work proposed.

If you desire to protest, you must attend the scheduled hearing and give sworn testimony. A notice of the time and place of such hearing will be furnished you as soon as possible after receipt of your request for hearing. If you desire to request a hearing, to receive consideration, it should be in writing (**with your correct mailing address, e-mail address and valid contact number**) and be received at this office on or before October 20, 2016.


CHERENZIA & ASSOCIATES, LTD.

P.O. Box 513
Westery, R.I. 02891
Phone: (860)629-6500
Fax: (860)599-6090

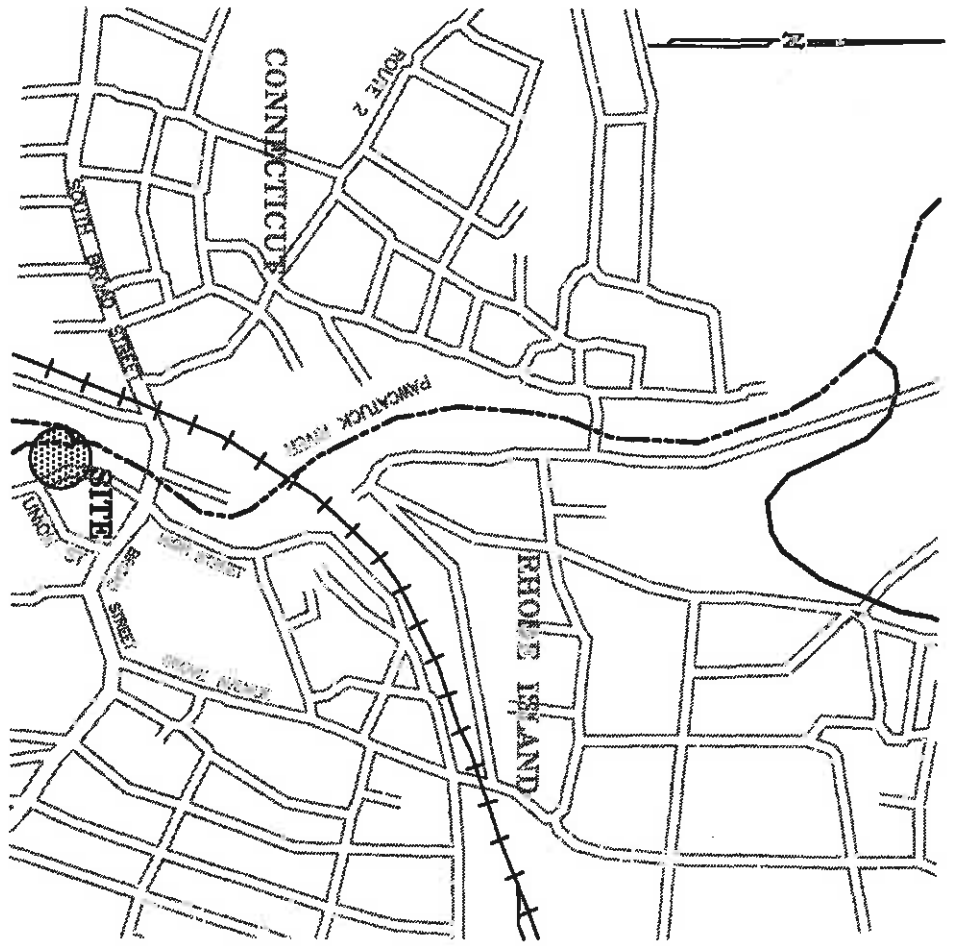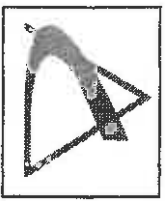


LOCUS MAP

Scale: 1" = 1,200' ±

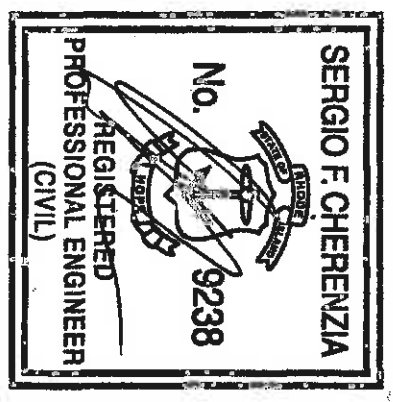

RESIDENTIAL DOCK FOR:
WH PROPERTIES
(THREE FISH), LLC
PLAT 56, LOT 10
37 MAIN STREET
TOWN OF WESTERLY
COUNTY OF WASHINGTON
STATE OF RHODE ISLAND
AUGUST 29, 2016

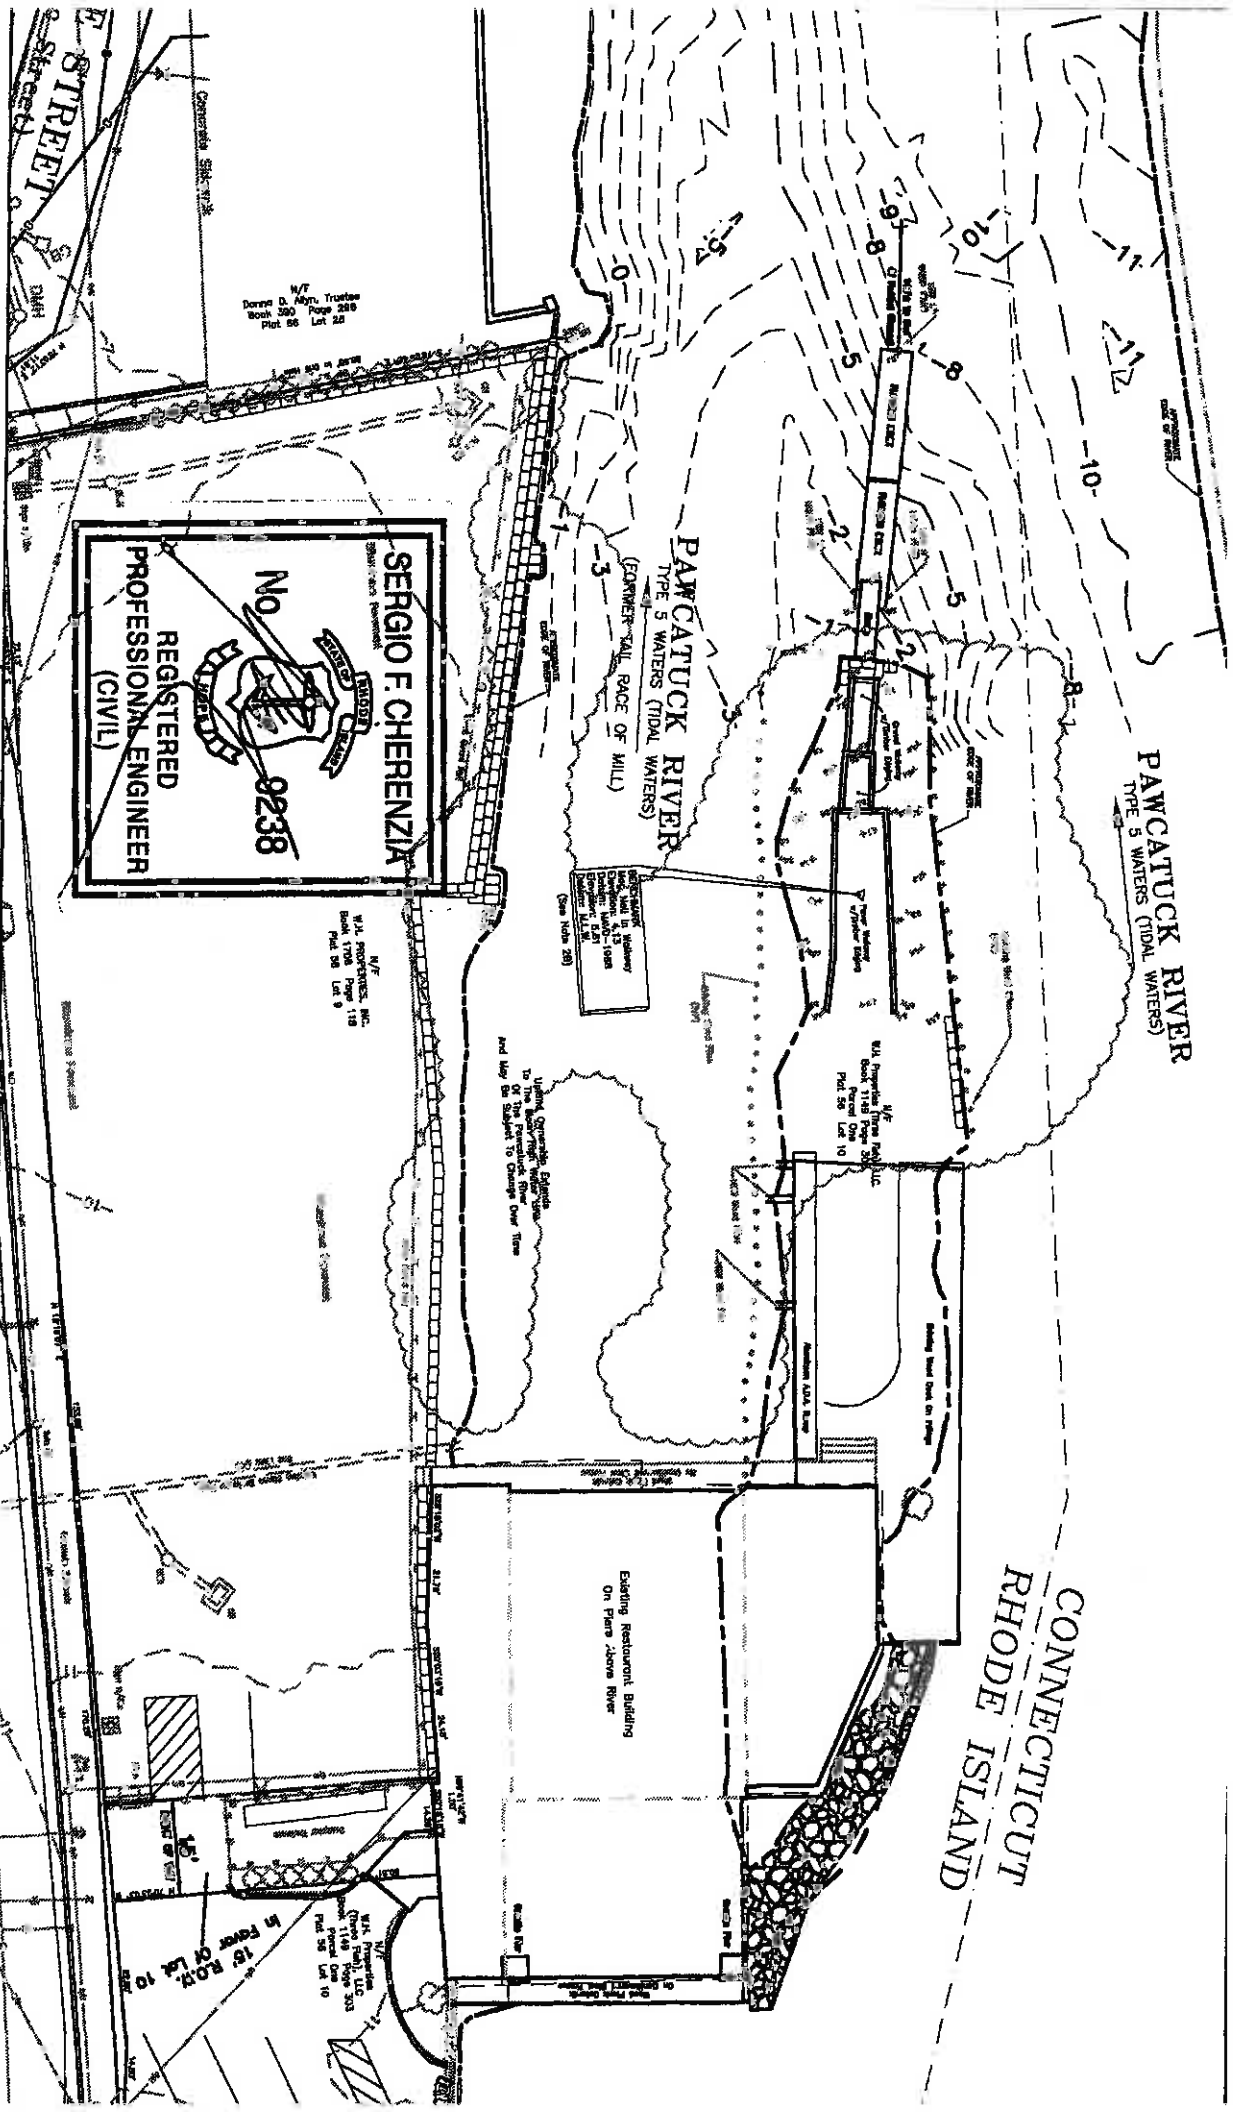

CHERENZIA & ASSOCIATES, LTD.

P.O. Box 513
 Westerly, R.I. 02891
 Phone: (860)629-6500
 Fax: (860)599-6090




**OVERALL
 SITE PLAN**

1" = 30'

RESIDENTIAL DOCK FOR:
**WH PROPERTIES
 (THREE FISH), LLC**
 PLAT 56, LOT 10
 37 MAIN STREET
 TOWN OF WESTERLY
 COUNTY OF WASHINGTON
 STATE OF RHODE ISLAND
 AUGUST 29, 2016

Job No. 216055
 Sheet 2 of 6


Existin
(TYP)

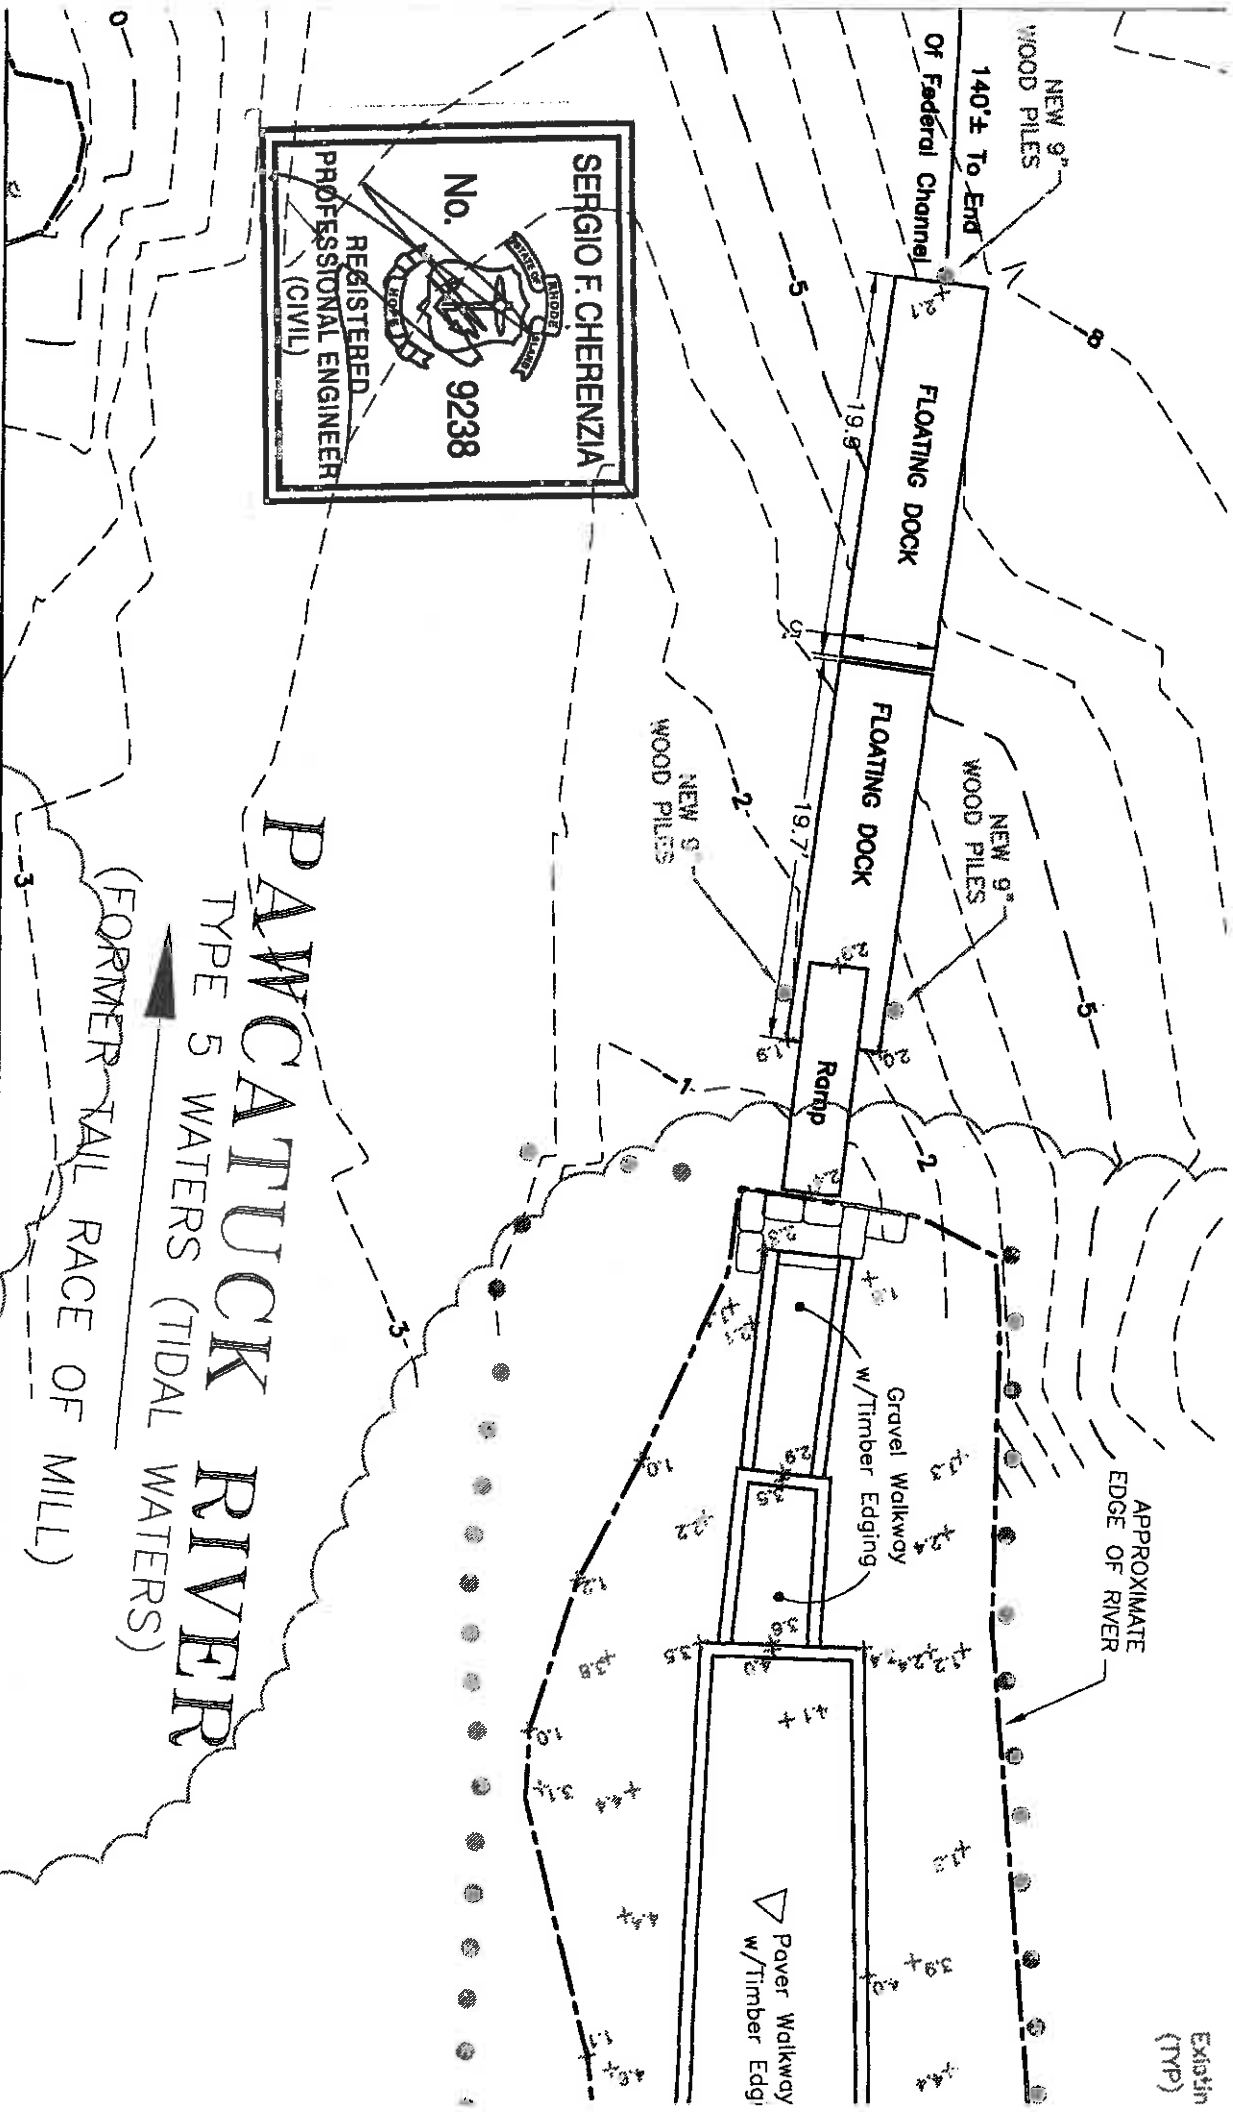

SERGIO F. CHERENZIA
 No. 9238
 REGISTERED PROFESSIONAL ENGINEER (CIVIL)

CHERENZIA & ASSOCIATES, LTD.

P.O. Box 513
 Westerly, R.I. 02891
 Phone: (860)629-6500
 Fax: (860)599-6090

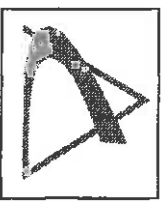



SITE PLAN

1" = 10'

RESIDENTIAL DOCK FOR:
WH PROPERTIES
(THREE FISH), LLC
 PLAT 56, LOT 10
 37 MAIN STREET
 TOWN OF WESTERLY
 COUNTY OF WASHINGTON
 STATE OF RHODE ISLAND
 AUGUST 29, 2016


Job No. 216055
 Sheet 3 of 6

MHW = 0.91
 NAVD = 0.00
 MLW = -1.66

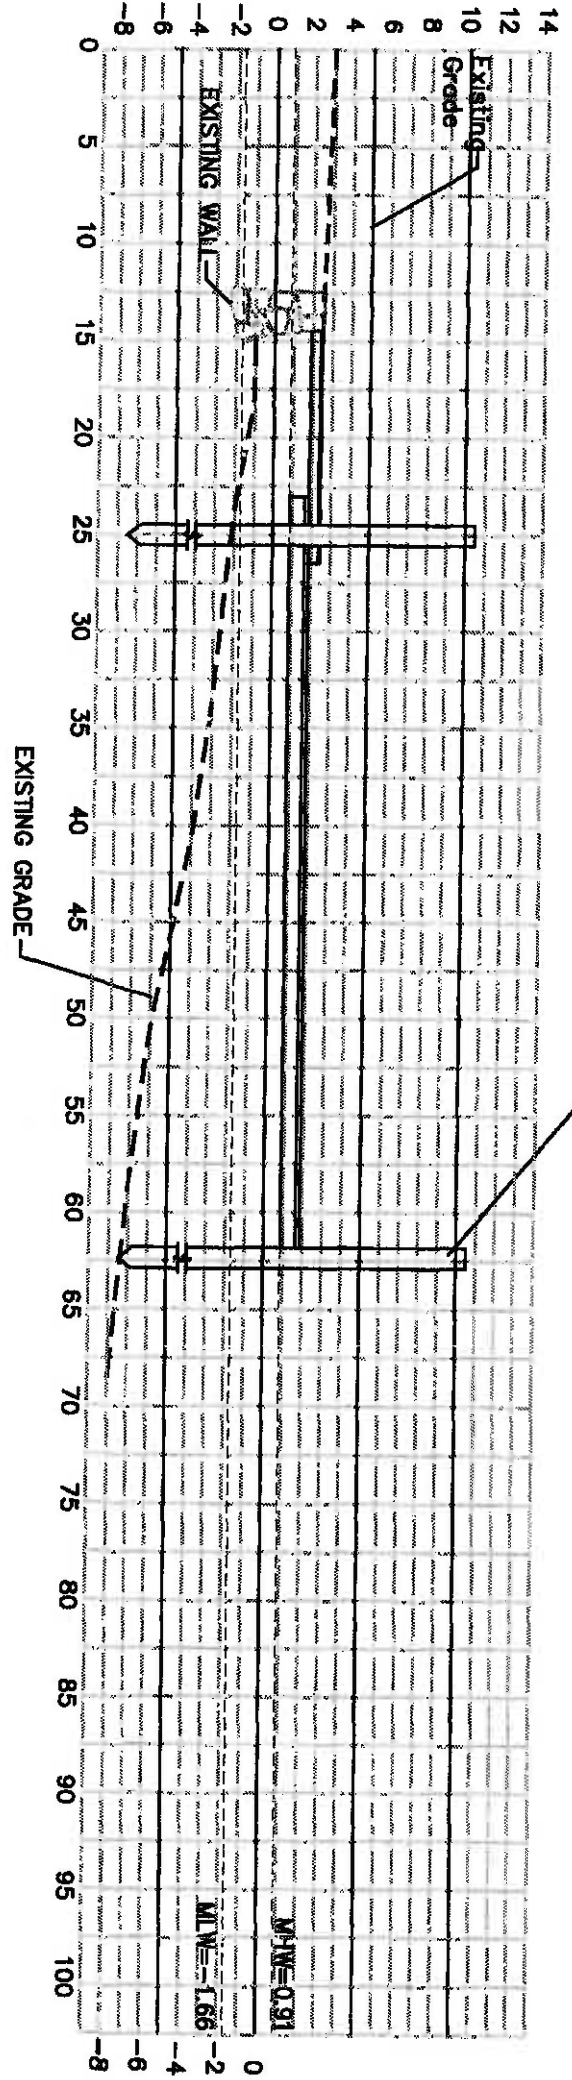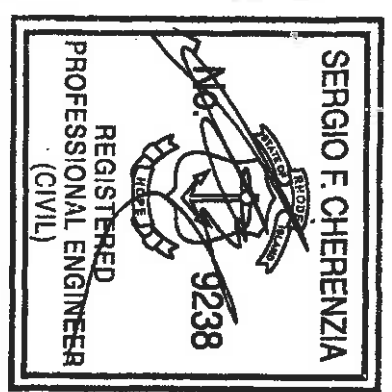

CHERENZIA & ASSOCIATES, LTD.

P.O. Box 513
 Westerly, R.I. 02891
 Phone: (860)629-6500
 Fax: (860)599-6090

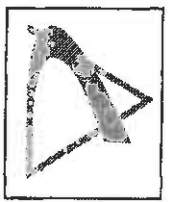


DOCK SECTION

RESIDENTIAL DOCK FOR:
WH PROPERTIES
(THREE FISH), LLC
 PLAT 56, LOT 10
 37 MAIN STREET
 TOWN OF WESTERLY
 COUNTY OF WASHINGTON
 STATE OF RHODE ISLAND
 AUGUST 29, 2016


Job No. 216055
 Sheet 4 of 6

1. ALL FRAMING LUMBER SHALL BE CCA TREATED TO .4 PCF
2. PILES SHALL BE 12-3-8 ASTM D25 CLASS A CCA TREATED TO 1.0 PCF
3. ALL METAL PIECES, INCLUDING NAILS, BOLTS, WASHERS, CLIPS, ETC. SHALL BE HOT DIPPED GALVANIZED.
4. ALL PILES TO BE CAPPED WITH PVC OR ALUMINUM POST CAPS.
5. FLOAT TO MEET 20 LBS PSF LIVE LOAD. RAMP TO MEET 40 LBS PSF LIVE LOAD, 10 LBS DEAD LOAD AND 400 LB CONCENTRATED LOAD.

9" DIA. ASTM D25 CLASS A
 VERTICAL PILE (TYP.)
 (1.0 CCA TREATED)

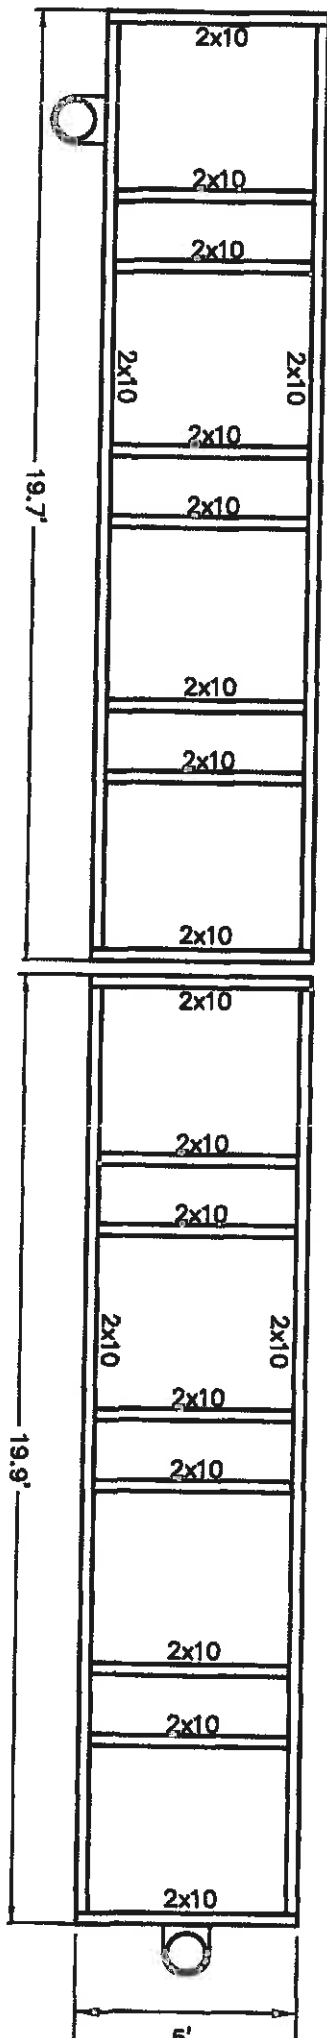


FLOAT FRAMING PLAN
 NTS

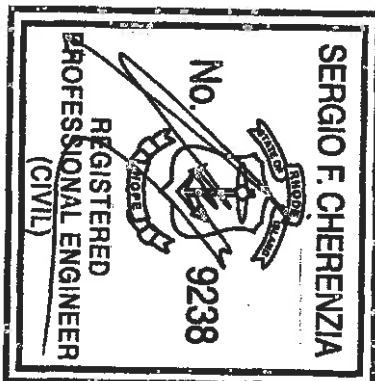

CHERENZIA & ASSOCIATES, LTD.


P.O. Box 513
 Westerly, R.I. 02891
 Phone: (860)629-6500
 Fax: (860)599-6090

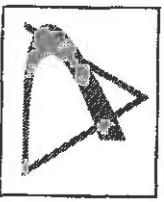

**FLOATING DOCK
 PLAN**

RESIDENTIAL DOCK FOR:
**WH PROPERTIES
 (THREE FISH), LLC**
 PLAT 56, LOT 10
 37 MAIN STREET
 TOWN OF WESTERLY
 COUNTY OF WASHINGTON
 STATE OF RHODE ISLAND
 AUGUST 29, 2016


NOTE:
 1"x6" DECKING ON RAMP SPACED 1/2" APART.
 ALL LUMBER IS PRESSURE TREATED.
 ALL HARDWARE TO BE HOT DIPPED GALVANIZED.

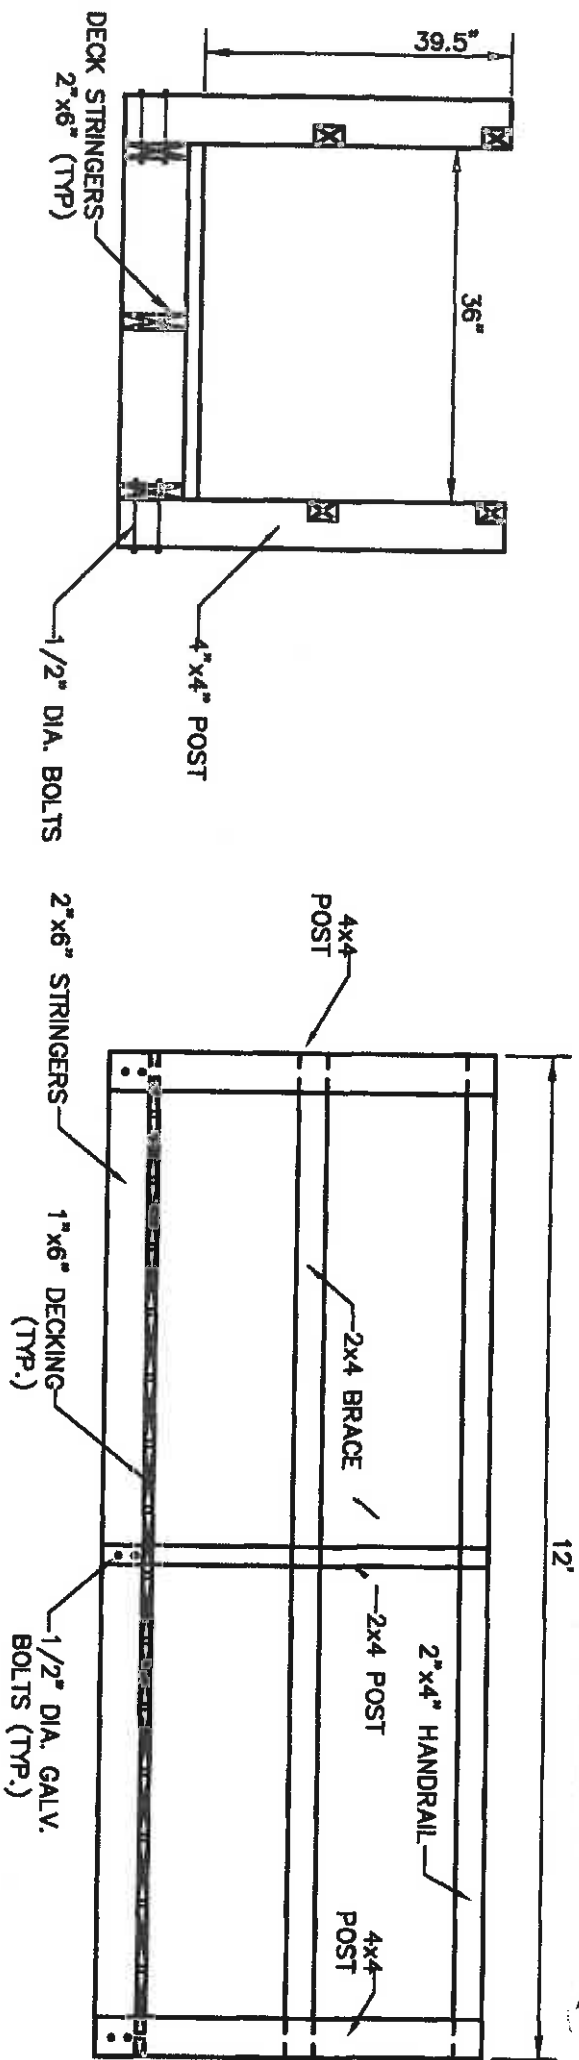

RAMP SECTION

CHERENZIA & ASSOCIATES, LTD.

P.O. Box 513
 Westerly, R.I. 02891
 Phone: (860)629-8500
 Fax: (860)599-6090

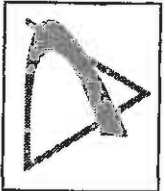

**RAMP DETAILS
 SCALE-NTS**

RESIDENTIAL DOCK FOR:
WH PROPERTIES
(THREE FISH), LLC
 PLAT 56, LOT 10
 37 MAIN STREET
 TOWN OF WESTERLY
 COUNTY OF WASHINGTON
 STATE OF RHODE ISLAND
 AUGUST 29, 2016