



State of Rhode Island and Providence Plantations  
**Coastal Resources Management Council**  
 Oliver H. Stedman Government Center  
 4808 Tower Hill Road, Suite 3  
 Wakefield, RI 02879-1900

(401) 783-3370  
 Fax (401) 783-2069

**PUBLIC NOTICE**

File Number: 2018-11-023 Date: January 14, 2019

This office has under consideration the application of:

Anildo & Maria Desenna  
 60 Pine Street  
 Rehoboth, MA 02769

for a State of Rhode Island Assent to construct and maintain: Modifications to existing dock consisting of: “as-built” float lift; removal of piling; installation of boat lift. Both the Float Lift and Boat Lift require a variance to 1.3.1(P)

Project Location:	29 Atlantic Avenue
City/Town:	Portsmouth
Plat/Lot:	29 / 80
Waterway:	Sakonnet River


Plans of the proposed work may be seen at the CRMC office in Wakefield.

In accordance with the Administrative Procedures Act (Chapter 42-35 of the Rhode Island General Laws) you may request a hearing on this matter.

You are advised that if you have good reason to enter protests against the proposed work it is your privilege to do so. It is expected that objectors will review the application and plans thoroughly, visit site of proposed work if necessary, to familiarize themselves with the conditions and cite what law or laws, if any, would in their opinion be violated by the work proposed.

If you desire to protest, you must attend the scheduled hearing and give sworn testimony. A notice of the time and place of such hearing will be furnished you as soon as possible after receipt of your request for hearing. If you desire to request a hearing, to receive consideration, it should be in writing (**with your correct mailing address, e-mail address and valid contact number**) and be received at this office on or before February 14, 2019.

/lat

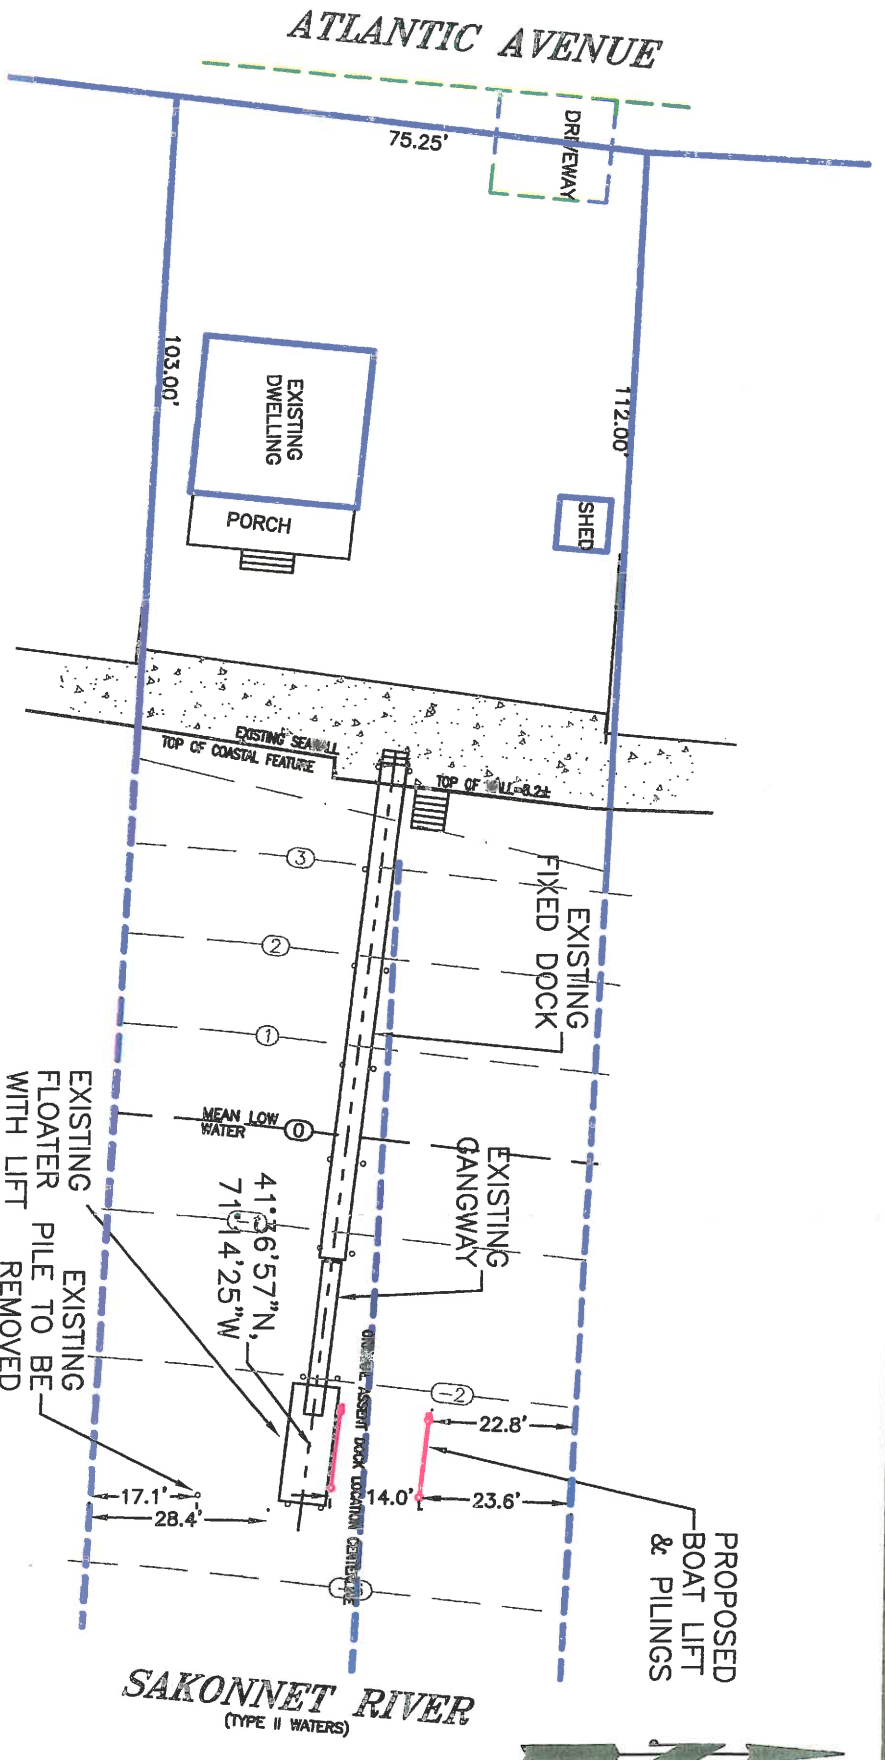

( IN FEET )  
1 inch = 30 ft.

SHEET 4 OF 6

PURPOSE: CONSTRUCTION OF BOAT LIFT TO EXISTING DOCK  
 IN: SAKONNET RIVER, PORTSMOUTH, RI  
 29 ATLANTIC AVE. PORTSMOUTH  
 DATUM: MHW = 3.5  
 MLW = 0.0

**RECEIVED**  
**NOV 07 2018**  
 COASTAL RESOURCES MANAGEMENT COUNCIL

DATE: 09/14/18  
 REVISED: 10/25/18

**PLAN VIEW**


APPLICATION BY:  
 ARNOLD DeSENNA  
 4 ELLIS STREET  
 SEEKONK, MA 02771

BY: MOUNT HOPE ENGINEERING, INC.  
 1788 G.A.R. HIGHWAY  
 SWANSEA, MA. 02777


TODD CHAPLIN

REGISTERED PROFESSIONAL ENGINEER

No. 5535

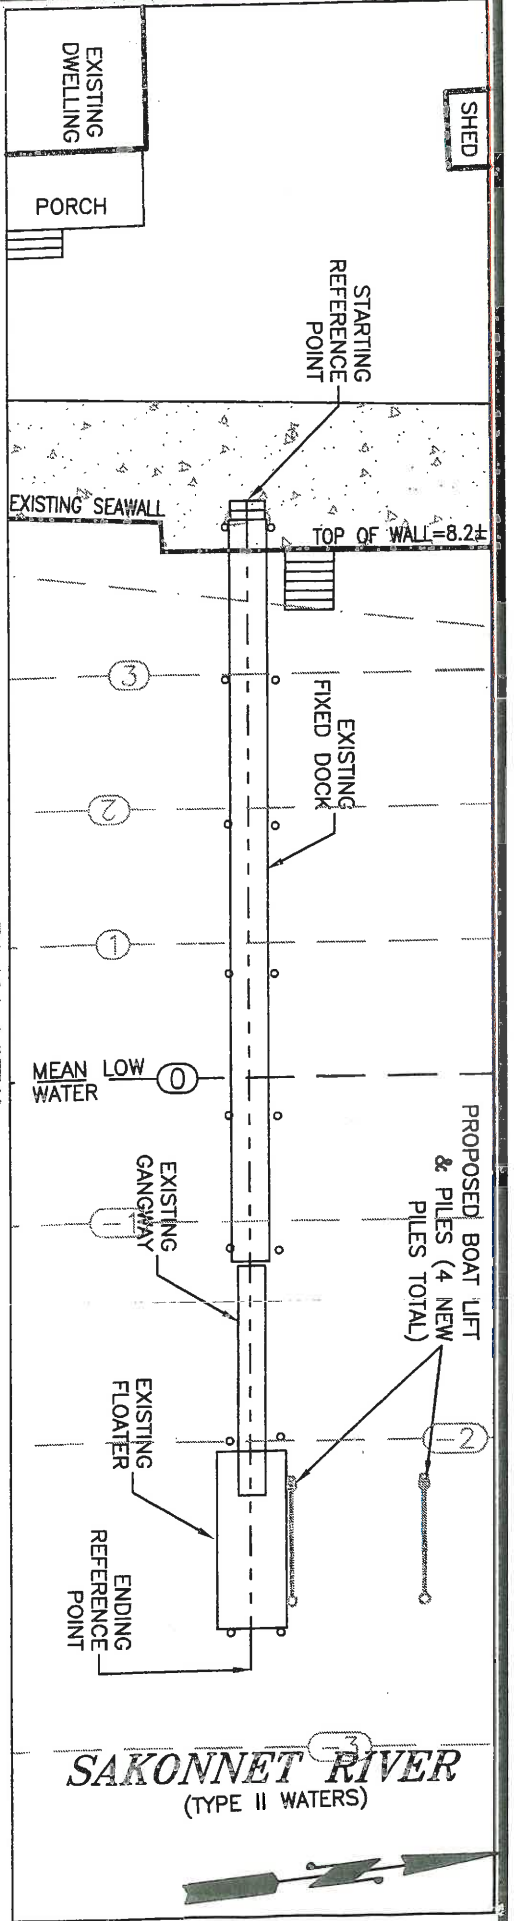

**PLAN VIEW**  
SCALE: 1" = 20'

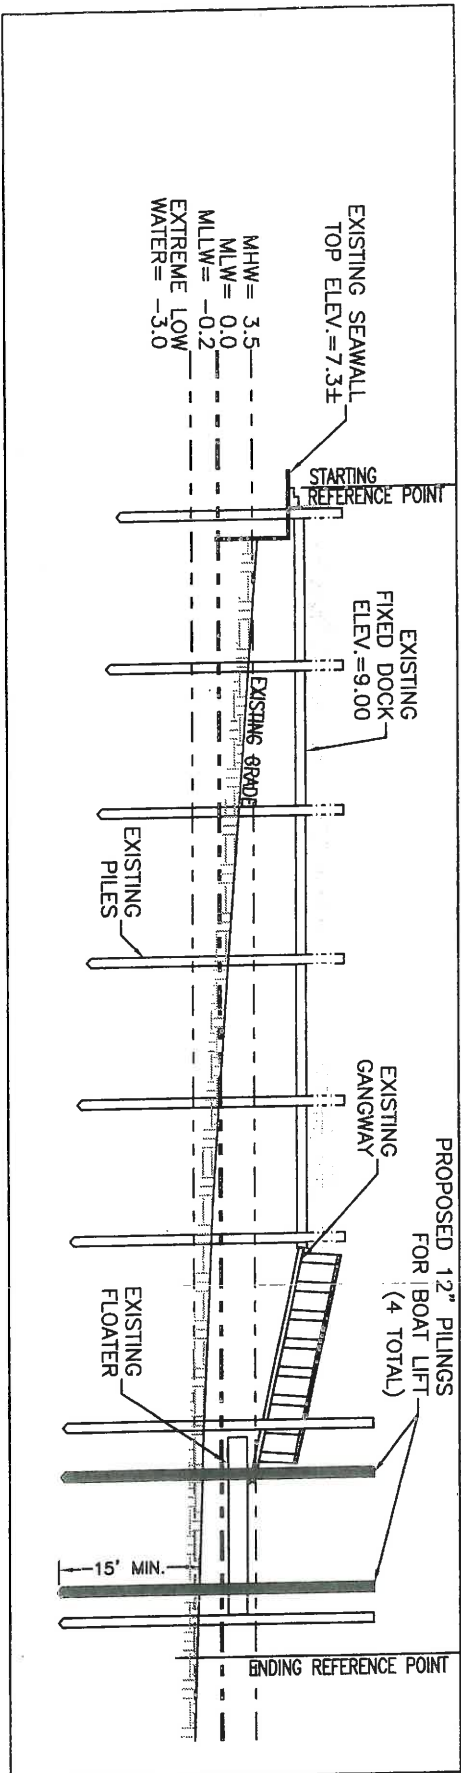

**PROFILE VIEW**  
SCALE: 1" = 20'

SHEET 5 OF 6

PURPOSE: CONSTRUCTION OF  
BOAT LIFT TO EXISTING DOCK  
IN: SAKONNET RIVER, PORTSMOUTH, RI  
29 ATLANTIC AVE, PORTSMOUTH

DATE: ~~NOV 07 2018~~  
NOV 07 2018  
DRAWN BY: ~~MEW~~  
MEW EDO.0

REVISIONS:  
CORRECTED PER PERMITS  
DATE: 11/09/2018  
BY: JSC

# PROFILE VIEW

APPLICATION BY:  
ARNOLD DESENNIA  
4 ELLIS STREET  
SEEKONK, MA 02771

BY: MOUNT HOPE ENGINEERING, INC.  
1788 G.A.R. HIGHWAY  
SWANSEA, MA. 02777


TODD CLARKIN

No. *Todd Clarkin*  
REGISTERED  
PROFESSIONAL ENGINEER

REGISTERED  
PROFESSIONAL ENGINEER


PURPOSE: CONSTRUCTION OF  
 BOAT LIFT TO EXISTING DOCK  
 IN: SAKONNET RIVER, PORTSMOUTH, RI  
 29 ATLANTIC AVE, PORTSMOUTH

DATE: 08/08/14  
 REVISION: 1  
 COASTAL RESOURCE CONSULTANTS  
 1772988  
 NOV 07 2014  
 RECEIVED  
 PORTSMOUTH, RI  
 REVISIONS: 1  
 MANAGEMENT COUNCIL

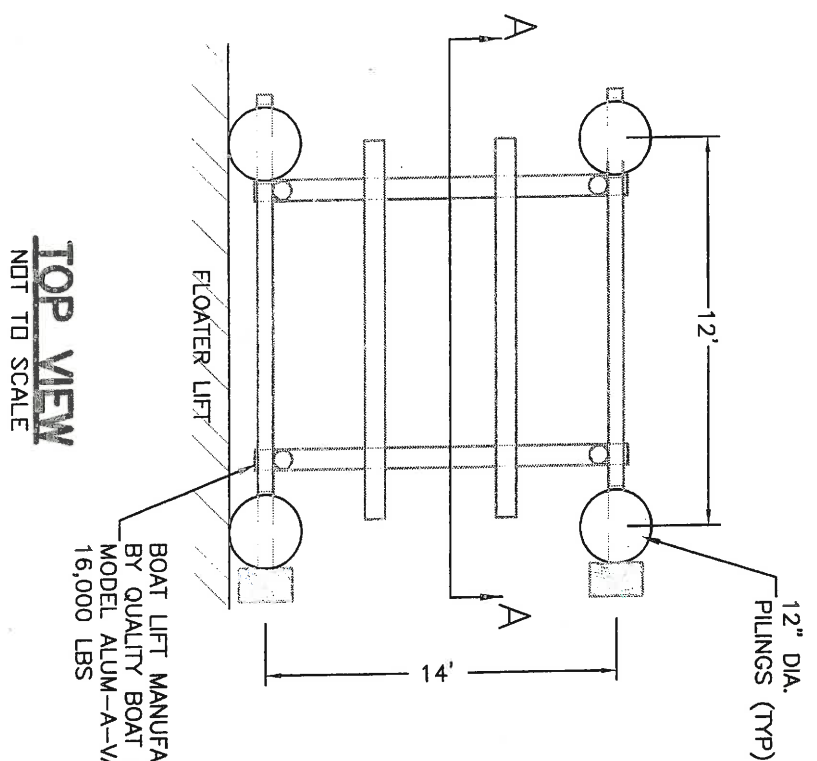

**TOP VIEW**  
 NOT TO SCALE

BOAT LIFT MANUFACTURED  
 BY QUALITY BOAT LIFTS,  
 MODEL ALUM-A-VATOR 4  
 16,000 LBS

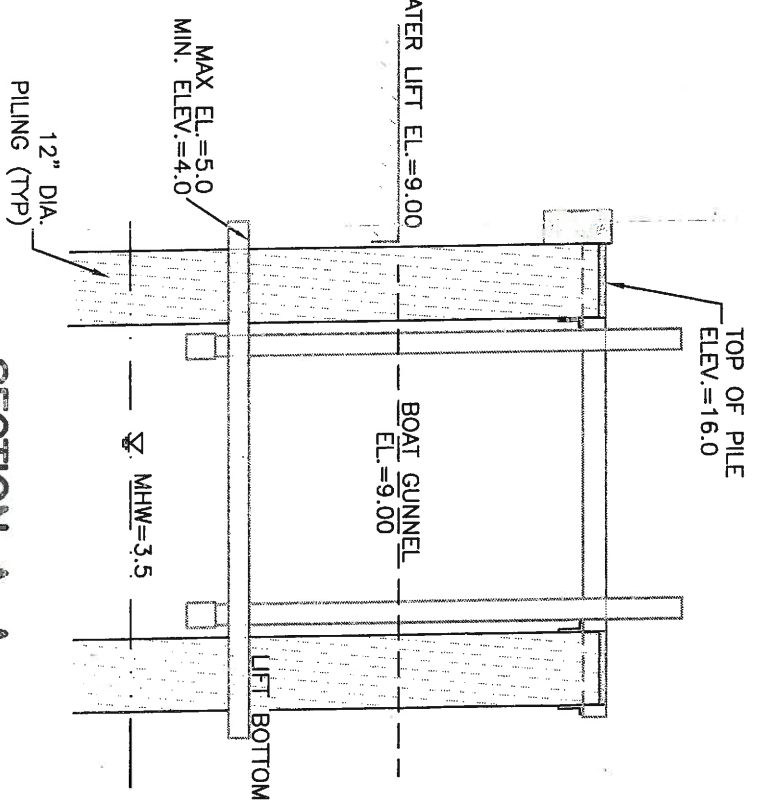

**SECTION A-A**  
 NOT TO SCALE

# BOAT LIFT DETAILS

APPLICATION BY:  
 ARNOLD DeSENNA  
 4 ELLIS STREET  
 SEEKONK, MA 02771

BY: MOUNT HOPE ENGINEERING, INC.  
 1788 G.A.R. HIGHWAY  
 SWANSEA, MA. 02777

REGISTERED PROFESSIONAL ENGINEER  
 M. J. [Signature]  
 02777