



State of Rhode Island
Coastal Resources Management Council
 Oliver H. Stedman Government Center
 4808 Tower Hill Road, Suite 3
 Wakefield, RI 02879-1900

(401) 783-3370
 Fax (401) 783-2069

PUBLIC NOTICE

File Number: 2021-09-096 Date: October 20, 2021

This office has under consideration the application of:

Peter Flood
400 East Shore Road
Jamestown, RI 02835

For a State of Rhode Island Assent to:

Construct and maintain a 1200 pound boat lift at the landward end of the existing approved L-shaped fixed pier dock.


Project Location:	400 East Shore Road
City/Town:	Jamestown
Plat/Lot:	4 / 11
Waterway:	Narragansett bay- east passage

Plans of the proposed work may be seen at the CRMC office in Wakefield.

In accordance with the Administrative Procedures Act (Chapter 42-35 of the Rhode Island General Laws) you may request a hearing on this matter.

You are advised that if you have good reason to enter protests against the proposed work it is your privilege to do so. It is expected that objectors will review the application and plans thoroughly, visit site of proposed work if necessary, to familiarize themselves with the conditions and cite what law or laws, if any, would in their opinion be violated by the work proposed.

If you desire to protest, you must attend the scheduled hearing and give sworn testimony. A notice of the time and place of such hearing will be furnished you as soon as possible after receipt of your request for hearing. If you desire to request a hearing, to receive consideration, it should be in writing (**with your correct mailing address, e-mail address and valid contact number**) and be received at this office on or before November 20, 2021.

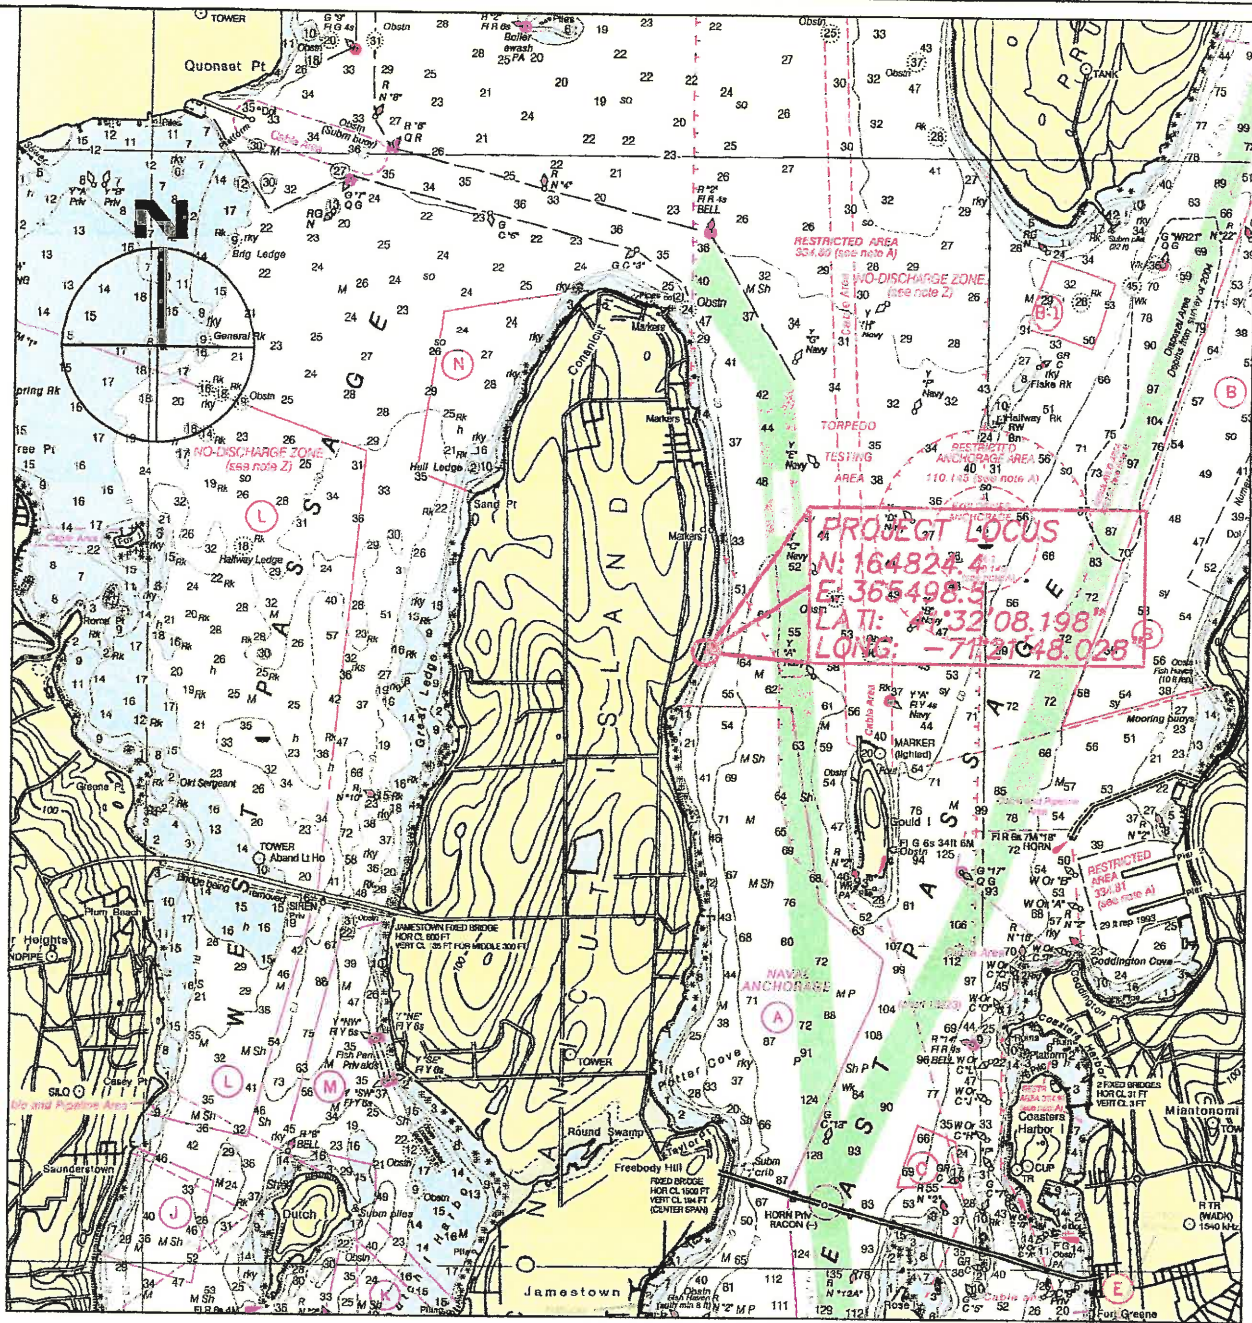


LOCUS PLAN
 PORTION OF NOAA
 13221

PROPOSED 1200# BOATLIFT FOR:
 PETER FLOOD, TRUSTEE
 400 EAST SHORE ROAD
 AP 4, LOT 11
 JAMESTOWN, RI 02835
 BY: WARREN HALL, CIVIL ENGINEER
 SHEET 1 OF 4 SEPTEMBER 21, 2021






Scale 1" = 60'

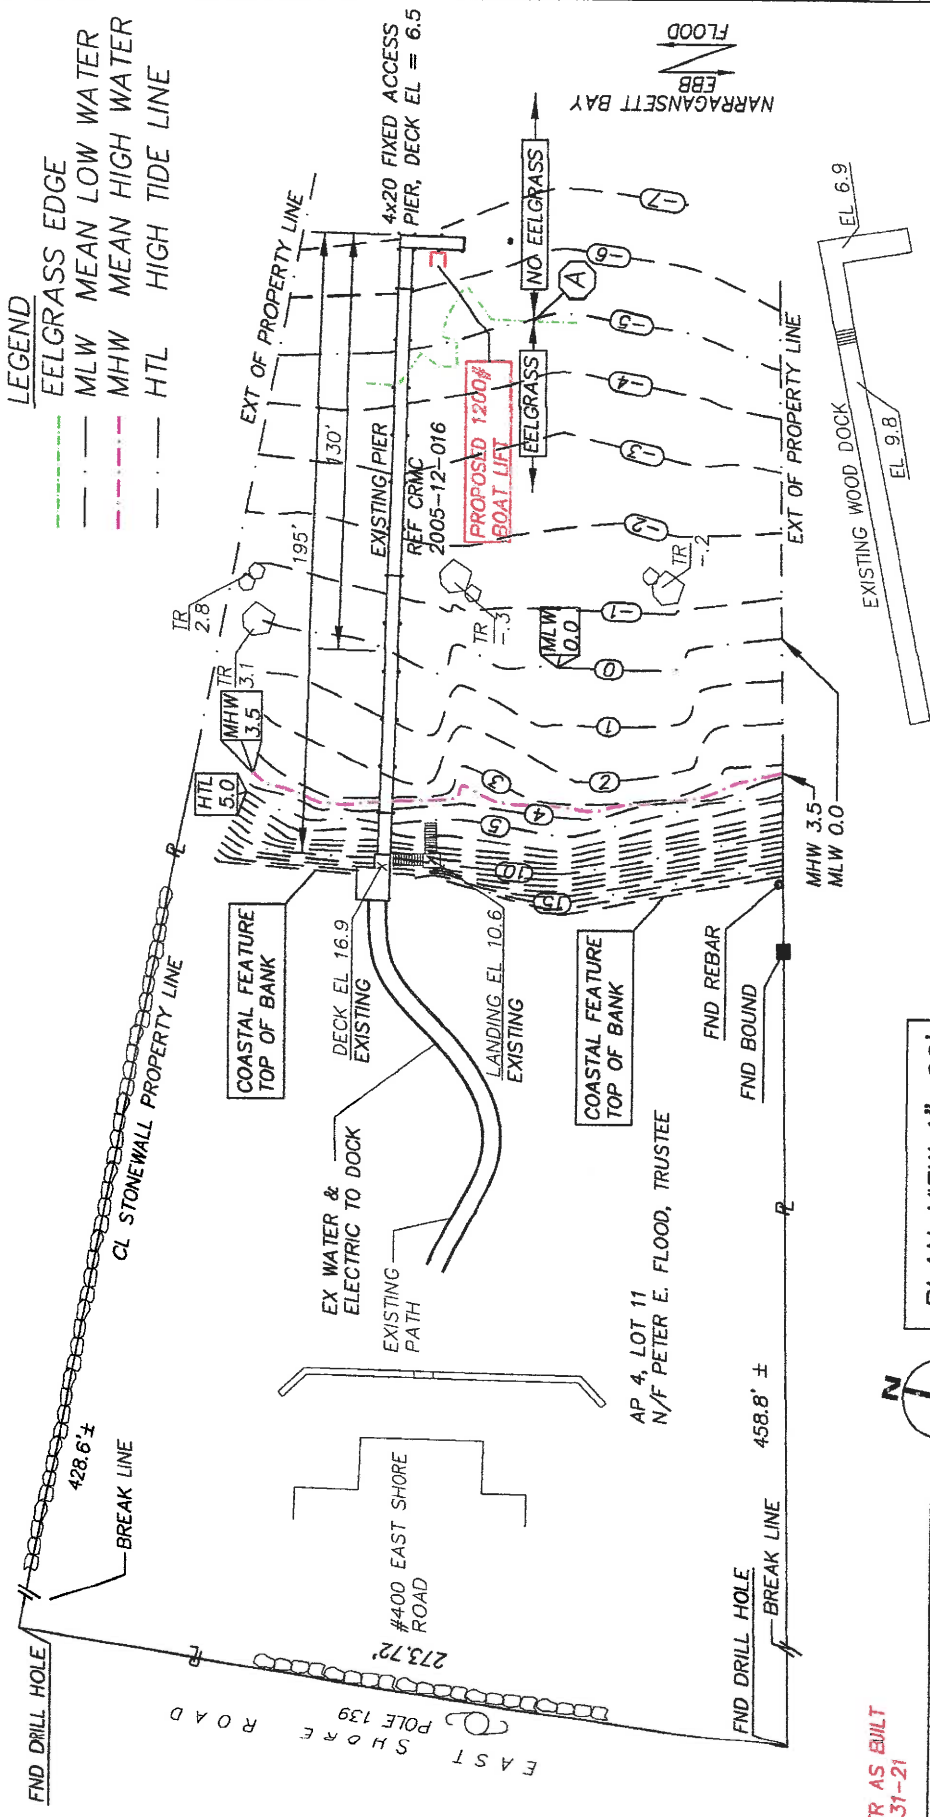

- LEGEND**
- EELGRASS EDGE
 - MLW MEAN LOW WATER
 - MHW MEAN HIGH WATER
 - HTL HIGH TIDE LINE

PIER AS BUILT
7-31-21

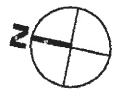


PLAN VIEW 1"=60'

PROPOSED 1200# BOATLIFT FOR:
 PETER FLOOD, TRUSTEE
 400 EAST SHORE ROAD
 AP 4, LOT 11
 JAMESTOWN, RI 02835
 BY: WARREN HALL, CIVIL ENGINEER
 SHEET 2 OF 4 SEPTEMBER 21, 2021

REFERENCE SAV SURVEY BY NATURAL
 RESOURCE SERVICES, INC., PREPARED
 SEPTEMBER 9, 2021


WARREN HALL
 REGISTERED PROFESSIONAL ENGINEER
 (Signature)

(A) REFERENCE SAV SURVEY BY NATURAL RESOURCE SERVICES, INC., PREPARED SEPTEMBER 9, 2021

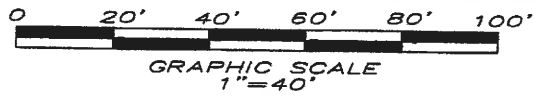

LEGEND


- - - EELGRASS EDGE
- - - MLW MEAN LOW WATER
- - - MHW MEAN HIGH WATER
- - - HTL HIGH TIDE LINE

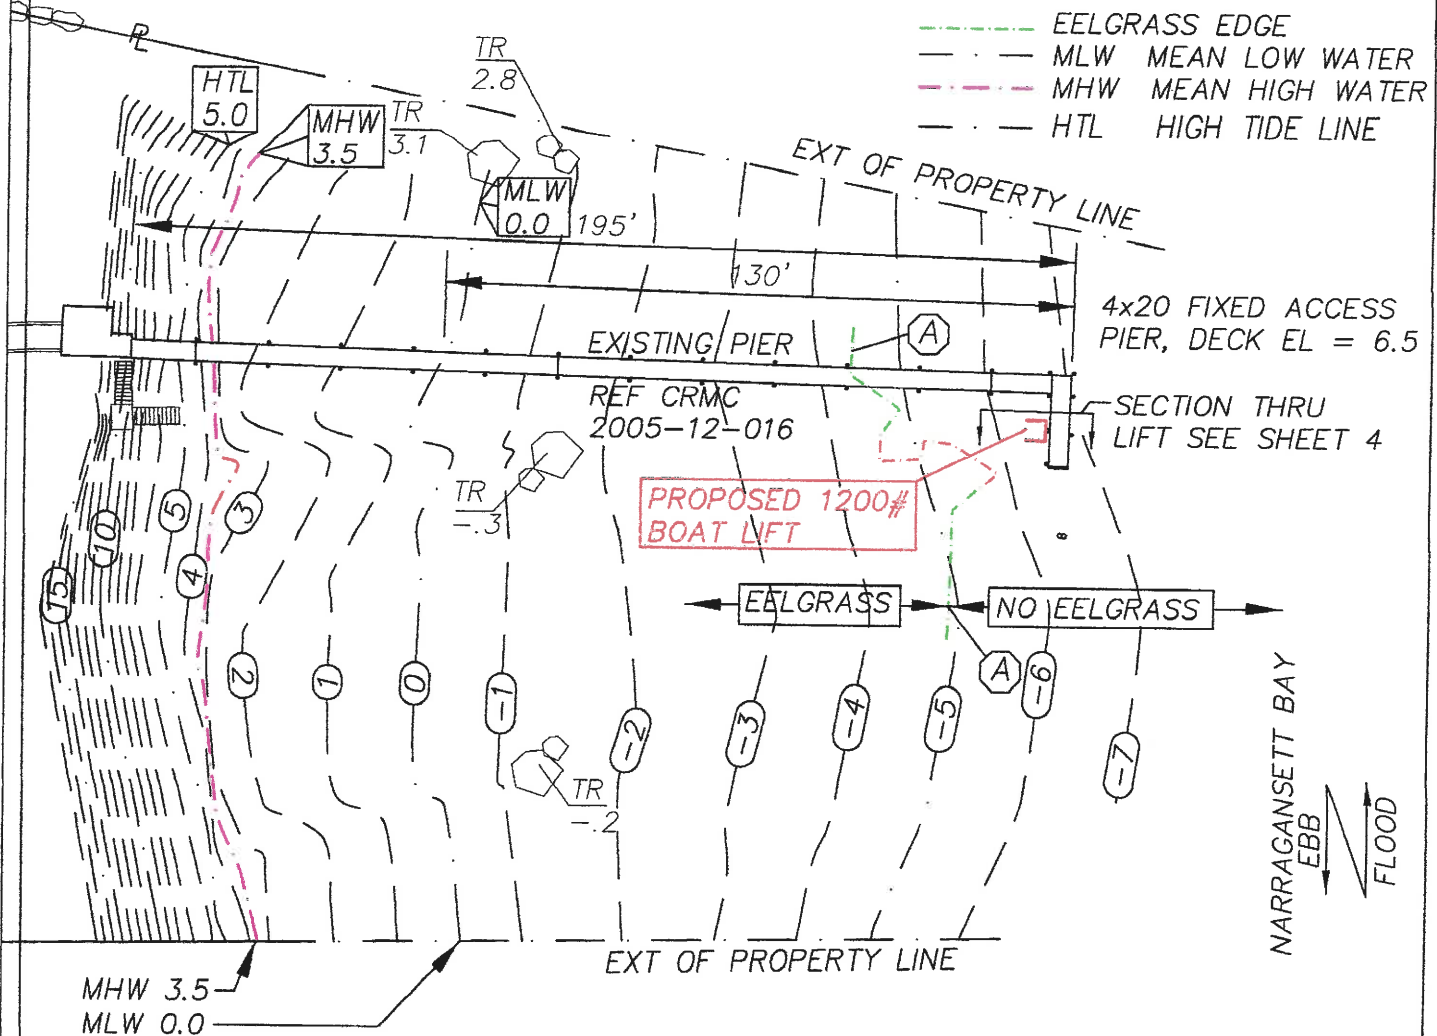


PLAN VIEW
1"=40'

PIER AS BUILT
7-31-21

PROPOSED 1200# BOATLIFT FOR:
 PETER FLOOD, TRUSTEE
 400 EAST SHORE ROAD
 AP 4, LOT 11
 JAMESTOWN, RI 02835
 BY: WARREN HALL, CIVIL ENGINEER
 SHEET 3 OF 4 SEPTEMBER 21, 2021

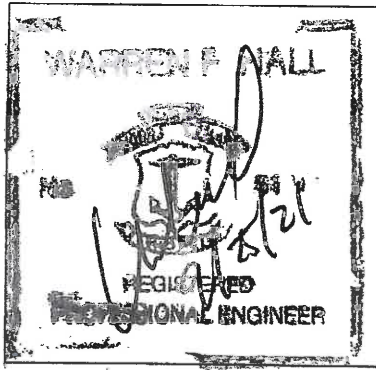

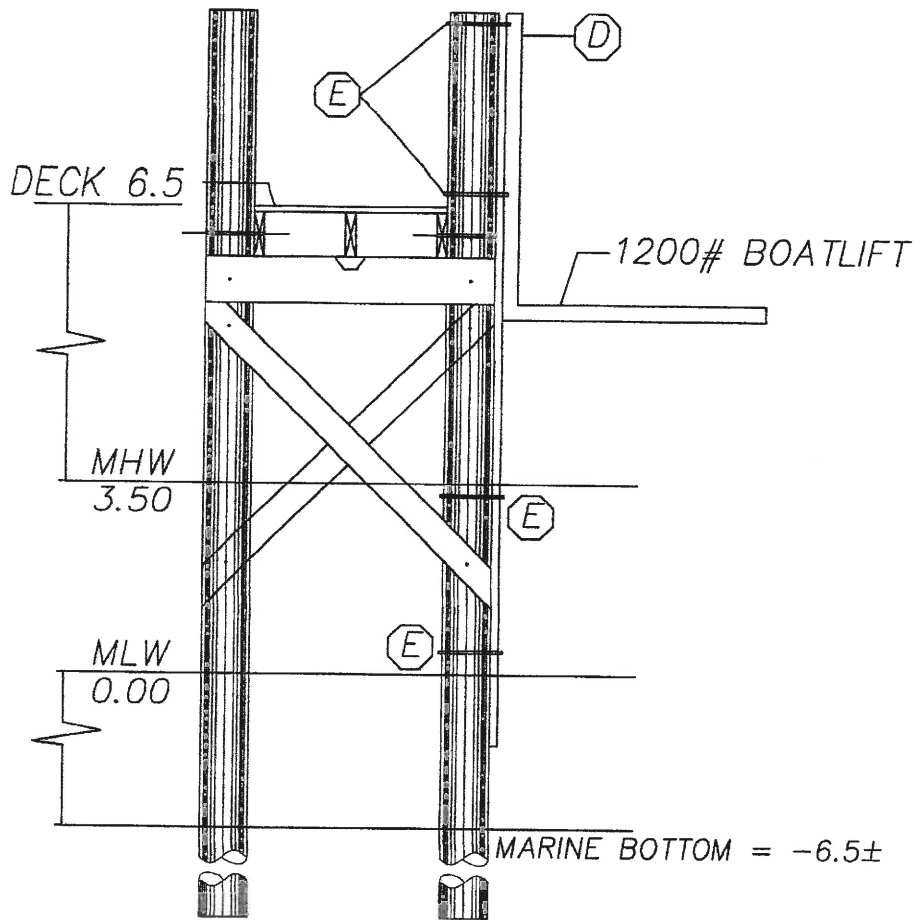

SECTION THRU BOATLIFT

- ⓓ SET STOPS TO PREVENT GUNWALE OF BOAT TO BE ABOVE DECK EL OF 6.5 WHILE IN RAISED POSITION
- ⓔ ATTACH GUIDERAIL IN ACCORDANCE WITH MANUF. RECOMMENDATIONS

GENERAL NOTES:

- 1) ALL BOLTS, CONNECTORS, WASHERS, NAILS, ECT SHALL BE HOT DIPPED GALVANIZED
- 2) CONTRACTOR SHALL ADHERE TO ALL OSHA RULES AND REGULATIONS THROUGHOUT ALL PHASES OF CONSTRUCTION
- 3) CONTRACTOR SHALL BE AWARE THAT THE STRATA INTO WHICH THESE PILES ARE TO BE DRIVEN MAY REQUIRE DRILLING TO ENSURE A MINIMUM 10' PENETRATION BELOW EXISTING GRADE

PROPOSED 1200# BOATLIFT FOR:
 PETER FLOOD, TRUSTEE
 400 EAST SHORE ROAD
 AP 4, LOT 11
 JAMESTOWN, RI 02835
 BY: WARREN HALL, CIVIL ENGINEER
 SHEET 4 OF 4 SEPTEMBER 21, 2021

