



State of Rhode Island
Coastal Resources Management Council
Oliver H. Stedman Government Center
4808 Tower Hill Road, Suite 3
Wakefield, RI 02879-1900

(401) 783-3370
Fax (401) 783-2069

NOTICE OF PUBLIC HEARING

CRMC File No.: 2023-04-094

Date: April 29, 2024

In accordance with and pursuant to the provisions of the "Administrative Procedures Act", (Chapter 42-35 et. seq. of the General Laws of Rhode Island), and the Rules and Regulations of the Coastal Resources Management Council, a hearing will be held on the petition of:

**Department of Transportation
Attn: Alisa Richardson
360 Lincoln Avenue
Warwick, RI 02888**


relative to Title 46, Chapter 23, of Section 6 A, B, C, D, E, Title 46 Chapter 23 Section 18(b), Title 46, Chapter 6, Section 1, Title 46, Chapter 6, Section 2 of the Rhode Island General Laws of 1956, as amended, for a State of Rhode Island Assent for: for a State of Rhode Island Assent to construct and maintain the Reconstruction of the East Bay Bike Path bridges over the Barrington River and Palmer River (RIC #2022-DB-012) including the installation of new piers, abutments, truss spans, riprap scour protection, and stormwater management. This project requires special exceptions to CRMP § 1.3.1(L)(3)(c) – alterations to coastal wetlands not designated for preservation adjacent to Type3 Waters § 1.3.1(M)(2)(a) – the construction of new public transportation facilities in tidal waters, § 1.3.1(G)(3)(c) – the filling on a coastal feature or tidal waters, and § 1.3.1(J)(3)(a) – filling in Type 2 waters Variances are required for (CRMP § 1.3.1(B)(3)(a)(6)), filling rather than cutting on causeway slopes and §1.3.1(B)(3)(e)(1)(AA)).filling on slopes steeper than 15 percent.***Public Notice Revision*** -- The most recent revised submission has proposed to locate the public fishing pier on the western side of the Barrington River instead of the previously proposed eastern side. The fishing pier is a public recreational facility consisting of a 20'x7' and 40'x11'4" fixed pier and a 24'x11'4" terminal T.

The hearing will be held at 6:00 p.m. on Tuesday, May 28, 2024, at the Administration Building, in Conference Room A, located at One Capitol Hill, Providence, RI.

Parties interested in/or concerned with the above-mentioned matter are invited to be present and/or represented by counsel at the above-mentioned time and place. This meeting place is accessible to individuals with disabilities. The meeting location is accessible to handicapped persons. Any individual requiring a reasonable accommodation in order to participate in this meeting should contact CRMC offices at 401-783-3370 at least 72 hours prior to the meeting.

Plans of the proposed work may be seen in the office of the Coastal Resources Management Council, Oliver H. Stedman Government Center, 4808 Tower Hill Road, Wakefield, Rhode Island, between the hours of 8:30 a.m. and 3:30 p.m., Monday through Friday.

Oral statements will be heard and recorded, and statements may be submitted to the hearing officers at the time of hearing.

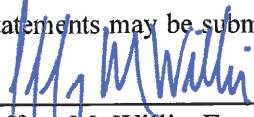

Jeffrey M. Willis, Executive Director 04-29-2024
Coastal Resources Management Council

CRMC Mailing List for **Department of Transportation**
CRMC File Number **2023-04-094**
Semimonthly Meeting - Public Hearing – Special Exception

Department of Transportation Attn: Alisa Richardson 360 Lincoln Avenue Warwick, RI 02888 Alisa.Richardson@dot.ri.gov Erik.Johnston@dot.ri.gov David.Walsh@dot.ri.gov	CRMC (2023-04-094) O. S. Government Center 4808 Tower Hill Road Wakefield, RI 02879 LTurner@crmc.ri.gov ASilva@crmc.ri.gov RSinger@crmc.ri.gov
RIDEM/ Technical & Customer Asst. 235 Promenade Street Providence, RI 02908-5767	Grace M. Anderson 23 Surrey Road Barrington, RI 02806
Town of Barrington (See Barrington Email List) 283 County Road Barrington, RI 02806 Brian Hunt, Harbormaster BHunt@barrington.ri.gov	Christopher & Kerin Lowe 14 New Meadow Road Barrington, RI 02806 ChrisPLowe@gmail.com
Stephen L. & Jane A. Mainella 81 County Road Barrington, RI 02806 mainellaj@gmail.com	Warren German American Club 27 Kelly Street Warren, RI 02885
Town of Warren (See Email List) 514 Main Street Warren, RI 02885	Scott Hobson VHB shobson@vhb.com
RI Salt Water Anglers Association Scott Travers travers@risaa.org	Richard Hittinger hittinger@risaa.org
Christopher D'Ovidio 225 Dyer Street, 2 nd Floor Providence, RI 02903 chris@dovidiolaw.com	Michael Woods Rhodelsland@backcountryhunters.org Brian Bird Bird@backcountryhunters.org Chris Borgatti Borgatti@backcountryhunters.org
Adam Rojek Arojek1212@gmail.com Alex Brown, Al.brownman@gmail.com Howard Dooley, Howard.Dooley@gmail.com	Nelson L. Hawkins, Jr. Barrington Harbor Commission Nelson.hawkins.jr@wellsfargoadvisors.com Ben Carlson carlsonb21@icloud.com
The Sukheila Family amelhusseini@gmail.com	Caroline Contrata – ccontrata@gmail.com Bill Laird bl52752@gmail.com William Hayes WHayesRI@gmail.com
William Jacobson wjacob7991@aol.com William Hitchcock w.tim.hitchcock@gmail.com Thomas Horn th.4000@icloud.com Geoffrey McNally jeff_ri@cox.net	Town E-List – Barrington and Warren

Lisa Turner

From: Lisa Turner <lturner@crmc.ri.gov>
Sent: Monday, April 29, 2024 2:39 PM
To: 'Andres Aveledo'; 'asilva@crmc.ri.gov'; 'Hamid (DOT)'; 'Prezioso, Andrew'
Cc: 'shobson@vhb.com'; 'Amy L Silva'; 'Ross Singer'
Subject: CRMC File 2023-04-094 RIDOT EBBP-Barrington Warren - Rescheduling Notice/Public Notice
Attachments: ProJo Letter for Pub Hearing 05-28-2024.pdf; RIDOT Pub Hrg Notice 05-28-2024 mtg for ProJo.pdf

Good Afternoon All: Please see the attached letter and Public Hearing Notice. Please post in the Providence Journal by next week for proper notification.

Cordially,
Lisa Turner

Lisa A. Turner, Office Manager and Record Keeper
Programming Services Officer
Coastal Resources Management Council
Oliver Stedman Government Center
4808 Tower Hill Road; Room 116
Wakefield, RI 02879
401-783-3370

From: Andres Aveledo <aaveledo@aetnabridge.com>
Sent: Monday, April 29, 2024 12:43 PM
To: asilva@crmc.ri.gov; 'Hamid (DOT)' <Hamid.Akinfolarin@dot.ri.gov>; 'Prezioso, Andrew' <APrezioso@VHB.com>
Cc: shobson@vhb.com; Lisa Turner <lturner@crmc.ri.gov>
Subject: RE: CRMC File 2023-04-094 RIDOT EBBP-Barrington Warren - Rescheduling Notice/Public Notice

Hi Lisa –

We did not yet post the notice you sent to us on 4/9 in the Providence Journal. The question now is whether we can revise the “notice of public hearing” to reflect the new hearing date and proper location of the fishing pier, or if we should instead publish the original notice of public hearing and subsequent revisions sent to us on 4/24.

Please let us know what you think.

Thanks,
Andres

From: asilva@crmc.ri.gov <asilva@crmc.ri.gov>
Sent: Monday, April 29, 2024 11:13 AM
To: Andres Aveledo <aaveledo@aetnabridge.com>; 'Hamid (DOT)' <Hamid.Akinfolarin@dot.ri.gov>; 'Prezioso, Andrew' <APrezioso@VHB.com>
Cc: shobson@vhb.com; Lisa Turner <lturner@crmc.ri.gov>
Subject: RE: CRMC File 2023-04-094 RIDOT EBBP-Barrington Warren - Rescheduling Notice/Public Notice

Andres, the two attachments in my email should be what you need. One is the meeting notice for May 28, and the other is the revised public notice for the relocated timber pier.

I've forwarded this to Lisa Turner, our office manager if its not.

-Amy

Amy Silva
Supervising Environmental Scientist, CRMC
(401)-783-3370p / (401)-783-2069f
<http://www.crmc.ri.gov>

From: Andres Aveledo <aaveledo@aetnabridge.com>
Sent: Monday, April 29, 2024 10:40 AM
To: asilva@crmc.ri.gov; 'Hamid (DOT)' <Hamid.Akinfolarin@dot.ri.gov>; 'Prezioso, Andrew' <APrezioso@VHB.com>
Cc: shobson@vhb.com
Subject: RE: CRMC File 2023-04-094 RIDOT EBBP-Barrington Warren - Rescheduling Notice/Public Notice

Hi Amy – thanks for following up on this. I was going to bring this up as we got closer to the 20-day cutoff, I was assuming that CRMC would be providing us with an updated Notice of Public Hearing for posting in the ProJo since the language marked “Continued” in the email provided to us on the 24th still indicates that the proposed fishing pier is on the eastern side of the Barrington River. To be clear, we held off on posting the notice sent to us on 4/9 since we knew we would be making changes to the fishing pier location. I’m not sure if you were aware of that.

Since it has not yet been posted in the ProJo I was thinking that it would cleanest to simply modify the Notice of Public Hearing to include the May 28th hearing date as well as stating that the proposed pier is on the western side.

However, if we need to post the old notice as well as all the public notice revision provided to us on the 24th we can do that. Let us know what you think.

Andres

From: asilva@crmc.ri.gov <asilva@crmc.ri.gov>
Sent: Monday, April 29, 2024 10:25 AM
To: 'Hamid (DOT)' <Hamid.Akinfolarin@dot.ri.gov>; 'Prezioso, Andrew' <APrezioso@VHB.com>; Andres Aveledo <aaveledo@aetnabridge.com>
Subject: FW: CRMC File 2023-04-094 RIDOT EBBP-Barrington Warren - Rescheduling Notice/Public Notice

Hamid- the email with the notice went out last week. See attached/email from 4/24.

Amyy

Amy Silva
Supervising Environmental Scientist, CRMC
(401)-783-3370p / (401)-783-2069f
<http://www.crmc.ri.gov>

From: Lisa Turner <ltturner@crmc.ri.gov>
Sent: Wednesday, April 24, 2024 11:46 AM
To: 'Richardson, Alisa (DOT)' <Alisa.Richardson@dot.ri.gov>; 'Erik Johnstone' <erik.johnstone@dot.ri.gov>; 'Akinfolarin, Hamid (DOT)' <Hamid.Akinfolarin@dot.ri.gov>; 'Pompei, Anthony (DOT)' <anthony.pompei@dot.ri.gov>

Cc: Scott Hobson <shobson@vhb.com>; Aprezioso@vhb.com; 'Amy L Silva' <asilva@crmc.ri.gov>; 'Ross Singer' <rsinger@crmc.ri.gov>; 'Lisa Turner' <lturner@crmc.ri.gov>

Subject: CRMC File 2023-04-094 RIDOT EBBP-Barrington Warren - Rescheduling Notice/Public Notice

Good Morning All: Please see the attached CRMC Notices one of which is a CRMC Semimonthly meeting Rescheduling notice from Tuesday, May 14, 2024 to Tuesday, May 28, 2024. The Public Notice is for recent revisions to plans. Please feel free to contact CRMC if you have any questions.

Thank you,

Lisa Turner

Lisa A. Turner, Office Manager and
Programming Svcs Officer
Coastal Resources Management Council
Oliver Stedman Government Center
4808 Tower Hill Road; Room 116
Wakefield, RI 02879
401-783-3370



Virus-free www.avg.com



State of Rhode Island
Coastal Resources Management Council
Oliver H. Stedman Government Center
4808 Tower Hill Road, Suite 116
Wakefield, RI 02879-1900

(401) 783-3370
Fax (401) 783-3767

April 29, 2024

Department of Transportation
Attn: Alisa Richardson
360 Lincoln Avenue
Warwick, RI 02888

File Number: 2023-04-094
Site Address: East Bay Bike Path Bridges, Barrington River and Palmer River
Towns of Barrington and Warren

Dear Ms. Richardson:

Enclosed is the Public Hearing Notice for the above referenced CRMC File.

Please be advised that the enclosed Public Hearing notice for Special Exception must be advertised in the Providence Journal Bulletin at least 20 days prior to the hearing which is May 28, 2024.

Please provide us with a copy of the Advertisement article with the date intact. (See 4.3.4 of the RI CRMC Management Procedures).

Please call 783-3370 if you have any questions.

Sincerely,

Lisa A. Turner

Lisa A. Turner, Office Manager
Coastal Resources Management Council

/lat



State of Rhode Island
Coastal Resources Management Council
Oliver H. Stedman Government Center
4808 Tower Hill Road, Suite 3
Wakefield, RI 02879-1900

(401) 783-3370
Fax (401) 783-2069

NOTICE OF PUBLIC HEARING

CRMC File No.: 2023-04-094

Date: April 29, 2024

In accordance with and pursuant to the provisions of the "Administrative Procedures Act", (Chapter 42-35 et. seq. of the General Laws of Rhode Island), and the Rules and Regulations of the Coastal Resources Management Council, a hearing will be held on the petition of:

Department of Transportation
Attn: Alisa Richardson
360 Lincoln Avenue
Warwick, RI 02888


relative to Title 46, Chapter 23, of Section 6 A, B, C, D, E, Title 46 Chapter 23 Section 18(b), Title 46, Chapter 6, Section 1, Title 46, Chapter 6, Section 2 of the Rhode Island General Laws of 1956, as amended, for a State of Rhode Island Assent for: for a State of Rhode Island Assent to construct and maintain the Reconstruction of the East Bay Bike Path bridges over the Barrington River and Palmer River (RIC #2022-DB-012) including the installation of new piers, abutments, truss spans, riprap scour protection, and stormwater management. This project requires special exceptions to CRMP § 1.3.1(L)(3)(c) – alterations to coastal wetlands not designated for preservation adjacent to Type3 Waters § 1.3.1(M)(2)(a) – the construction of new public transportation facilities in tidal waters, § 1.3.1(G)(3)(c) – the filling on a coastal feature or tidal waters, and § 1.3.1(J)(3)(a) – filling in Type 2 waters Variances are required for (CRMP § 1.3.1(B)(3)(a)(6)), filling rather than cutting on causeway slopes and §1.3.1(B)(3)(e)(1)(AA)).filling on slopes steeper than 15 percent. ***Public Notice Revision*** -- The most recent revised submission has proposed to locate the public fishing pier on the western side of the Barrington River instead of the previously proposed eastern side. The fishing pier is a public recreational facility consisting of a 20'x7' and 40'x11'4" fixed pier and a 24'x11'4" terminal T.

The hearing will be held at 6:00 p.m. on Tuesday, May 28, 2024, at the Administration Building, in Conference Room A, located at One Capitol Hill, Providence, RI.

Parties interested in/or concerned with the above-mentioned matter are invited to be present and/or represented by counsel at the above-mentioned time and place. This meeting place is accessible to individuals with disabilities. The meeting location is accessible to handicapped persons. Any individual requiring a reasonable accommodation in order to participate in this meeting should contact CRMC offices at 401-783-3370 at least 72 hours prior to the meeting.

Plans of the proposed work may be seen in the office of the Coastal Resources Management Council, Oliver H. Stedman Government Center, 4808 Tower Hill Road, Wakefield, Rhode Island, between the hours of 8:30 a.m. and 3:30 p.m., Monday through Friday.

Oral statements will be heard and recorded, and statements may be submitted to the hearing officers at the time of hearing.

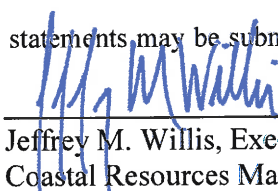

Jeffrey M. Willis, Executive Director 04-29-2024
Coastal Resources Management Council



State of Rhode Island
Coastal Resources Management Council
Oliver H. Stedman Government Center
4808 Tower Hill Road, Suite 3
Wakefield, RI 02879-1900

(401) 783-3370
Fax (401) 783-3767

RESCHEDULING NOTICE

April 23, 2024

Site Address: East Bay Bike Path Bridges
Site Town: Barrington
Proj. Desc: Reconstruction of the East Bay Bike Path bridges over the Barrington River and Palmer River

The application for State Assent of **Department of Transportation** CRMC File Number 2023-04-094 will **Not** be reviewed at the Tuesday, May 14th, 2024 meeting of the Coastal Resources Management Council as was scheduled via CRMC Public Hearing Notice dated April 9, 2024. Please see the enclosed Public Notice for project revisions.

This application has been **rescheduled** for review before the Council on **Tuesday, May 28th, 2024** at 6:00 p.m. in Conference Room A of the Administration Building, One Capitol Hill, Providence, RI.

Individuals requesting interpreter services for the hearing impaired must notify the Council office at 783-3370 at least 72 hours in advance of the hearing date.

Sincerely yours,

Lisa A. Turner

Lisa A. Turner, Office Manager
Coastal Resources Management Council

/lat



State of Rhode Island
Coastal Resources Management Council
Oliver H. Stedman Government Center
4808 Tower Hill Road, Suite 3
Wakefield, RI 02879-1900

(401) 783-3370
Fax (401) 783-2069

NOTICE OF PUBLIC HEARING

CRMC File No.: **2023-04-094**

Date: **April 9, 2024**

In accordance with and pursuant to the provisions of the "Administrative Procedures Act", (Chapter 42-35 et. seq. of the General Laws of Rhode Island), and the Rules and Regulations of the Coastal Resources Management Council, a hearing will be held on the petition of:

**Department of Transportation
Attn: Alisa Richardson
360 Lincoln Avenue
Warwick, RI 02888**

relative to Title 46, Chapter 23, of Section 6 A, B, C, D, E, Title 46 Chapter 23 Section 18(b), Title 46, Chapter 6, Section 1, Title 46, Chapter 6, Section 2 of the Rhode Island General Laws of 1956, as amended, for a State of Rhode Island Assent for: **Reconstruction of the East Bay Bike Path bridges over the Barrington River and Palmer River (RIC #2022-DB-012) including the installation of new piers, abutments, truss spans, riprap scour protection, and stormwater management.** The revised submission includes plans for fishing access and additional rip rap fill for scour protection. Fishing access consists of a permanent bulkhead on the western side of the Palmer River and a public fishing pier on the eastern side of the Barrington River. The fishing pier is a public recreational facility consisting of a 33'8"x11'4" fixed pier and 24'x11'4" terminal T. This project requires special exceptions to CRMP § 1.3.1(L)(3)(c) – alterations to coastal wetlands not designated for preservation adjacent to Type3 Waters § 1.3.1(M)(2)(a) – the construction of new public transportation facilities in tidal waters, § 1.3.1(G)(3)(c) – the filling on a coastal feature or tidal waters, and § 1.3.1(J)(3)(a) – filling in Type 2 waters Variances are required for (CRMP § 1.3.1(B)(3)(a)(6)), filling rather than cutting on causeway slopes and §1.3.1(B)(3)(e)(1)(AA)).filling on slopes steeper than 15 percent.

The hearing will be held at 6:00 p.m. on Tuesday, May 14, 2024, at the Administration Building, in Conference Room A, located at One Capitol Hill, Providence, RI.

Parties interested in/or concerned with the above-mentioned matter are invited to be present and/or represented by counsel at the above-mentioned time and place. This meeting place is accessible to individuals with disabilities. The meeting location is accessible to handicapped persons. Any individual requiring a reasonable accommodation in order to participate in this meeting should contact CRMC offices at 401-783-3370 at least 72 hours prior to the meeting.

Plans of the proposed work may be seen in the office of the Coastal Resources Management Council, Oliver H. Stedman Government Center, 4808 Tower Hill Road, Wakefield, Rhode Island, between the hours of 8:30 a.m. and 3:30 p.m., Monday through Friday.

Oral statements will be heard and recorded, and statements may be submitted to the hearing officers at the time of hearing.

Signed this 9th day of April, 2024.

Jeffrey M. Willis, Executive Director
Coastal Resources Management Council



State of Rhode Island
Coastal Resources Management Council
Oliver H. Stedman Government Center
4808 Tower Hill Road, Suite 3
Wakefield, RI 02879-1900

(401) 783-3370
Fax (401) 783-2069

PUBLIC NOTICE

File Number: 2023-04-094

Date: April 23, 2024

This office has under consideration the application of:

**Department of Transportation
360 Lincoln Avenue
Warwick, RI 02888**

for a State of Rhode Island Assent to construct and maintain the Reconstruction of the East Bay Bike Path bridges over the Barrington River and Palmer River (RIC #2022-DB-012) including the installation of new piers, abutments, truss spans, riprap scour protection, and stormwater management. This project requires special exceptions to CRMP § 1.3.1(L)(3)(c) – alterations to coastal wetlands not designated for preservation adjacent to Type3 Waters § 1.3.1(M)(2)(a) – the construction of new public transportation facilities in tidal waters, § 1.3.1(G)(3)(c) – the filling on a coastal feature or tidal waters, and § 1.3.1(J)(3)(a) – filling in Type 2 waters Variances are required for (CRMP § 1.3.1(B)(3)(a)(6)), filling rather than cutting on causeway slopes and §1.3.1(B)(3)(e)(1)(AA).filling on slopes steeper than 15 percent.

Public Notice Revision

The most recent revised submission has proposed to locate the public fishing pier on the western side of the Barrington River instead of the previously proposed eastern side. The fishing pier is a public recreational facility consisting of a 20'x7' and 40'x11'4" fixed pier and a 24'x11'4" terminal T.

Project Location:	East Bay Bike Path Bridges	
Town:	Barrington and Warren	Waterway: Barrington River & Palmer River

Plans of the proposed work can be requested at Cstaff1@crmc.ri.gov.


In accordance with the Administrative Procedures Act (Chapter 42-35 of the Rhode Island General Laws) you may request a hearing on this matter.

You are advised that if you have good reason to enter protests against the proposed work it is your privilege to do so. It is expected that objectors will review the application and plans thoroughly, visit site of proposed work if necessary, to familiarize themselves with the conditions and cite what law or laws, if any, would in their opinion be violated by the work proposed.

If you desire to protest, you must attend the scheduled hearing and give sworn testimony. A notice of the time and place of such hearing will be furnished you as soon as possible after receipt of your request for hearing. If you desire to request a hearing, to receive consideration, it should be in writing (**with your correct mailing address, e-mail address and valid contact number**) and be received at this office on or before **May 23, 2024**. Please email your comments/hearing requests to: cstaff1@crmc.ri.gov; or mail via USPS to: Coastal Resources Management Council; O. S. Government Center, 4808 Tower Hill Road, Rm 116; Wakefield, RI 02879.

REV	DATE	BY	CHKD	APP'D	PROJECT NO.	SHEET NO.	TOTAL SHEETS
1	RI				2022	9	25

R-2

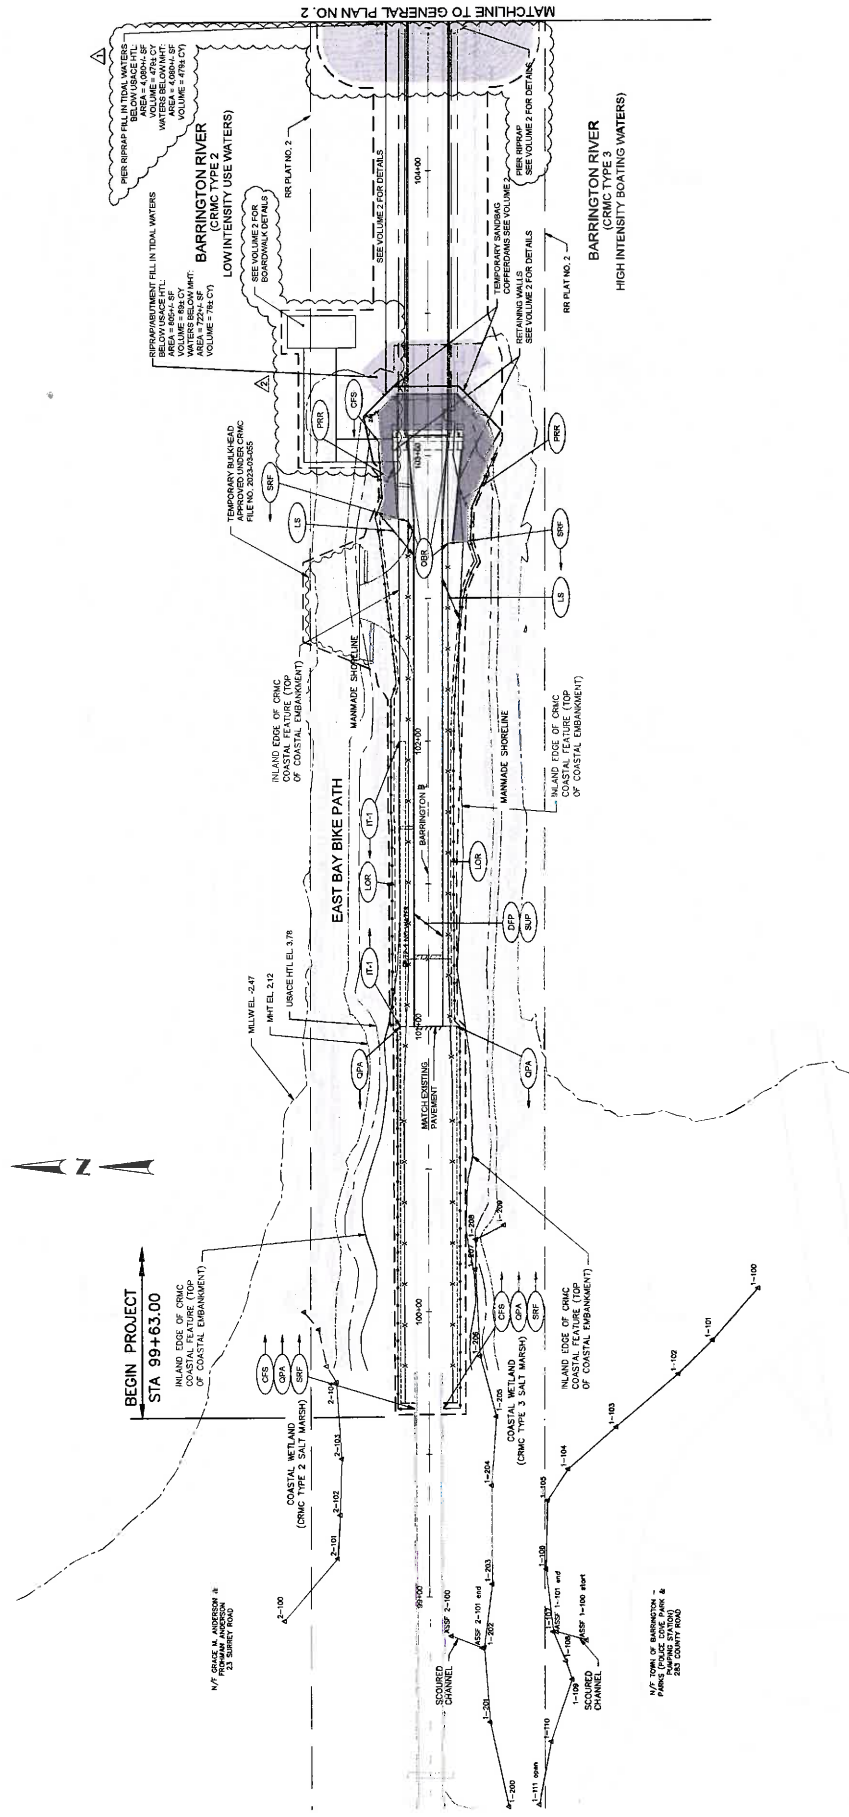

PROJECT
EAST BAY BIKE PATH BRIDGE REPLACEMENT
(BARRINGTON RIVER AND WARREN BRIDGES)

GENERAL PLAN NO. 1

RHODE ISLAND
DEPARTMENT OF TRANSPORTATION

SCALE: 1"=20'

DATE: 12/7/24

BY: [Signature]

CHKD: [Signature]

APP'D: [Signature]

PROJECT NO.: 2022-00-005


SHEET NO.: 9

TOTAL SHEETS: 25

RECEIVED
4/18/2024

REV	DATE	BY	CHKD	DESCRIPTION
1	RE	BR	06/30/2022	10 38

R-2

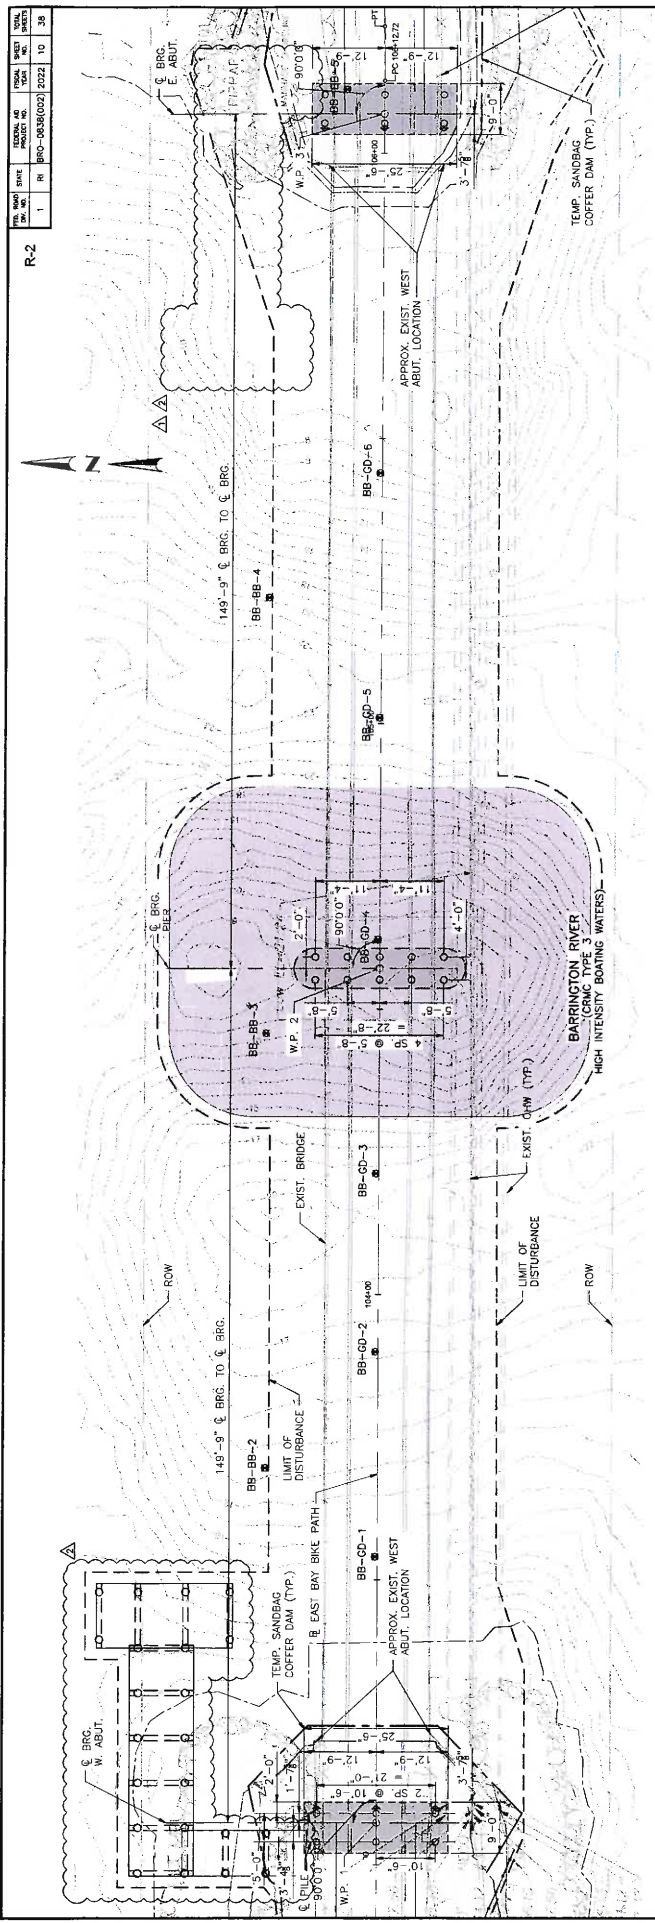

FOUNDATION PLAN
SCALE: 1"=10'

- LEGEND**
- PROPOSED FOUNDATION
 - PIER CAP
 - PROPOSED DRILLED MICROPILE (9.625" DIA.) (BATTERED 4:12)
 - PROPOSED DRILLED MICROPILE (9.625" DIA. AT ABUTMENT, 14" DIA. AT PIER) (VERTICAL)
 - PROPOSED DRILLED STEEL PIPE PILE AT FISHING PIER

EARLY RELEASE FOR
CONSTRUCTION
JUNE 2023

AT&T
Atisha Bridge Company

RI
CDOT

RHODE ISLAND
DEPARTMENT OF TRANSPORTATION

vhb
1 Cedar Street
Suite 400
Providence, RI 02903
801.272.8100

PROJECT
EAST BAY BIKE PATH BRIDGE REPLACEMENT
BARRINGTON RIVER AND WARREN BRIDGES

PERIOD
OCTOBER 2022
OCTOBER 2023

DESIGNED BY
vhb

DATE
10/1/2022

SCALE
1"=10'

REVISIONS

NO.	DATE	BY	NO.	DATE	BY
1	10/1/22	vhb	2	10/1/22	vhb

EAST BAY BIKE PATH BRIDGE REPLACEMENT
(BARRINGTON RIVER AND WARREN BRIDGES)

DESIGNED BY
vhb

DATE
10/1/2022

SCALE
1"=10'

RECEIVED
4/18/2024

CRMC Mailing List for Department of Transportation
CRMC File Number 2023-04-094

Department of Transportation Attn: Alisa Richardson 360 Lincoln Avenue Warwick, RI 02888 Alisa.Richardson@dot.ri.gov Erik.Johnston@dot.ri.gov Hamid.Akinfolarin@dot.ri.gov Anthony.pompei@dot.ri.gov	CRMC (2023-04-094) O. S. Government Center 4808 Tower Hill Road Wakefield, RI 02879 LTurner@crmc.ri.gov ASilva@crmc.ri.gov RSinger@crmc.ri.gov
RIDEM/ Technical & Customer Asst. 235 Promenade Street Providence, RI 02908-5767	Grace M. Anderson 23 Surrey Road Barrington, RI 02806
Town of Barrington 283 County Road Barrington, RI 02806	Christopher & Kerin Lowe 14 New Meadow Road Barrington, RI 02806
Warren German American Club 27 Kelly Street Warren, RI 02885	Scott Hobson, PWS, VHB - shobson@vhb.com Andrew Prezioso, PE, VHB aprezioso@vhb.com
Town of Warren 514 Main Street Warren, RI 02885	Howard Dooley Howard.dooley@gmail.com
RI Salt Water Anglers Association Scott Travers travers@risaa.org Richard Hittinger hittinger@risaa.org	Stephen and Jane Mainella 81 County Road; Barrington, RI 02806 mainellaj@gmail.com
Nicholas M. Toth Tothnm95@gmail.com	Alex Brown al.brownman@gmail.com
Adam Rojek arojek1212@gmail.com	Benjamin Carlson carlsonb21@icloud.com
William Hayes whayesri@gmail.com	Bill Laird bl52752@gmail.com
Tom Horn th.4000@icloud.com	Geoffrey McNally 84 Crest Road; Tiverton, RI 02878 jeff_ri@cox.net
William Hitchcock w.tim.hitchcock@gmail.com	A. Elhusseini amelhusseini@gmail.com
Brian Hunt BHunt@barrington.ri.gov Barrington Harbor Commission	Nelson Hawkins nelson.hawkins.jr@wellsfargoadvisors.com
Caroline Contrata ccontrata@gmail.com	William Jacobson wjacob7991@aol.com
M Woods NE Chapter Backcountry Hunters & Anglers rhodeisland@backcountryhunters.org	Chris D'Ovidio for Christopher Lowe chris@dovidiolaw.com chrisplowe@gmail.com
Town E-List – Barrington and Warren General E List	



State of Rhode Island
Coastal Resources Management Council
Oliver H. Stedman Government Center
4808 Tower Hill Road, Suite 3
Wakefield, RI 02879-1900

(401) 783-3370
Fax (401) 783-2069

NOTICE OF PUBLIC HEARING

CRMC File No.: 2023-04-094

Date: April 9, 2024

In accordance with and pursuant to the provisions of the "Administrative Procedures Act", (Chapter 42-35 et. seq. of the General Laws of Rhode Island), and the Rules and Regulations of the Coastal Resources Management Council, a hearing will be held on the petition of:

**Department of Transportation
Attn: Alisa Richardson
360 Lincoln Avenue
Warwick, RI 02888**

relative to Title 46, Chapter 23, of Section 6 A, B, C, D, E, Title 46 Chapter 23 Section 18(b), Title 46, Chapter 6, Section 1, Title 46, Chapter 6, Section 2 of the Rhode Island General Laws of 1956, as amended, for a State of Rhode Island Assent for: **Reconstruction of the East Bay Bike Path bridges over the Barrington River and Palmer River (RIC #2022-DB-012) including the installation of new piers, abutments, truss spans, riprap scour protection, and stormwater management. The revised submission includes plans for fishing access and additional rip rap fill for scour protection. Fishing access consists of a permanent bulkhead on the western side of the Palmer River and a public fishing pier on the eastern side of the Barrington River. The fishing pier is a public recreational facility consisting of a 33'8"x11'4" fixed pier and 24'x11'4" terminal T. This project requires special exceptions to CRMP § 1.3.1(L)(3)(c) – alterations to coastal wetlands not designated for preservation adjacent to Type3 Waters § 1.3.1(M)(2)(a) – the construction of new public transportation facilities in tidal waters, § 1.3.1(G)(3)(c) – the filling on a coastal feature or tidal waters, and § 1.3.1(J)(3)(a) – filling in Type 2 waters Variances are required for (CRMP § 1.3.1(B)(3)(a)(6)), filling rather than cutting on causeway slopes and §1.3.1(B)(3)(e)(1)(AA)).filling on slopes steeper than 15 percent.**


The hearing will be held at 6:00 p.m. on Tuesday, May 14, 2024, at the Administration Building, in Conference Room A, located at One Capitol Hill, Providence, RI.

Parties interested in/or concerned with the above-mentioned matter are invited to be present and/or represented by counsel at the above-mentioned time and place. This meeting place is accessible to individuals with disabilities. The meeting location is accessible to handicapped persons. Any individual requiring a reasonable accommodation in order to participate in this meeting should contact CRMC offices at 401-783-3370 at least 72 hours prior to the meeting.

Plans of the proposed work may be seen in the office of the Coastal Resources Management Council, Oliver H. Stedman Government Center, 4808 Tower Hill Road, Wakefield, Rhode Island, between the hours of 8:30 a.m. and 3:30 p.m., Monday through Friday.

Oral statements will be heard and recorded, and statements may be submitted to the hearing officers at the time of hearing.

Signed this 9th day of April, 2024.

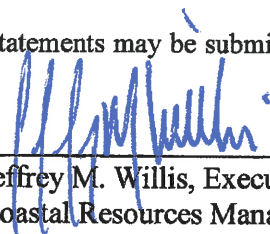

Jeffrey M. Willis, Executive Director
Coastal Resources Management Council

CRMC Mailing List for **Department of Transportation**
CRMC File Number **2023-04-094**
Semimonthly Meeting - Public Hearing – Special Exception

Department of Transportation Attn: Alisa Richardson 360 Lincoln Avenue Warwick, RI 02888 Alisa.Richardson@dot.ri.gov Erik.Johnston@dot.ri.gov ✓ David.Walsh@dot.ri.gov ✓	CRMC (2023-04-094) O. S. Government Center 4808 Tower Hill Road Wakefield, RI 02879 L.Turner@crmc.ri.gov ASilva@crmc.ri.gov ✓ RSinger@crmc.ri.gov ✓
RIDEM/ Technical & Customer Asst. 235 Promenade Street Providence, RI 02908-5767 <i>USPS</i> ✓	Grace M. Anderson <i>USPS</i> ✓ 23 Surrey Road Barrington, RI 02806
Town of Barrington 283 County Road Barrington, RI 02806 Brian Hunt, Harbormaster B.Hunt@barrington.ri.gov <i>Boat Email List</i>	Christopher & Kerin Lowe 14 New Meadow Road Barrington, RI 02806 ✓ ChrisPLowe@gmail.com
Stephen L. & Jane A. Mainella 81 County Road Barrington, RI 02806 ✓ mainellaj@gmail.com	Warren German American Club 27 Kelly Street Warren, RI 02885 ✓
Town of Warren 514 Main Street Warren, RI 02885 <i>Warren Email List</i>	Scott Hobson ✓ VHB shobson@vhb.com
RI Salt Water Anglers Association Scott Travers ✓ travers@risaa.org	Richard Hittinger ✓ hittinger@risaa.org
Christopher D'Ovidio 225 Dyer Street, 2 nd Floor Providence, RI 02903 ✓ chris@dovidiolaw.com	Michael Woods ✓ RhodeIsland@backcountryhunters.org Brian Bird Bird@backcountryhunters.org ✓ Chris Borgatti Borgatti@backcountryhunters.org ✓
Adam Rojek Arojek1212@gmail.com ✓ Alex Brown, Al.brownman@gmail.com ✓ Howard Dooley, Howard.Dooley@gmail.com ✓	Town E-List – Barrington and Warren General Mailing E-List
The Sukheila Family amelhusseini@gmail.com ✓ Caroline Contrata – ccontrata@gmail.com ✓ Bill Laird bl52752@gmail.com ✓ William Hayes WHayesRI@gmail.com ✓	Nelson L. Hawkins, Jr. ✓ Barrington Harbor Commission Nelson.hawkins.jr@wellsfargoadvisors.com Ben Carlson carlsonb21@icloud.com ✓
William Jacobson wjacob7991@aol.com ✓ William Hitchcock w.tim.hitchcock@gmail.com ✓ Thomas Horn th.4000@icloud.com ✓ Geoffrey McNally jeff_ri@cox.net ✓	



State of Rhode Island
Coastal Resources Management Council
Oliver H. Stedman Government Center
4808 Tower Hill Road, Suite 116
Wakefield, RI 02879-1900

(401) 783-3370
Fax (401) 783-3767

April 9, 2024

Department of Transportation
Attn: Alisa Richardson
360 Lincoln Avenue
Warwick, RI 02888

File Number: 2023-04-094
Site Address: East Bay Bike Path Bridges, Barrington River and Palmer River
Towns of Barrington and Warren

Dear Ms. Richardson:

Enclosed is the Public Hearing Notice for the above referenced CRMC File.

Please be advised that the enclosed Public Hearing notice for Special Exception must be advertised in the Providence Journal Bulletin at least 20 days prior to the hearing. Please provide us with a copy of the Advertisement article with the date intact. (See 4.3.4 of the RI CRMC Management Procedures).

Please call 783-3370 if you have any questions.

Sincerely,

Lisa A. Turner

Lisa A. Turner, Office Manager
Coastal Resources Management Council

/lat

Lisa Turner

From: Lisa Turner <lturner@crmc.ri.gov>
Sent: Tuesday, April 9, 2024 1:50 PM
To: 'Akinfolarin, Hamid (DOT)'; 'Scott Hobson'; 'Soderlund, Steven (DOT)'; 'Pompei, Anthony (DOT)'; 'Richardson, Alisa (DOT)'
Cc: 'Jeff Willis'; 'Laura Miguel'; 'Amy L Silva'; 'Ross Singer'
Subject: CRMC Notification of Public Hearing and Council review RIDOT 2023-04-094 East Bay Bike Path
Attachments: CRMC Public Hearing Notification 2023-04-094 RIDOT EBBP.pdf; RIDOT ProJo Notice 05-14-2024 mtg.pdf

Good Afternoon All: Please see the attached Notification of Public Hearing for Special Exception and Council Review scheduled for Tuesday, May 14th, 2024. The Public Hearing will be held at the CRMC Semimonthly Meeting at 6:00 p.m. in Conference Room A of the Administration Building, One Capitol Hill, Providence, RI.

Please note that the Public Hearing Notification must be posted in the Providence Journal Legal Notices to provide no less than 20 days' notice of the public hearing. Please provide confirmation of posting for CRMC file.

Thank you,

Lisa Turner

Lisa A. Turner, Office Manager and
Programming Svcs Officer
Coastal Resources Management Council
Oliver Stedman Government Center
4808 Tower Hill Road; Room 116
Wakefield, RI 02879
401-783-3370

From: asilva@crmc.ri.gov <asilva@crmc.ri.gov>
Sent: Tuesday, April 9, 2024 8:52 AM
To: 'Akinfolarin, Hamid (DOT)' <Hamid.Akinfolarin@dot.ri.gov>; Ross Singer <rsinger@crmc.ri.gov>; Jeff Willis <jwillis@crmc.ri.gov>; Laura Miguel <lmiguel@crmc.ri.gov>; 'Scott Hobson' <shobson@vhb.com>; Lisa Turner <lturner@crmc.ri.gov>
Cc: 'Soderlund, Steven (DOT)' <steven.soderlund@dot.ri.gov>; 'Pompei, Anthony (DOT)' <anthony.pompei@dot.ri.gov>; 'Richardson, Alisa (DOT)' <Alisa.Richardson@dot.ri.gov>
Subject: RE: EBBP Submission/Hearing Date

Hamid et al-

The Bike Path has been scheduled for the first Council meeting in May (May 14th). Please work with Lisa Turner (lturner@crmc.ri.gov) to get the Special Exception notice published ASAP.

Also, if you have additional information, as was suggested in the submission, please provide it to staff ASAP for inclusion in the staff reports. While the deadline for submission of new information is 7 days prior to the hearing, the sooner we get it, the better we can review it.



State of Rhode Island
Coastal Resources Management Council
Oliver H. Stedman Government Center
4808 Tower Hill Road, Suite 3
Wakefield, RI 02879-1900

(401) 783-3370
Fax (401) 783-2069

PUBLIC NOTICE

File Number: 2023-04-094

Date: February 23, 2024

This office has under consideration the application of:

Department of Transportation
Attn: Alisa Richardson
360 Lincoln Avenue
Warwick, RI 02888

for a State of Rhode Island Assent to construct and maintain the Reconstruction of the East Bay Bike Path bridges over the Barrington River and Palmer River (RIC #2022-DB-012) including the installation of new piers, abutments, truss spans, riprap scour protection, and stormwater management. The revised submission includes plans for fishing access and additional rip rap fill for scour protection. Fishing access consists of a permanent bulkhead on the western side of the Palmer River and a public fishing pier on the eastern side of the Barrington River. The fishing pier is a public recreational facility consisting of a 33'8"x11'4" fixed pier and 24'x11'4" terminal T. This project requires special exceptions to CRMP § 1.3.1(L)(3)(c) – alterations to coastal wetlands not designated for preservation adjacent to Type3 Waters § 1.3.1(M)(2)(a) – the construction of new public transportation facilities in tidal waters, § 1.3.1(G)(3)(c) – the filling on a coastal feature or tidal waters, and § 1.3.1(J)(3)(a) – filling in Type 2 waters Variances are required for (CRMP § 1.3.1(B)(3)(a)(6)), filling rather than cutting on causeway slopes and §1.3.1(B)(3)(e)(1)(AA)).filling on slopes steeper than 15 percent.

Project Location:	East Bay Bike Path Bridges
City/Town:	Barrington and Warren
Waterway:	Barrington River and Palmer River

Plans of the proposed work can be requested at Cstaff1@crmc.ri.gov.

In accordance with the Administrative Procedures Act (Chapter 42-35 of the Rhode Island General Laws) you may request a hearing on this matter.

You are advised that if you have good reason to enter protests against the proposed work it is your privilege to do so. It is expected that objectors will review the application and plans thoroughly, visit site of proposed work if necessary, to familiarize themselves with the conditions and cite what law or laws, if any, would in their opinion be violated by the work proposed.

If you desire to protest, you must attend the scheduled hearing and give sworn testimony. A notice of the time and place of such hearing will be furnished you as soon as possible after receipt of your request for hearing. If you desire to request a hearing, to receive consideration, it should be in writing (**with your correct mailing address, e-mail address and valid contact number**) and be received at this office on or before **March 25, 2024**. Please email your comments/hearing requests to: cstaff1@crmc.ri.gov; or mail via USPS to: Coastal Resources Management Council; O. S. Government Center, 4808 Tower Hill Road, Rm 116; Wakefield, RI 02879.

/lat

INDEX

SHEET NO.	DESCRIPTION
1	COVER SHEET
2	STANDARD PLAN SYMBOLS & STANDARD LEGEND
3	STANDARD NOTES - 1
4	STANDARD NOTES - 2
5	STANDARD NOTES - 3
6	TYPICAL SECTIONS
7-8	TEMPORARY WORK PLATFORM PLAN AND SECTION NOS. 1-2
9-12	PROFILES NOS. 1-4
13-16	PROFILES NOS. 1-4
17	MISCELLANEOUS DETAILS
18-20	RESTORATION PLAN NOS. 1-3
21-24	RECONSTRUCTION PLAN
25-26	CROSS SECTIONS

STATE OF RHODE ISLAND



DEPARTMENT OF TRANSPORTATION

PLAN, PROFILE AND SECTIONS OF PROPOSED
EAST BAY BIKE PATH BRIDGE REPLACEMENTS
BIKE PATH AND BRIDGE APPROACH PLANS
RECONSTRUCTION PLANS
ENVIRONMENTAL PERMITTING SET
VOLUME 1


EAST BAY BIKE PATH OVER BARRINGTON RIVER AND PALMER RIVER

TOWNS OF BARRINGTON AND WARREN
COUNTY OF BRISTOL


R.I. CONTRACT NO. 2022-DB-012 F.A. PROJECT NO. BRO-0838(002)

PAVEMENT STRUCTURE
1" CLASS 4.75 HMA
3" CLASS 19.0 HMA
12" GRAVEL BORROW SUBBASE COURSE

0.27 MILES

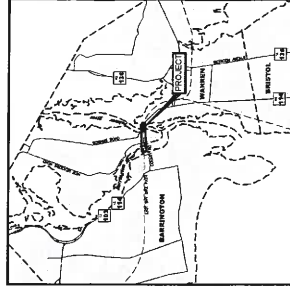

LOCATION MAP
SCALE 1"=1000

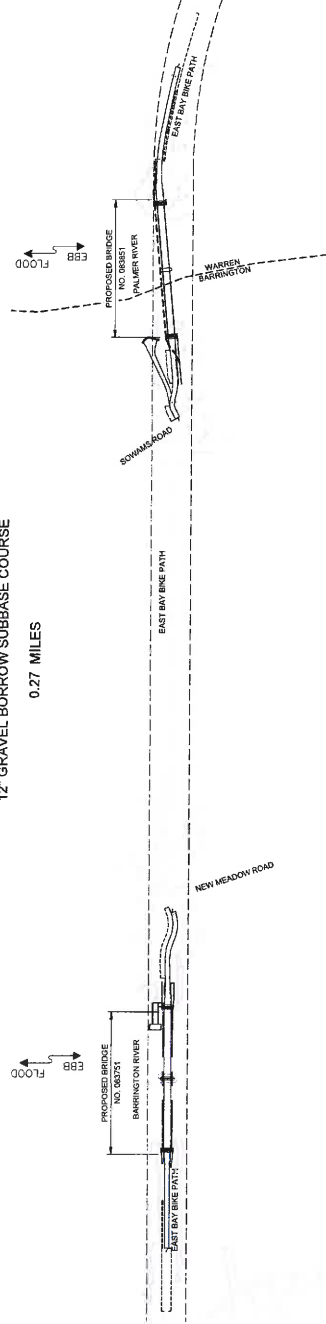

LAYOUT PLAN
SCALE 1"=200

SCALES OF DRAWINGS

Plan	1" = 20' feet
Profiles	1" = 4' feet
Cross Sections	1" = 4' feet
Gravel Sections	1" = 4' feet

BASE OF LEVELS

NAD 83

NAD 83 (2011)




R.I. STANDARD SPECIFICATIONS AND STANDARD DETAILS
SPECIFICATIONS TO GOVERN THIS PROJECT ARE THE R.I. STANDARD SPECIFICATIONS FOR ROAD AND BRIDGE CONSTRUCTION, MARCH 2014, WITH ALL REVISIONS AND THE STATE AND FEDERAL STANDARD SPECIFICATIONS INCLUDED IN THE CONTRACT DOCUMENTS.
REVISIONS: DETAILS FOR THIS PROJECT ARE R.I. STANDARD DETAILS, 1988 EDITION, WITH ALL REVISIONS.




PERMIT PLAN
REVISIONS
FEBRUARY 2024

R.I. DEPARTMENT OF TRANSPORTATION	
APPROVED	DATE
ADMINISTRATIVE PROJECT MANAGEMENT	DATE
APPROVED	DATE
CHIEF ENGINEER OF INFRASTRUCTURE	DATE
APPROVED	DATE
DIRECTOR	DATE
DEPARTMENT OF TRANSPORTATION FEDERAL HIGHWAY ADMINISTRATION	
APPROVED	DATE
DIVISION ADMINISTRATOR	DATE

Contract Number 2022-DB-012
Number of Sheet 1
Total Sheets 26

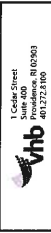

1-Copy Sheet
Size: 24" x 36" (NAD 83)
401.722.810



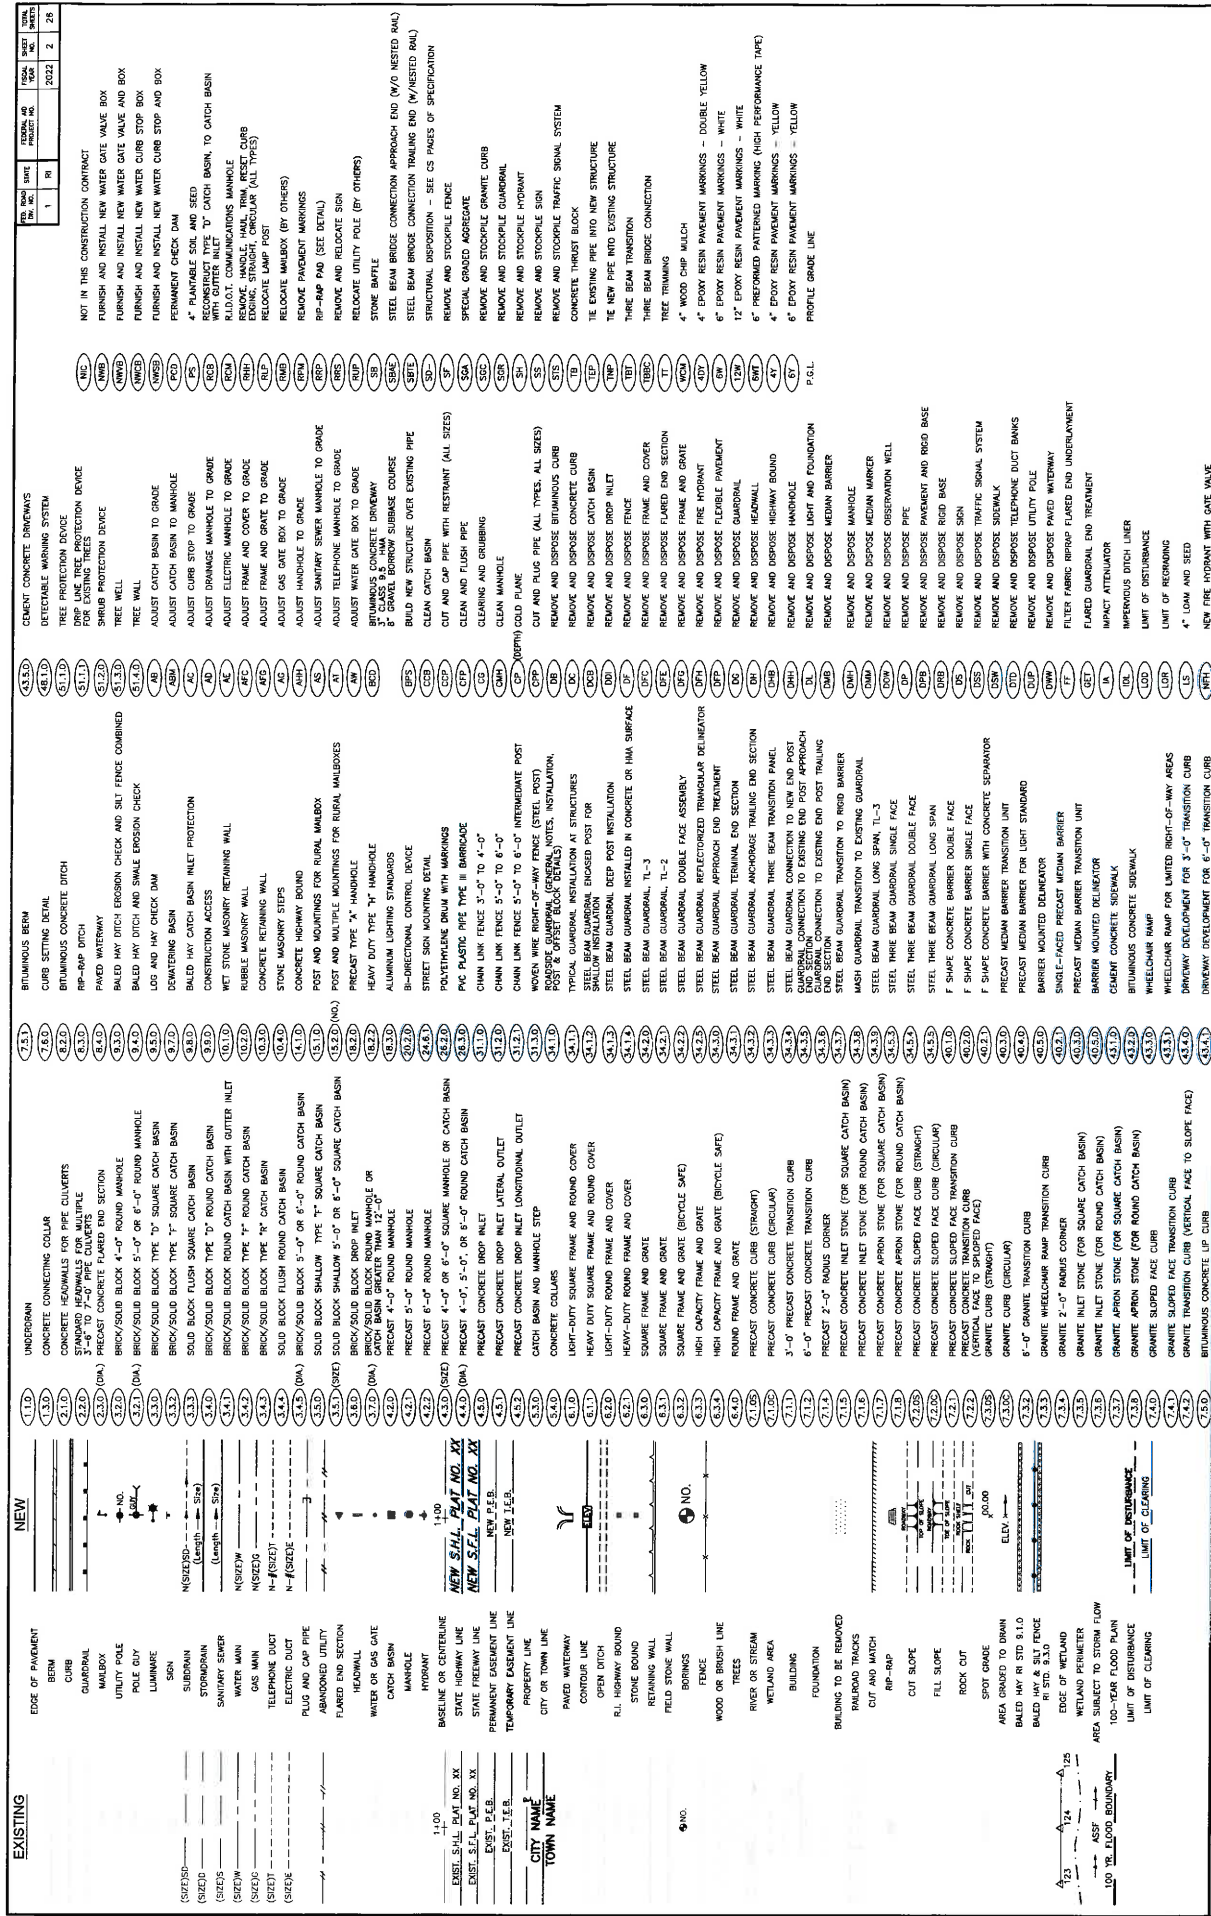


 RI DOT	RHODE ISLAND DEPARTMENT OF TRANSPORTATION	1 Cedar Street Suite 400 Providence, RI 02903 401.272.6100  VHB	DESIGN BY: CHECKED BY: DATE: DRAWN BY: DATE: SHEET: 2 OF:
SCALE: NOT TO SCALE		EAST BAY BIKE PATH BRIDGE REPLACEMENT (BARRINGTON RIVER AND WARREN BRIDGES)	
STANDARD PLAN SYMBOLS & STANDARD LEGEND		BARRINGTON WARREN VOLUME 1 RHODE ISLAND	

PERSONS		REGIONS			
NO.	DATE	BY	NO.	DATE	BY
1	5/07	HRB			
2	1/12/22	RS			

NO.	DATE	BY	CHKD	APP'D	SCALE	SHEET NO.	TOTAL SHEETS
1	2022	20	20	20	1"=4'	5	25

R-1

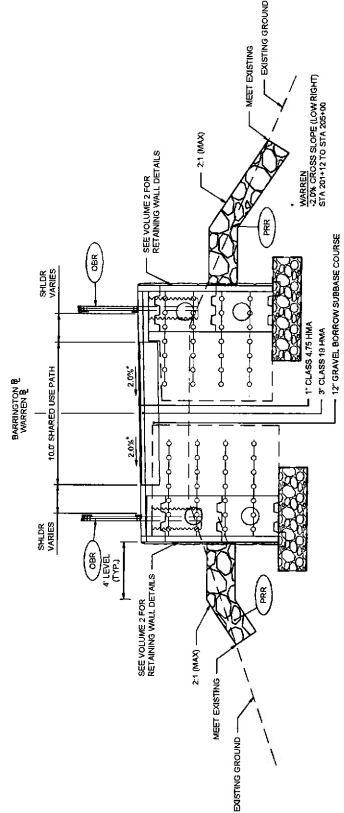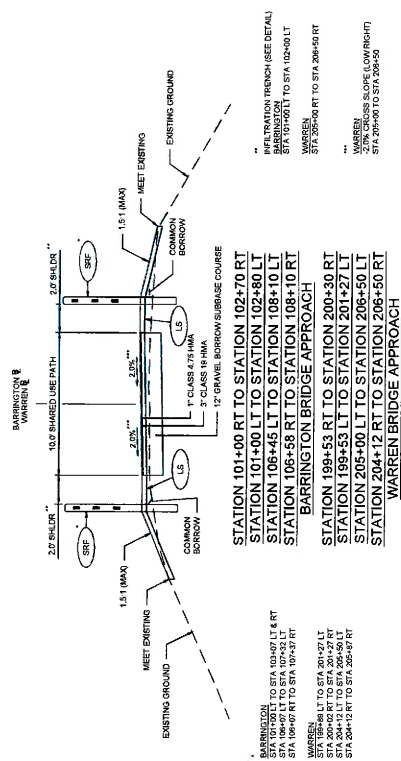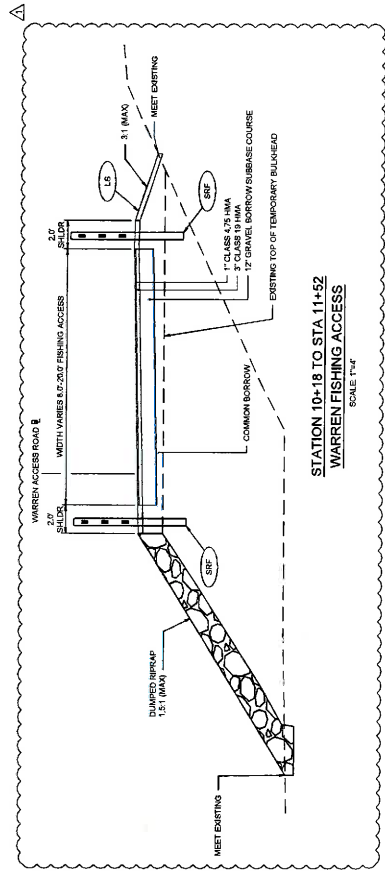

STATION 102+70 RT TO STATION 103+05 RT
STATION 102+80 LT TO STATION 103+05 LT
STATION 106+05 LT TO STATION 106+45 LT
STATION 106+05 RT TO STATION 106+58 RT
BARRINGTON BRIDGE APPROACH
STATION 200+30 RT TO STATION 201+27 RT
STATION 201+12 LT TO STATION 205+00 LT
WARREN BRIDGE APPROACH
SCALE 1"=4'

RHODE ISLAND
DEPARTMENT OF TRANSPORTATION

PROJECT: EAST BAY BIKE PATH BRIDGE REPLACEMENT
(BARRINGTON RIVER AND WARREN BRIDGES)
DESIGNED BY: BARRINGTON WARREN
DATE: 10/27/2022
PUBLIC RELEASE

SCALE: 1"=4'

NO.	DATE	BY	CHKD	APP'D
1	10/27/2022	20	20	20

AETNA
The Bridge Company

RHODE ISLAND
DEPARTMENT OF TRANSPORTATION

PROJECT: EAST BAY BIKE PATH BRIDGE REPLACEMENT
(BARRINGTON RIVER AND WARREN BRIDGES)
DESIGNED BY: BARRINGTON WARREN
DATE: 10/27/2022
PUBLIC RELEASE

STATION 101+00 LT TO STA 104+07 LT & RT
STA 104+07 LT TO STA 107+12 RT
STA 107+12 RT TO STA 108+10 LT
STA 108+10 LT TO STA 108+10 RT
STA 108+10 RT TO STA 109+53 LT
STA 109+53 LT TO STA 112+27 LT
STA 112+27 LT TO STA 115+50 LT
STA 115+50 LT TO STA 118+50 RT
STA 118+50 RT TO STA 121+27 LT
STA 121+27 LT TO STA 124+12 RT
STA 124+12 RT TO STA 127+00 RT

STATION 101+00 RT TO STATION 102+70 RT
STATION 101+00 LT TO STATION 102+80 LT
STATION 106+45 LT TO STATION 108+10 LT
STATION 106+58 RT TO STATION 108+10 RT
BARRINGTON BRIDGE APPROACH
STATION 199+53 RT TO STATION 200+30 RT
STATION 199+53 LT TO STATION 201+27 LT
STATION 205+00 LT TO STATION 206+50 LT
STATION 204+12 RT TO STATION 206+50 RT
WARREN BRIDGE APPROACH
SCALE 1"=4'

STATION 102+70 RT TO STATION 103+05 RT
STATION 102+80 LT TO STATION 103+05 LT
STATION 106+05 LT TO STATION 106+45 LT
STATION 106+05 RT TO STATION 106+58 RT
BARRINGTON BRIDGE APPROACH
STATION 200+30 RT TO STATION 201+27 RT
STATION 201+12 LT TO STATION 205+00 LT
WARREN BRIDGE APPROACH
SCALE 1"=4'

WARREN ACCESS ROAD

STATION 10+18 TO STA 11+52
WARREN FISHING ACCESS
SCALE 1"=4'

STATION 101+00 RT TO STATION 102+70 RT
STATION 101+00 LT TO STATION 102+80 LT
STATION 106+45 LT TO STATION 108+10 LT
STATION 106+58 RT TO STATION 108+10 RT
BARRINGTON BRIDGE APPROACH
STATION 199+53 RT TO STATION 200+30 RT
STATION 199+53 LT TO STATION 201+27 LT
STATION 205+00 LT TO STATION 206+50 LT
STATION 204+12 RT TO STATION 206+50 RT
WARREN BRIDGE APPROACH
SCALE 1"=4'

WARREN ACCESS ROAD

STATION 10+18 TO STA 11+52
WARREN FISHING ACCESS
SCALE 1"=4'

STATION 101+00 RT TO STATION 102+70 RT
STATION 101+00 LT TO STATION 102+80 LT
STATION 106+45 LT TO STATION 108+10 LT
STATION 106+58 RT TO STATION 108+10 RT
BARRINGTON BRIDGE APPROACH
STATION 199+53 RT TO STATION 200+30 RT
STATION 199+53 LT TO STATION 201+27 LT
STATION 205+00 LT TO STATION 206+50 LT
STATION 204+12 RT TO STATION 206+50 RT
WARREN BRIDGE APPROACH
SCALE 1"=4'

 FHWA Federal Highway Administration U.S. Department of Transportation	 VHB Virginia Highway Builders	1 Cedar Street Suite 200 South Providence, RI 02903 401.728.9100	Rhode Island DEPARTMENT OF TRANSPORTATION	DESIGNED BY: CHECKED BY: DATE: SHEET: 7 OF 28	RHODE ISLAND DEPARTMENT OF TRANSPORTATION EAST BAY BIKE PATH BRIDGE REPLACEMENT (BARRINGTON RIVER AND WARREN BRIDGES) BARRINGTON TOWNSHIPS VOLUME 1
---	--	---	---	--	--

SCALE: 1"=30'



REVISIONS



NO.	DATE	BY	NO.	DATE	BY

TEMPORARY WORK PLATFORM PLAN AND SECTION NO. 1

01BAA.VT_007 TEMPLATE

REV	DATE	BY	CHKD	APP'D	NO.	DATE	NO.	DATE
1	01/11/2022	PI			8	01/11/2022	8	01/11/2022

▲

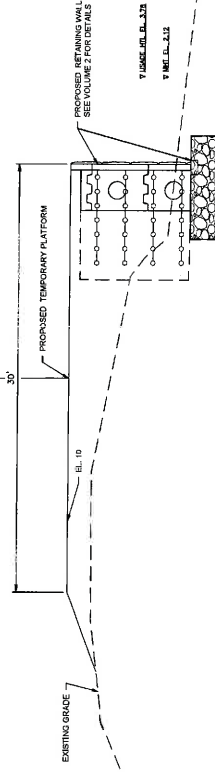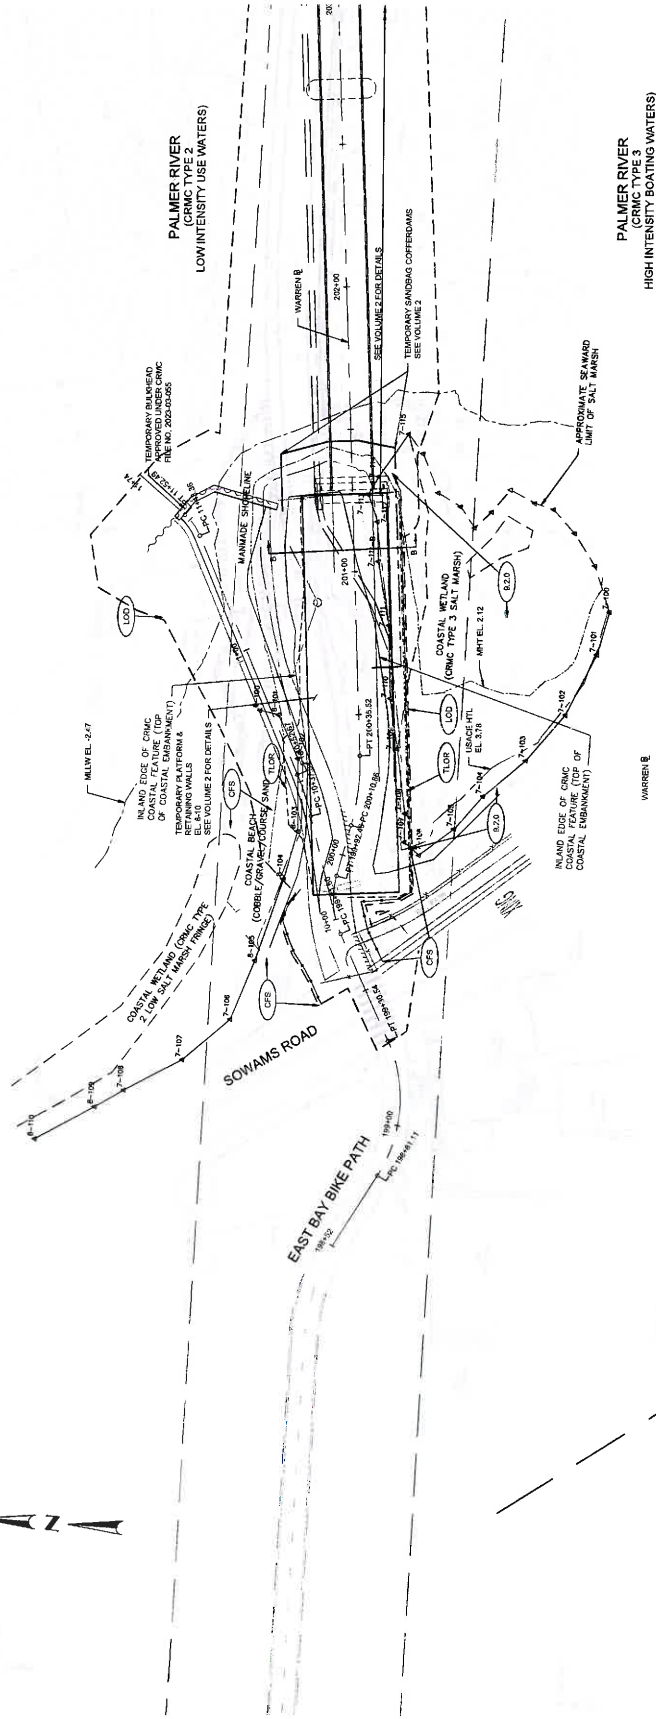

SECTION B-B
TEMPORARY PLATFORM
SCALE: 1"=4'

 1 Cedar Street Suite 400 Providence, RI 02903 401.212.5100 		RHODE ISLAND DEPARTMENT OF TRANSPORTATION		DESIGNED BY: CHECKED BY: DATE: REVISIONS NO. DATE BY NO. DATE BY SHEET: 8 OF: 26		SCALE: 1"=20' 0 10 20 30 40 50 60 70 80 90 100 FOOT 0 10 20 30 40 50 60 70 80 90 100 FEET		EAST BAY BIKE PATH BRIDGE REPLACEMENT (BARRINGTON RIVER AND WARREN BRIDGES) VOLUME 1 TEMPORARY WORK PLATFORM PLAN AND SECTION NO. 2 BARRINGTON WARREN VOLUME 1 RHODE ISLAND		0188A.V1.00E-TEMP-PLAT02	
---	--	---	--	---	--	--	--	---	--	-------------------------------------	--

R-1

N/F TOWN OF BARRINGTON -
PARKS (POLICE COVE PARK
PUMPING STATION)
283 COUNTY ROAD


RECEIVED
JUN 27 2024
CLARK, KERR & CO.
MANAGEMENT CONSULTANTS

GENERAL PLAN NO. 1

0188A_V1_009_GENERAL.001



REV	DATE	BY	CHKD	REVISION	NO.	TOTAL SHEETS
1				2022	12	28

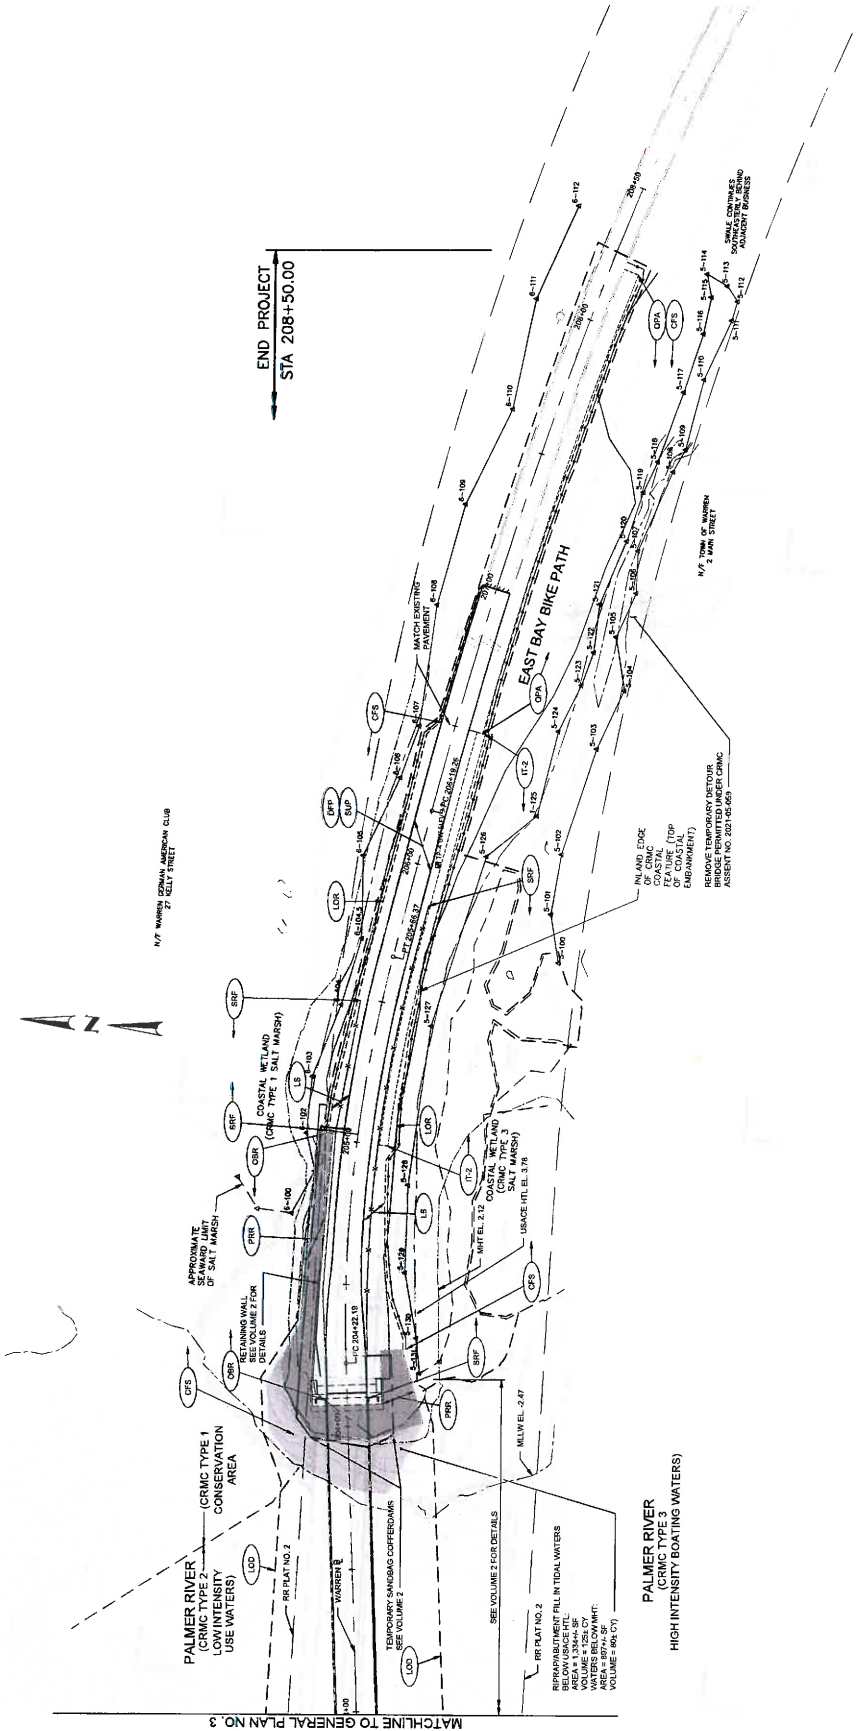



1 Cedar Street
Suite 400
Barrington, RI 02803
601.272.8100



RHODE ISLAND
DEPARTMENT OF TRANSPORTATION

EAST BAY BIKE PATH BRIDGE REPLACEMENT
(BARRINGTON RIVER AND WARREN BRIDGES)

VOLUME 1

BARRINGTON WARREN

RHODE ISLAND

GENERAL PLAN NO. 4

SCALE: 1"=20'

GRAPHIC SCALE

NO. 1 UNIT BY NO. 2 UNIT BY

REVISIONS

NO. 1 UNIT BY NO. 2 UNIT BY

REVISIONS

NO. 1 UNIT BY NO. 2 UNIT BY

REVISIONS


NO. 1 UNIT BY NO. 2 UNIT BY

REVISIONS

NO. 1 UNIT BY NO. 2 UNIT BY

REVISIONS

NO. 1 UNIT BY NO. 2 UNIT BY

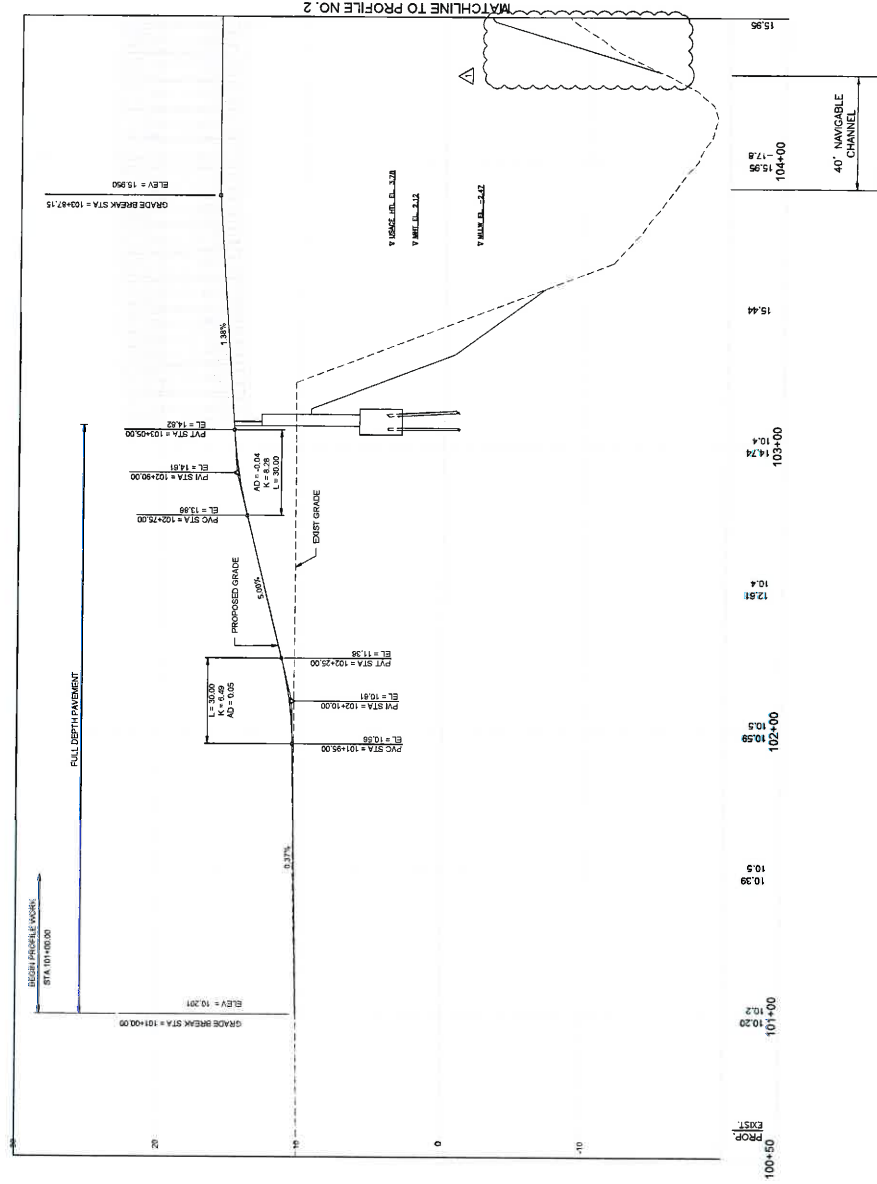

EAST BAY BIKE PATH BRIDGE REPLACEMENT

(BARRINGTON RIVER AND WARREN BRIDGES)

BRINGTON WARREN
VOLUME 1
RHODE ISLAND


PROFILE NO. 1

RHODE ISLAND
DEPARTMENT OF TRANSPORTATION



vhb
1 Cedar Street
Suite 400
Providence, RI 02903
401.272.8100

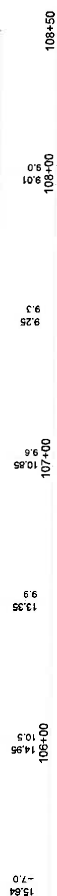

R-1


~~MATCHLINE TO PROFILE NO. 1~~

40' NAVIGABLE CHANNEL

 ETNA Engineering and Design	 1 Cedar Street Providence, RI 02903 401.772.8700	 RI DOT RHODE ISLAND DEPARTMENT OF TRANSPORTATION	PROJECT NO. 2023-001 DATE: OCTOBER 24, 2023 BY: [Signature] CHECKED BY: [Signature] PUBLIC HEARING RECORDED BY: [Signature] CHECKED BY: [Signature] REVISIONS NO. DATE BY NO. DATE BY	SCALE: 1" = 20' HOR., 1" = 4' VERT. 	EAST BAY BIKE PATH BRIDGE REPLACEMENT (BARRINGTON RIVER AND WARREN BRIDGES) VOLUME 1 BACKSIGHT COMMANDER	RHODE ISLAND PROFILE NO. 2
---	---	--	---	--	--	-------------------------------

REV	DATE	BY	CHKD	PROJECT NO.	DATE	BY	CHKD	SHEET NO.	TOTAL SHEETS
1	2022	RI			2022	15	26		

R-1

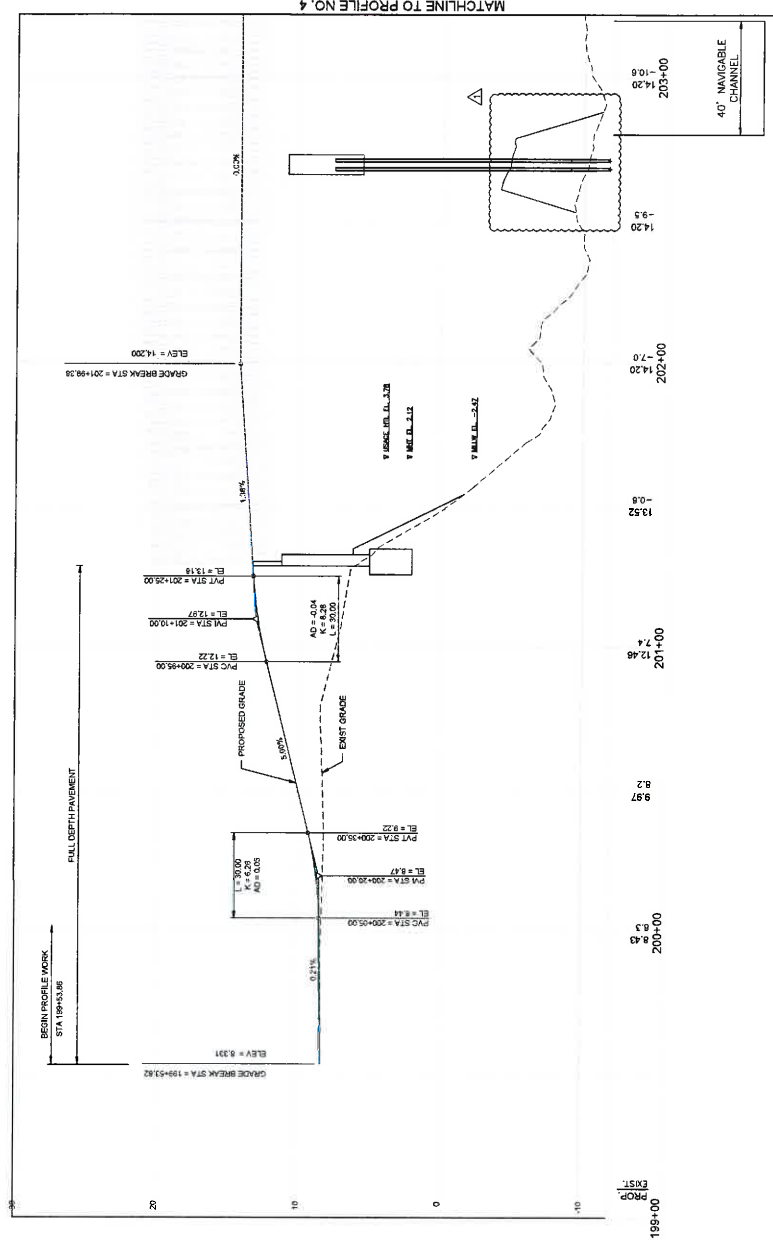

RHODE ISLAND
DEPARTMENT OF TRANSPORTATION

EAST BAY BIKE PATH BRIDGE REPLACEMENT
(BARRINGTON RIVER AND WARREN BRIDGES)

VOLUME 1

PROFILE NO. 3

1 Cedar Street
Providence, RI 02903
401.272.8100


PROJECT: 2022-01-01
DESIGNED BY: [Signature]
CHECKED BY: [Signature]
DATE: 2/7/24
SHEET: 15 OF 26

SCALE: 1" = 20' HOR., 1" = 4' VERT.


NO.	DATE	BY	CHKD	REVISIONS
1	2/7/24	WB		

DESIGNED BY: [Signature]
CHECKED BY: [Signature]
DATE: 2/7/24
SHEET: 15 OF 26


FED. ROAD DIST. NO.	STATE	FEDERAL AID PROJECT NO.	FISCAL YEAR	SHEET NO.	TOTAL SHEETS
1	RI		2022	17	26

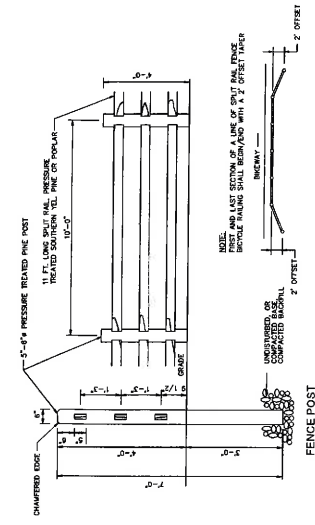


SPLIT RAIL FENCE

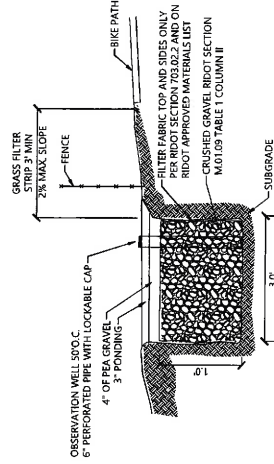


INFI TRATION TRENCH - 2 (E-2)

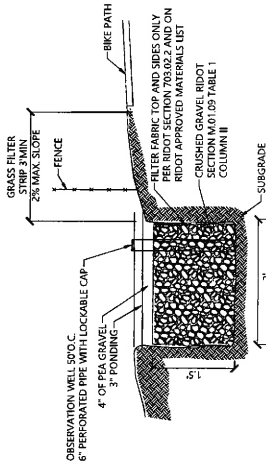

INFILTRATION TRENCH - 1

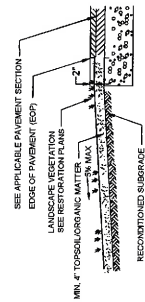


QUALIFIED PERSON IS AREA

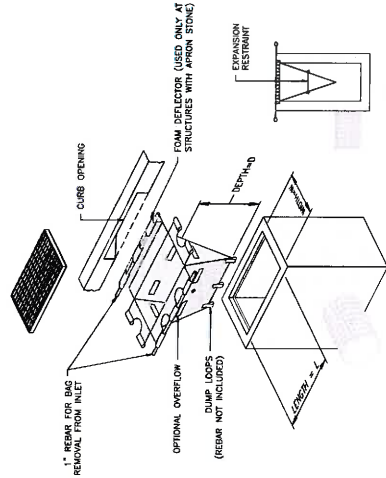


INLET SEDIMENT CONTROL DEVICE NOTES:

1. MEASURE CATCH BASIN DIMENSIONS AND PROVIDE APPROPRIATELY-SIZED DEVICES PER MANUFACTURER'S REQUIREMENTS.
2. INSTALL INLET PROTECTION IN CATCH BASIN BEFORE COMMENCING ANY ROADWORK.
3. GRATE TO BE PLACED OVER INLET PROTECTION.
4. INLET PROTECTION SHALL BE INSPECTED PERIODICALLY AFTER ALL STORM EVENTS. CLEANING OR REPLACEMENT SHALL BE PERFORMED PROMPTLY AS NEEDED. MAINTAIN ALL DISTURBED AREAS HAVE BEEN PERMANENTLY STABILIZED.

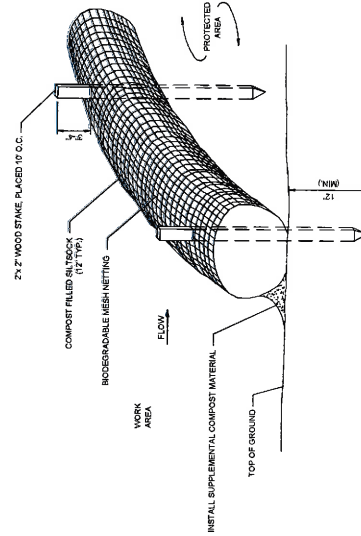COMPOST FILTER SOCK

- NOTES:**
1. FILTER SOCK SHALL OVERLAP A MINIMUM OF 12 INCHES.
 2. FILTER SOCK SHALL BE INSPECTED PERIODICALLY AND AFTER ALL STORM EVENTS, AND REPAIR OR REPLACEMENT SHALL BE PERFORMED PROMPTLY AS NEEDED.
 3. COMPOST MATERIAL SHALL BE DISPERSED ON SITE, AS DETERMINED BY THE ENGINEER.
 4. IF NON BIODEGRADABLE NETTING IS USED THE NETTING SHALL BE COLLECTED AND

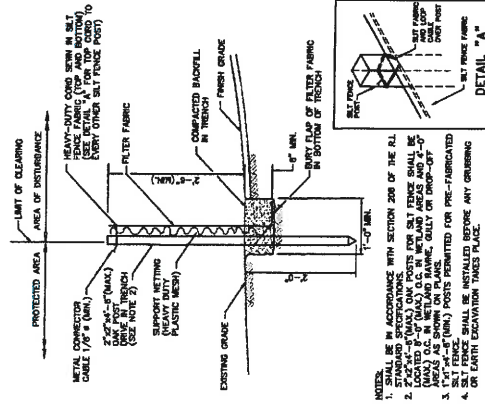


SEE T E N C E D E T A I L

- NOTES:**
1. SHAL
STAN
2. 2"x2"
LOGA
(MAX)
AREA
3. 1"x1"
SLT
4. CUT

 1 Codd Street Suite 400 Providence, RI 02903 401.722.1100  VHB VOLUME 1  RHODE ISLAND DEPARTMENT OF TRANSPORTATION	ISSUED BY: _____ CHECKED BY: _____ DATE: _____ SHEET: 17 OF 26	SCALE: AS SHOWN	
---	---	-----------------	---

R-1

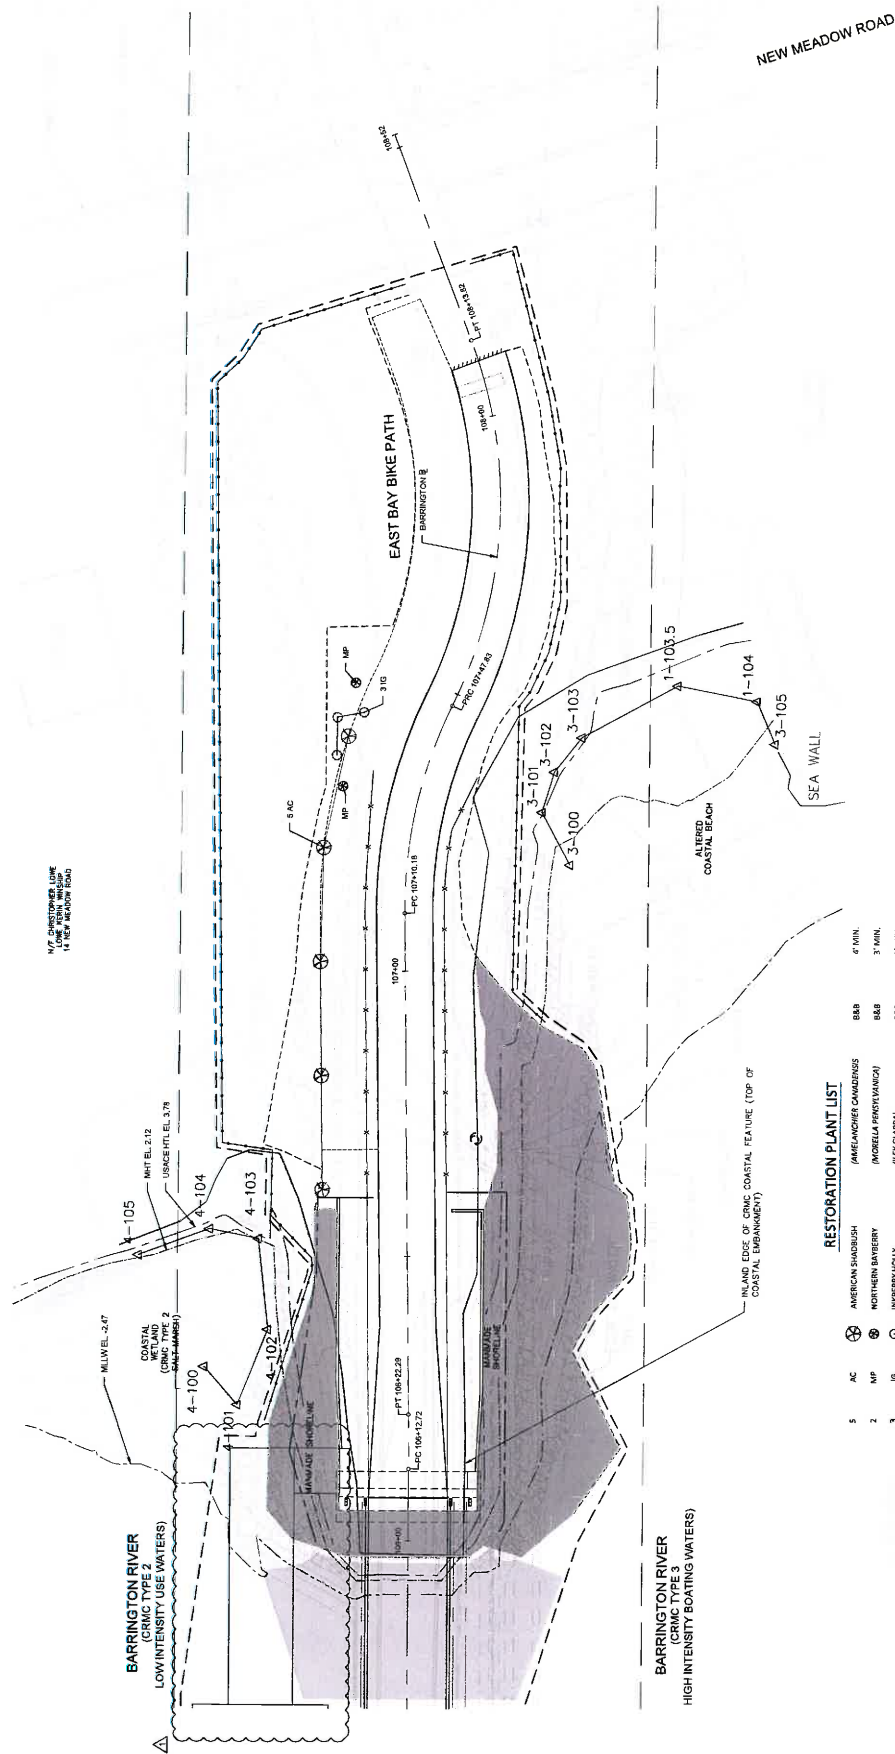

		RESTORATION PLANT LIST			
5	AC		AMERICAN SHADBLOW	(AMELANCHIER CANADENSIS)	
2	MP		NORTHERN BAYBERRY	(MOBILIA PENNSYLVANICA)	
3	IG		INKBERRY HOLLY	(ILEX GLABRA)	

 AT&T no Badge Company	 VHB 1 Cedar Street Suite 400 Boston, MA 02103 617.722.8100	 RI DOT RHODE ISLAND DEPARTMENT OF TRANSPORTATION	PROJECT MODIFICATIONS SINCE PREVIOUS EDITION CIRCLED FULL CANCEL CIRCLED PARTIAL REQUIRED BY: CADD BY: DATE: SHEET: 16 OF: 26 SCALE: 1" = 10' 	EAST BAY BIKE PATH BRIDGE REPLACEMENT (BARRINGTON PARK AND WARRIOR BRIDGES) VOLUME 1 BARRINGTON WARREN RHODE ISLAND
--	--	--	---	---

GENERAL MITIGATION NOTES

ALL WORK SHALL COMPLY WITH THE APPROVED

- SEAWARD MOST BLOCK AND ON THE WEST SIDE OF THE RIVER. PLUG SPACING ON ENTIRE DESIGNATED AREA IS LIMITED TO ONE FOOT SPACING OVER ENTIRE DESIGNATED AREA.
- MIDDLE BLOCK: SALT MEADOW CORRIDOR (Spartina pectinata) TO BE PLANTED AT ONE FOOT SPACING OVER ENTIRE DESIGNATED AREA.
- UPPER EASTWARD MOST BLOCK: SALT MEADOW CORRIDORS AND SALT GRASS CORRIDORS TO BE PLANTED AT ONE FOOT SPACING OVER ENTIRE DESIGNATED AREA AT A RATIO OF 2 PLUGS SALT MEADOW CORRIDOR TO ONE PLUG SALT GRASS.

1. SUBSTRATES IN CHANNELS, RIDGES OR LEANWAYS SHOULD BE FLATTENED TO MECHANICALLY UNIFORM SURFACES OR MINERALS TO WHICH THEY CAN REMAIN UNMOVED AGAINST CURRENTS AND WAVY ACTION.
2. SUBSTRATES BETWEEN SAWING AND MIDDLE REFERENCE ETCHES SHALL BE GRADUALLY SLOPED TO ADAPT TO A FLAT FOOT AND A FLATTENED SURF SHALL BE CLEANED TO SUBSTRATE TO ONE PART PER THOUSAND SAND. THE EXISTING SURF SHALL BE GRADUALLY SLOPED TO ADAPT TO A FLATTENED SURF. EXISTING SUBSTRATES SHALL BE REMOVED PRIOR TO SAND UNIFORMITY. WHAT IS REMOVED SHALL BE MIXED WITH THE EXISTING SUBSTRATES TO THE ONE PART PER THOUSAND.
3. SUBSTRATES BETWEEN THE MIDDLE AND UPPER STAGES SHALL BE GRADUALLY SLOPED TO ADAPT TO A FLATTENED SURF. THE EXISTING SURF SHALL BE REMOVED PRIOR TO SAND UNIFORMITY. WHAT IS REMOVED SHALL BE MIXED WITH THE EXISTING SUBSTRATES TO THE ONE PART PER THOUSAND. THE UPPER FOOT SHALL BE REMOVED AND REPLACED WITH A FLATTENED SURF. THE EXISTING SURF SHALL BE REMOVED PRIOR TO SAND UNIFORMITY. WHAT IS REMOVED SHALL BE MIXED WITH THE EXISTING SUBSTRATES TO THE ONE PART PER THOUSAND. THE EXISTING SURF SHALL BE REMOVED PRIOR TO SAND UNIFORMITY. WHAT IS REMOVED SHALL BE MIXED WITH THE EXISTING SUBSTRATES TO THE ONE PART PER THOUSAND. THE EXISTING SURF SHALL BE REMOVED PRIOR TO SAND UNIFORMITY. WHAT IS REMOVED SHALL BE MIXED WITH THE EXISTING SUBSTRATES TO THE ONE PART PER THOUSAND.

1. SUBSTRATES OR CHANNELS, OTHER THAN BEDROCK, SHALL NOT BE MECHANICALLY UNDERMINED OR MINORED SO THAT CONSIDERABLE HAZARDS AGAINST CURRENTS AND WAVE ACTION.
2. SUBSTRATES BETWEEN SHALLOW AND MIDDLE REFERENCE STAGES SHALL BE MECHANICALLY COARSEDED TO A DEPTH OF ONE FOOT AND ARGUMENTS WITH REGARD TO THE NECESSITY OF COARSEDED SUBSTRATES SHALL BE BASED ON THE EXISTING SUBSTRATE TO ONE FOOT INTRODUCED AND, THE EXISTING EXISTING SUBSTRATES AND COARSEDED SHALL BE MAINTAINED SUCH THAT COARSEDED SUBSTRATES SHALL BE MAINTAINED WITH THE EXISTING SUBSTRATES INTRODUCED AND SHALL THEN BE WELL MIXED WITH THE EXISTING SUBSTRATES TO THE ONE-FOOT DEPTH.
3. SUBSTRATES BETWEEN THE MIDDLE AND UPPER STAGES SHALL BE MECHANICALLY COARSEDED TO A DEPTH OF ONE FOOT AND ARGUMENTS SHALL BE BASED ON THE EXISTING SUBSTRATE TO ONE FOOT INTRODUCED AND, THE EXISTING SUBSTRATES SHALL BE MAINTAINED WITH THE EXISTING SUBSTRATES INTRODUCED AND SHALL THEN BE WELL MIXED WITH THE EXISTING SUBSTRATES TO THE ONE-FOOT DEPTH.
4. SUBSTRATES BETWEEN THE MIDDLE AND UPPER STAGES SHALL BE MECHANICALLY COARSEDED TO A DEPTH OF ONE FOOT AND ARGUMENTS SHALL BE BASED ON THE EXISTING SUBSTRATE TO ONE FOOT INTRODUCED AND, THE EXISTING SUBSTRATES SHALL BE MAINTAINED WITH THE EXISTING SUBSTRATES INTRODUCED AND SHALL THEN BE WELL MIXED WITH THE EXISTING SUBSTRATES TO THE ONE-FOOT DEPTH.







REPLICATION/RESTORATION AREAS

- REPLICATION/RESTORATION AREAS**
- CORAGRASS (*SPARTINA ALTERNIFLORA*)
- CORAGRASS (*SPARTINA PATENS*)
- CORAGRASS (*SPARTINA PATENS*)
- CORAGRASS (*DISTICHLIS SPICATA*)
- ALONG RETAINING WALL**
- H (*IWA FRUTESCENS*)
- CORAGRASS (*SPARTINA ALTERNIFLORA*)
- CORAGRASS (*SPARTINA PATENS*)

9 IF HIGHTIDE BUSH

- CORDGRASS
(SPARTINA ALTERNIFLORA)

NO.	DATE	REVISION NO.	BY	DATE	NO.	DATE	BY
1	08			2022	22		

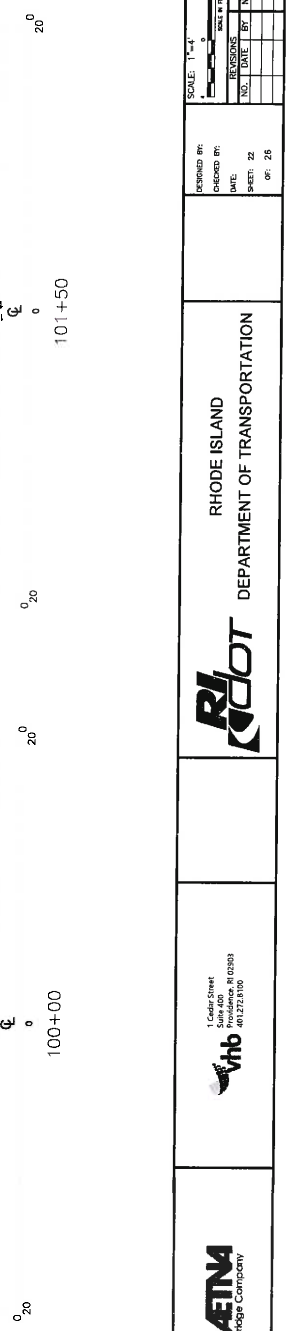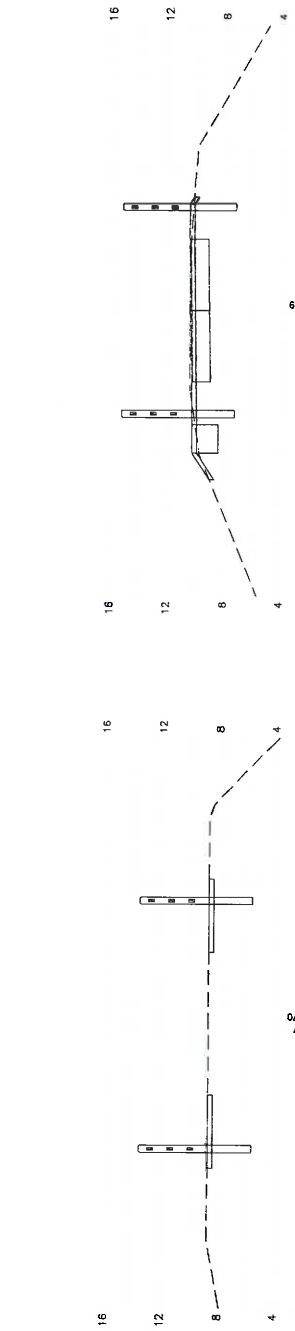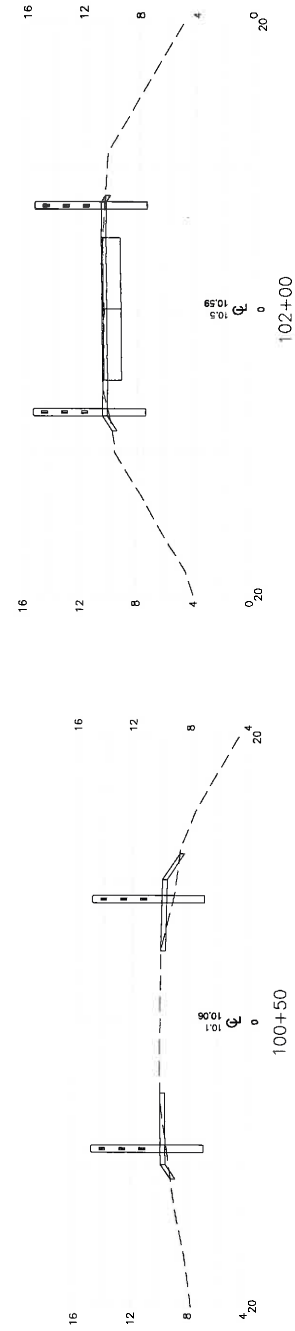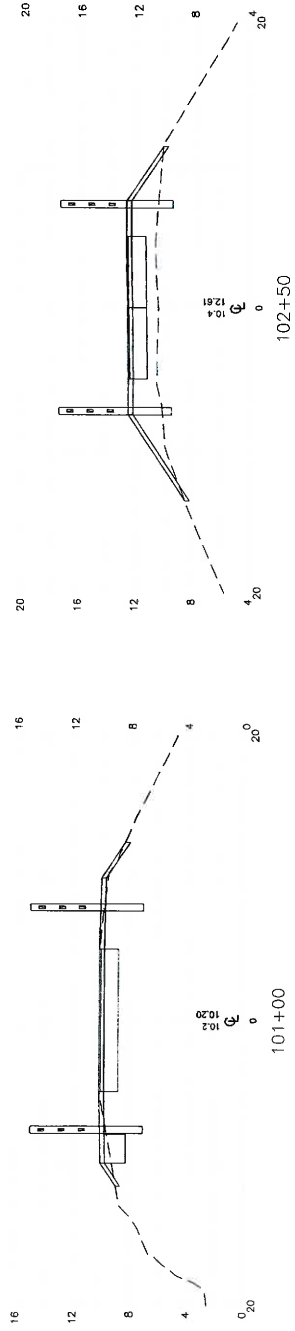



RHODE ISLAND
DEPARTMENT OF TRANSPORTATION

EAST BAY BIKE PATH BRIDGE REPLACEMENT
(BARRINGTON RIVER AND WARREN BRIDGES)

BARRINGTON WARREN

VOLUME 1

CROSS SECTIONS



ETNA
Pro Bridge Company




1 Cedar Street
Providence, RI 02903
603.772.8100



SCALE: 1"=4'

NO. DATE BY NO. DATE BY

REV	DATE	BY	CHKD	APP'D	REVISION	SHEET NO.	TOTAL SHEETS
1						23	26

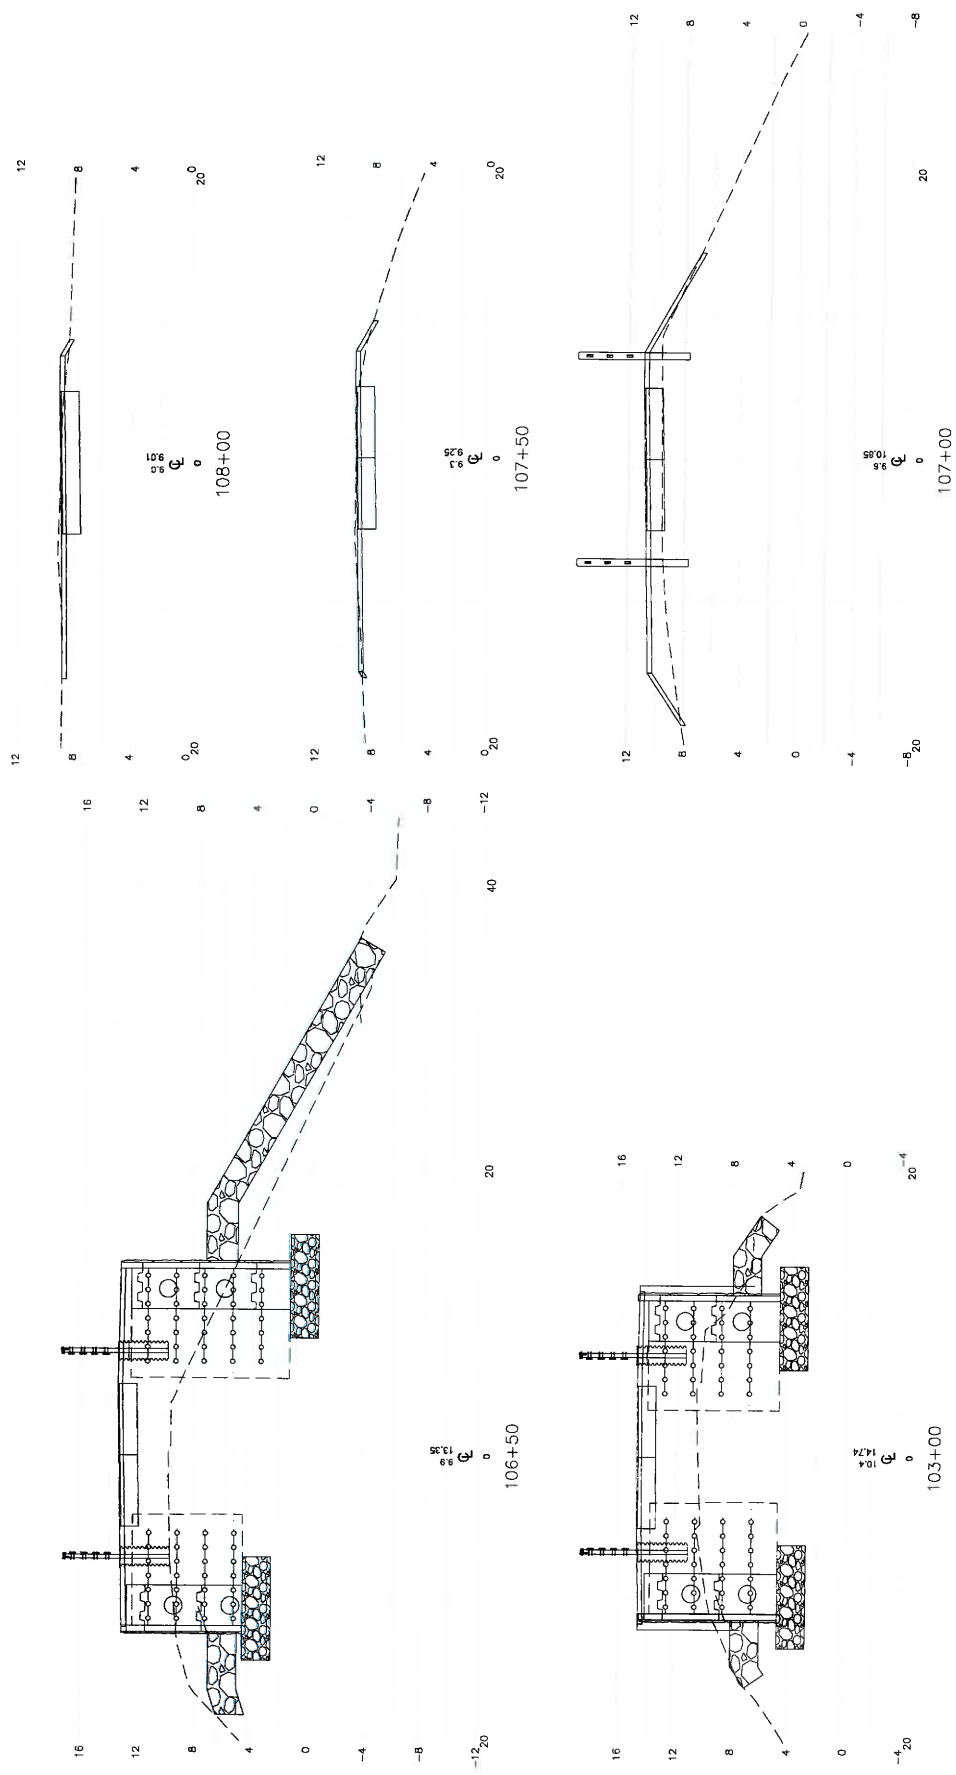



RHODE ISLAND
DEPARTMENT OF TRANSPORTATION



1 Cedar Street
Providence, RI 02903
603.272.8100



AETNA
Pro Bridge Company

EAST BAY BIKE PATH BRIDGE REPLACEMENT
(BARRINGTON RIVER AND WARREN BRIDGES)

BARRINGTON WARREN

CROSS SECTIONS

DESIGNED BY: [blank]
CHECKED BY: [blank]
DATE: 2/3
SHEET: 23 OF 26

SCALE: 1"=4'


SECTION NO. [blank] DATE [blank] BY [blank]

VOLUME 1

RHODE ISLAND

REV	DATE	BY	CHKD	APP'D	REASON
1	10/22/24	RE			

R-1

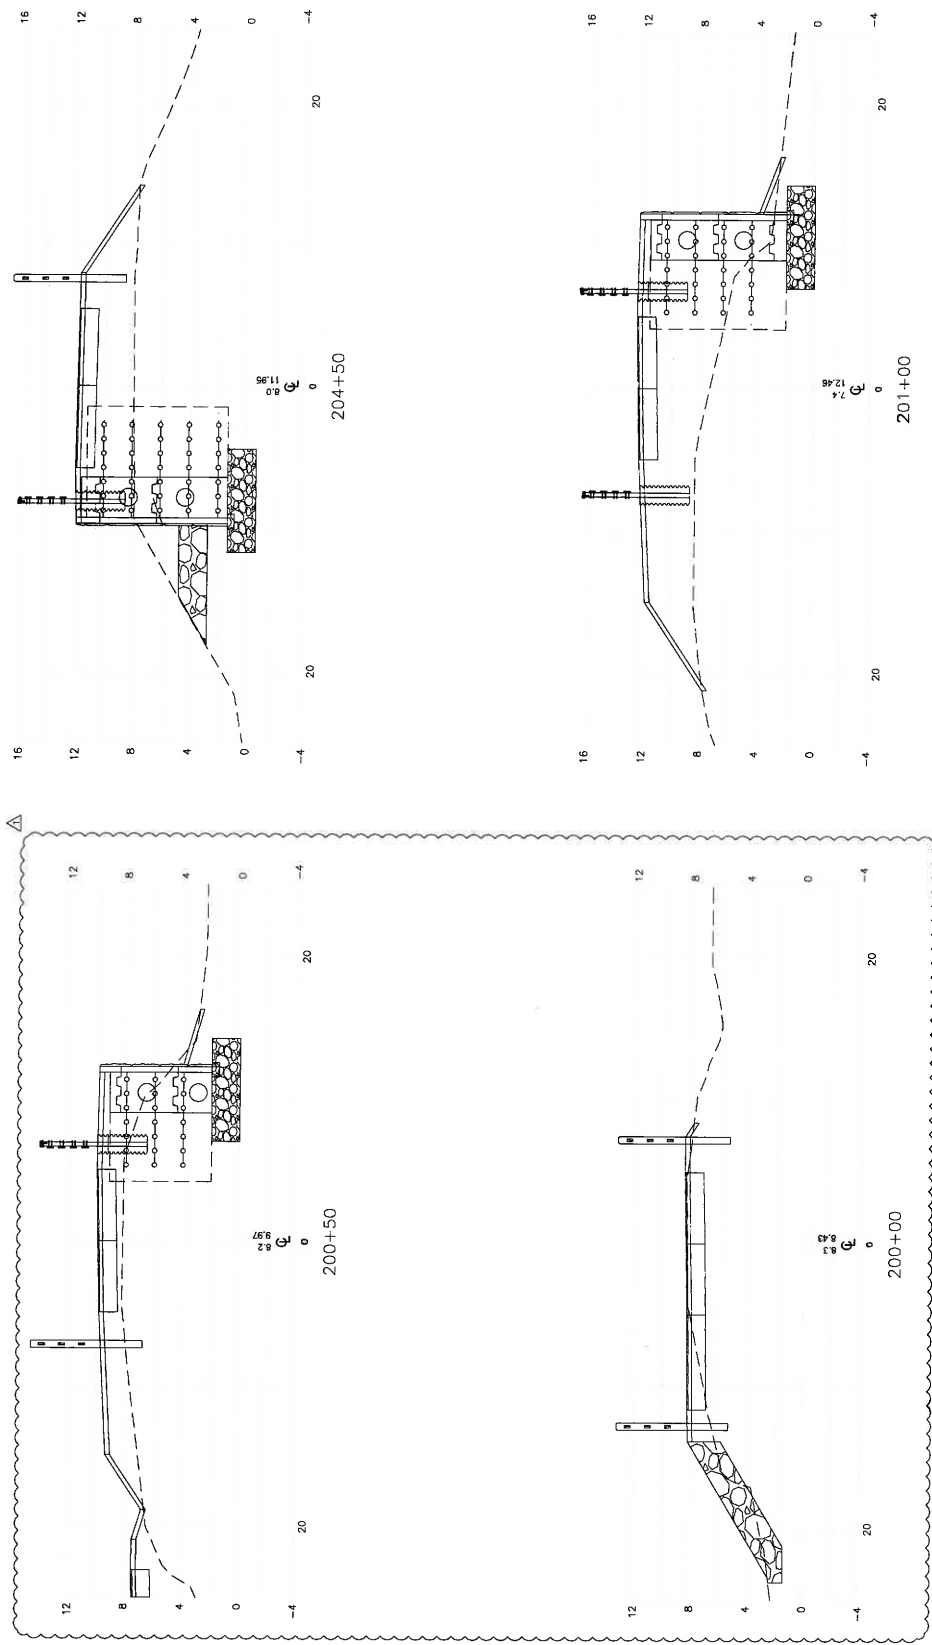



AETNA
The Bridge Company



1 Cedar Street
Providence, RI 02903
401.772.8100



RHODE ISLAND
DEPARTMENT OF TRANSPORTATION

EAST BAY BIKE PATH BRIDGE REPLACEMENT
(BARRINGTON RIVER AND WARREN BRIDGES)

RHODE ISLAND

PROJECT: EAST BAY BIKE PATH BRIDGE REPLACEMENT
DATE: OCTOBER 24, 2023
PUBLIC: RHODE ISLAND

REVISIONS

NO.	DATE	BY	NO.	DATE	BY
1	7/7/24	RE			


SCALE: 1"=4'

GROUND IN: 16' 0" 12' 0" 8' 0" 4' 0" 0' 0" -4' 0"

PROPOSED IN: 16' 0" 12' 0" 8' 0" 4' 0" 0' 0" -4' 0"

CROSS SECTIONS

REV	DATE	BY	CHKD	APPD	REVISION
1	1	1	1	1	1

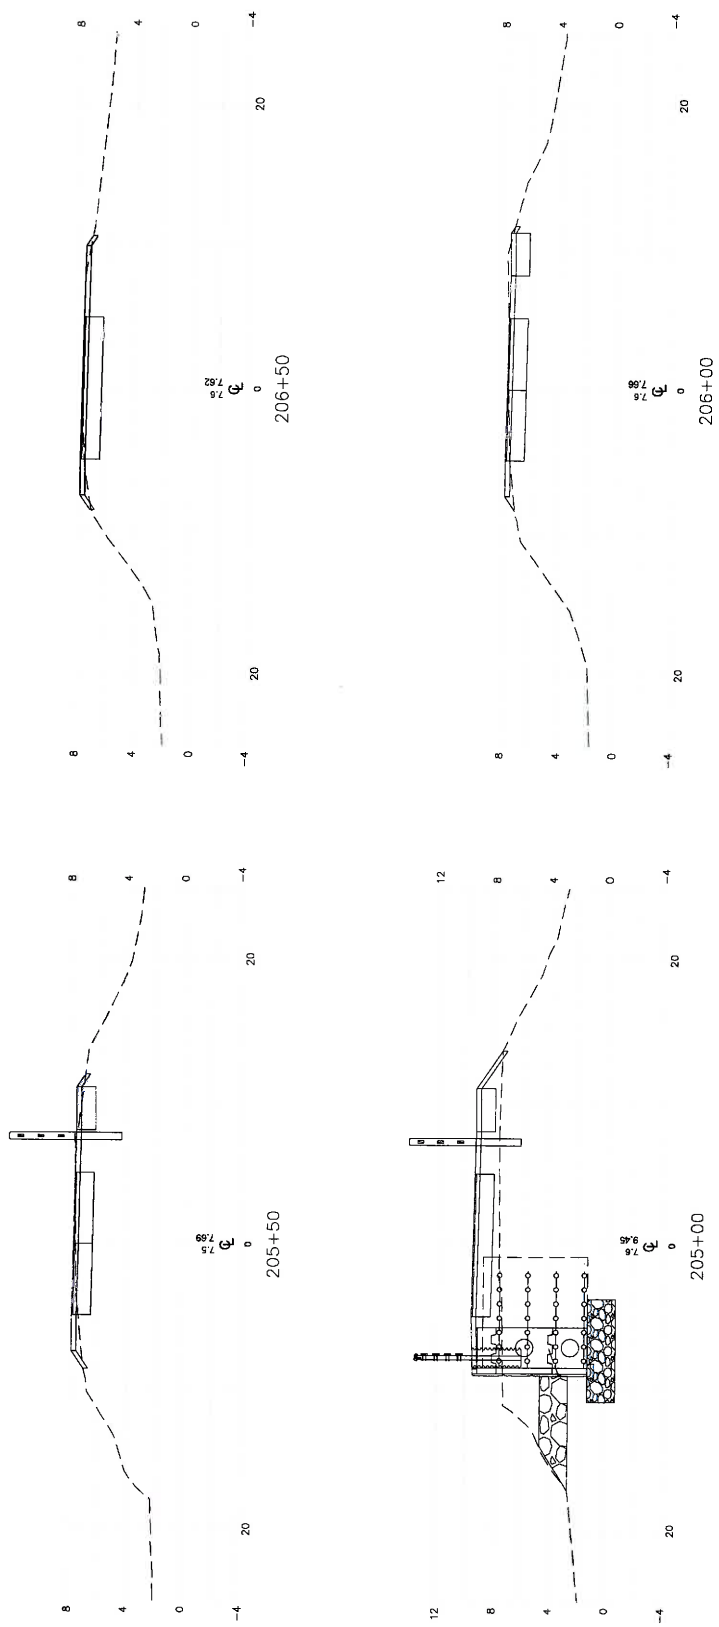

277/7024
CONSTRUCTION

1 Cedar Street
Providence, RI 02903
861.272.8100

RHODE ISLAND
DEPARTMENT OF TRANSPORTATION

EAST BAY BIKE PATH BRIDGE REPLACEMENT
(BARRINGTON RIVER AND WARREN BRIDGES)

VOLUME 1



CROSS SECTIONS

REVISIONS

NO.	DATE	BY	CHKD	APPD
1	1	1	1	1

DATE: 25
BY: 26

REV	DATE	BY	CHKD	APP'D	NO.	DATE	NO.	DATE
1					1	2022	25	25

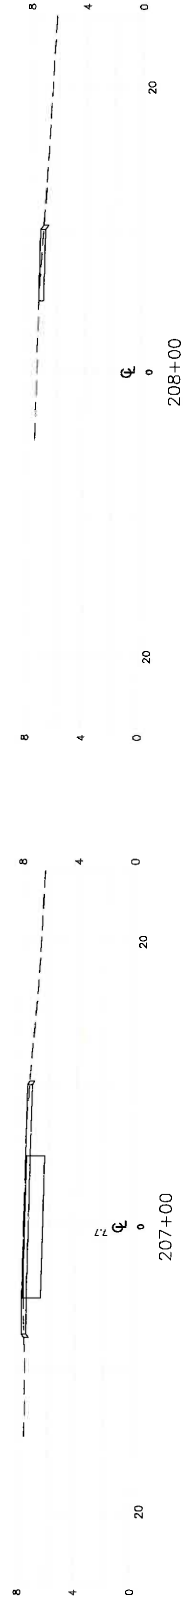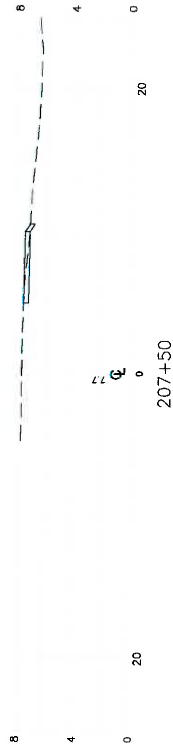



207/208
207/208
207/208



1 Cedar Street
Providence, RI 02903
401.272.8100



RHODE ISLAND
DEPARTMENT OF TRANSPORTATION

DESIGNED BY:
CHECKED BY:
DATE:
SHEET: 28
OF: 28

SCALE: 1"=40'

REVISIONS		REVISIONS	
NO.	DATE	NO.	DATE

EAST BAY BIKE PATH BRIDGE REPLACEMENT
(BARRINGTON RIVER AND WARREN BRIDGES)

VOLUME 1

CROSS SECTIONS

INDEX

Sheet Description

- 1 COVER
- 2 LIST OF ABBREVIATIONS AND LEGEND
- 3 JOB SPECIFIC GENERAL NOTES 1
- 4 JOB SPECIFIC GENERAL NOTES 2
- 5 JOB SPECIFIC GENERAL NOTES 3
- 6 JOB SPECIFIC GENERAL NOTES 4
- 7 BR. 083751 GENERAL PLAN
- 8 BR. 083751 BRIDGE TYPICAL SECTION
- 9 BR. 083751 PROFILE
- 10 BR. 083751 FOUNDATION PLAN
- 11 BR. 083751 WEST ABUTMENT PLAN AND ELEVATION
- 12 BR. 083751 EAST ABUTMENT PLAN AND ELEVATION
- 13 BR. 083751 ABUTMENT DETAILS
- 14 BR. 083751 RETAINING WALL PLAN 1
- 15 BR. 083751 RETAINING WALL PLAN 2
- 16 BR. 083751 RETAINING WALL PLAN 3
- 17 BR. 083751 RETAINING WALL PLAN 4
- 18 BR. 083751 PIER DETAILS
- 19 BR. 083751 FISHING PIER GENERAL PLAN
- 20 BR. 083751 FISHING PIER ELEVATION
- 21 BR. 083751 FISHING PIER TYPICAL SECTION
- 22 BR. 083851 BRIDGE GENERAL PLAN
- 23 BR. 083851 BRIDGE TYPICAL SECTION
- 24 BR. 083851 BRIDGE PROFILE
- 25 BR. 083851 FOUNDATION PLAN
- 26 BR. 083851 WEST ABUTMENT PLAN AND ELEVATION
- 27 BR. 083851 EAST ABUTMENT PLAN AND ELEVATION
- 28 BR. 083851 ABUTMENT DETAILS
- 29 BR. 083851 RETAINING WALL PLAN 1
- 30 BR. 083851 RETAINING WALL PLAN 2
- 31 BR. 083851 PIER DETAILS
- 32 BR. 083851 FISHING PIER GENERAL PLAN
- 33 BR. 083751 & 083851 RIP RAP DETAILS 1
- 34 BR. 083751 & 083851 RIP RAP DETAILS 2
- 35 BR. 083751 & 083851 BRIDGE RAIL DETAILS 1
- 36 BR. 083751 & 083851 RAIL DETAILS 2
- 37 BR. 083751 & 083851 RAIL DETAILS 3
- 38 BR. 083751 & 083851 RAIL DETAILS 4

STATE OF RHODE ISLAND



DEPARTMENT OF TRANSPORTATION


PLAN, PROFILE AND SECTIONS OF PROPOSED
EAST BAY BIKE PATH BRIDGE REPLACEMENTS
BRIDGE NOS. 083751 & 083851
RECONSTRUCTION PLANS
ENVIRONMENTAL PERMITTING SET
VOLUME 2

EAST BAY BIKE PATH OVER BARRINGTON RIVER AND PALMER RIVER


TOWNS OF BARRINGTON AND WARREN
COUNTY OF BRISTOL

R.I. CONTRACT NO. 2022-DB-012 F.A. PROJECT NO. BRO-0838(002)

DATE	BY	REVISION	DATE	BY	REVISION
2022	1	1	2022	1	38

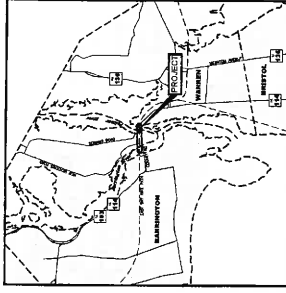


LOCATION MAP
SCALE 1"=1000'

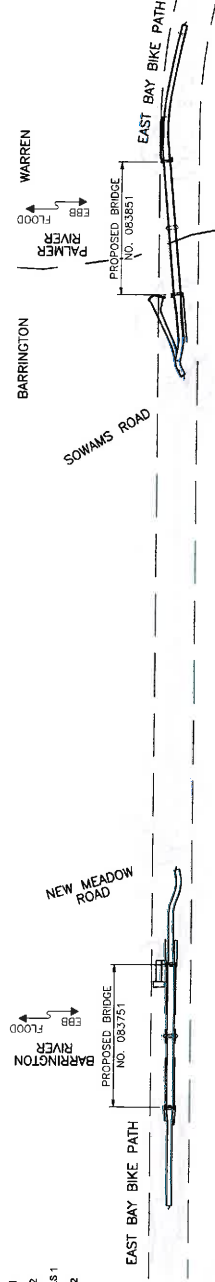

PERMIT PLAN
REVISIONS
FEBRUARY 2024

R.I. DEPARTMENT OF TRANSPORTATION	
APPROVED	DATE
ADMINISTRATIVE PROJECT MANAGEMENT	DATE
APPROVED	DATE
CHIEF ENGINEER OF INFRASTRUCTURE	DATE
APPROVED	DATE
DIRECTOR	DATE
DEPARTMENT OF TRANSPORTATION FEDERAL HIGHWAY ADMINISTRATION	
APPROVED	DATE
DIVISION ADMINISTRATOR	DATE

Contract Number 2022-DB-012
Number of Sheet 1
Total Sheets 38

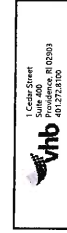

BASE OF LEVELS
NAVD 88
NAD 83 (2011)



ALL STANDARD SPECIFICATIONS AND STANDARD DETAILS
SPECIFICATIONS TO GOVERN THIS PROJECT ARE THE R.I. STANDARD SPECIFICATIONS FOR ROAD
CONSTRUCTION, 1998 EDITION, WITH ALL
REVISIONS.
STANDARD DETAILS FOR THIS PROJECT ARE R.I. STANDARD DETAILS, 1998 EDITION, WITH ALL
REVISIONS.



REV.	NO.	DATE	BY	CHKD.	NO.	DATE	BY	CHKD.	NO.	DATE	BY	CHKD.
1		03/08/2022			2				3			

GENERAL NOTES:

- ALL CONSTRUCTION INDICATED ON THESE PLANS SHALL BE IN ACCORDANCE WITH:
 - THE 2004 EDITION (AMENDED MARCH 2018) OF, AND SUPPLEMENTS TO, THE RHODE ISLAND DEPARTMENT OF TRANSPORTATION STANDARD SPECIFICATIONS FOR ROAD AND BRIDGE CONSTRUCTION (IN STANDARD SPECIFICATIONS).
 - THE AMERICAN ASSOCIATION OF STATE HIGHWAY AND TRANSPORTATION ENGINEERS (AASHTO) LRFD BRIDGE CONSTRUCTION SPECIFICATIONS, 4TH EDITION, 2017, INCLUDING THE LATEST INTERIM REVISIONS.
 - THE SPECIFICATIONS ACCOMPANYING THESE PLANS.
 - IN CASE OF CONFLICT BETWEEN THE PLANS, SPECIFICATIONS OR MANUAL LISTED ABOVE, THE SPECIAL PROVISIONS OF THE SPECIFICATIONS ACCOMPANYING THESE PLANS SHALL GOVERN.
- ALL ELEVATIONS ARE REFERENCED TO THE NATIONAL GEODETIC VERTICAL DATUM OF NAVD 83.
- COORDINATES USED ON THESE PLANS ARE BASED ON THE STATEWIDE COORDINATE SYSTEM. THE NORTH AMERICAN DATUM OF 1983 (NAD 83 / 2011).
- DIMENSIONS, STATIONS, AND ELEVATIONS ARE SHOWN TO THE NEAREST ONE-HUNDRETH OF A FOOT OR ONE-EIGHTH OF AN INCH, EXCEPT STRUCTURAL STEEL DIMENSIONS WHICH ARE TO THE NEAREST ONE-SIXTEENTH OF AN INCH.
- ALL ANGLES ARE SHOWN TO THE NEAREST SECOND.
- TOPOGRAPHIC CONDITIONS WERE OBTAINED FROM AERIAL PHOTOGRAMMETRY. ACCURACY OF VERTICAL TOPOGRAPHY IS WITHIN ONE-HALF OF A FOOT.
- FOR BENCH MARKS AND TIES SEE HIGHWAY LOCATION PLANS.
- IT SHALL BE THE CONTRACTOR'S RESPONSIBILITY TO FIELD VERIFY ALL ELEVATIONS, DIMENSIONS, DETAILS, ANGLES, STRUCTURAL MEMBER SIZES, AND LAYOUTS AS SHOWN ON THESE PLANS. THIS PRIOR FIELD VERIFICATION IS ESPECIALLY PERTINENT FOR PRE-FABRICATED STRUCTURAL ITEMS AND WORK IN THE VICINITY OF UTILITIES.
- TEMPORARY PROTECTIVE SHIELDING:
 - DEBRIS SHIELDS SHALL BE PROVIDED AND INSTALLED TO PROTECT MOTORISTS, WATERWAYS, ETC. FROM ANY DEMOLITION OR CONSTRUCTION DEBRIS.
 - EXISTING DETAILS, DIMENSIONS AND ELEVATIONS PROVIDED IN THIS PLAN SET HAVE BEEN OBTAINED FROM THE ORIGINAL DRAWINGS AND SURVEY AND ARE NOT GUARANTEED.
- FIELD CONDITIONS MAY EXIST WHICH DEVIATE FROM THE TYPICAL AND THEORETICAL DIMENSIONS SHOWN ON THE PLANS. THE CONTRACTOR SHALL TAKE THE NECESSARY PRECAUTIONS TO ENSURE PROPER FIT OF THE FINISHED WORK AND SHALL ASSUME FULL RESPONSIBILITY FOR THEIR ACCURACY.
- THE CONTRACTOR SHALL TAKE THE PROPER PRECAUTION TO ENSURE THE STABILITY OF ALL STRUCTURAL ELEMENTS DURING ALL PHASED CONSTRUCTION UNTIL THE TOTAL STRUCTURE IS IN PLACE.
- THE CONTRACTOR SHALL CALL DIG SAFE AT LEAST 72 HOURS PRIOR TO STARTING THE WORK TO VERIFY LOCATIONS OF EXISTING UTILITIES.
- THE CONTRACTOR SHALL BE RESPONSIBLE FOR ALL COORDINATION WITH UTILITY OWNERS.
- ALL FOOTINGS SHALL BE APPROVED BY THE ENGINEER AS TO DIMENSIONS, ELEVATIONS, AND SUITABILITY OF FOUNDATION MATERIAL BEFORE THE PLACING OF CONCRETE.
- ALL WORKING POINTS ARE SHOWN AT THE CENTERLINES OF BEARINGS OF ABUTMENTS, UNLESS OTHERWISE NOTED.
- ALL ABUTMENTS AND WALLS ARE DRAWN LOOKING AT THE EXPOSED FACES.
- THE EXISTING UTILITIES SHOWN ON THE PLANS ARE APPROXIMATE AND WERE LOCATED USING THE BEST AVAILABLE INFORMATION. NO BUILDING SERVICE CONNECTIONS (ELECTRIC, TELEPHONE, GAS, WATER, SANITARY AND OTHERS) ARE SHOWN. THE CONTRACTOR IS TO ASSUME THAT SERVICES TO ALL BUILDINGS ARE PRESENT.
- BOTH FEDERAL AND STATE LAW (31, GENERAL LAW 39-1.2) REQUIRE NOTIFICATION OF APPROPRIATE UTILITY COMPANIES BEFORE DIGGING, TRENCHING, OR OTHER EARTH MOVING OPERATIONS. IT IS THE CONTRACTOR'S RESPONSIBILITY TO NOTIFY ALL UTILITY COMPANIES (INCLUDING THROUGH THE "DIG SAFE" PROGRAM) OF ANY EXISTING UTILITIES THAT MAY BE AFFECTED BY THE PROPOSED CONSTRUCTION. THE CONTRACTOR SHALL BE RESPONSIBLE FOR OBTAINING ALL NECESSARY PERMITS AND SHALL BE RESPONSIBLE FOR ANY DAMAGE TO EXISTING UTILITIES MARKED IN THE FIELD, OR AS A RESULT OF FAILING TO CONTACT THE APPROPRIATE UTILITY COMPANIES. SHALL BE REPAIRED BY THE CONTRACTOR AT THE CONTRACTOR'S EXPENSE. THE CONTRACTOR SHALL BE RESPONSIBLE FOR ANY DAMAGE TO EXISTING UTILITIES MARKED IN THE FIELD, OR AS A RESULT OF FAILING TO CONTACT THE APPROPRIATE UTILITY COMPANIES. SHALL BE REPAIRED BY THE CONTRACTOR AT THE CONTRACTOR'S EXPENSE. THE CONTRACTOR SHALL BE RESPONSIBLE FOR ANY DAMAGE TO EXISTING UTILITIES MARKED IN THE FIELD, OR AS A RESULT OF FAILING TO CONTACT THE APPROPRIATE UTILITY COMPANIES. SHALL BE REPAIRED BY THE CONTRACTOR AT THE CONTRACTOR'S EXPENSE.

DESIGN DATA

- DESIGN SPECIFICATIONS:
- THE AASHTO LRFD BRIDGE DESIGN SPECIFICATIONS, 8TH EDITION, 2020, INCLUDING ALL INTERIM REVISIONS.
 - THE AASHTO LRFD GUIDE SPECIFICATIONS FOR THE DESIGN OF PEDESTRIAN BRIDGES, 2009 INCLUDING ALL INTERIM REVISIONS.
 - THE RHODE ISLAND LRFD BRIDGE DESIGN MANUAL, 2007 EDITION INCLUDING ALL REVISIONS.
 - THE RHODE ISLAND LRFD BRIDGE DESIGN MANUAL, 2009 EDITION INCLUDING ALL REVISIONS.
 - THE 2004 EDITION (AMENDED MARCH 2018) OF, AND SUPPLEMENTS TO, THE RHODE ISLAND DEPARTMENT OF TRANSPORTATION STANDARD SPECIFICATIONS FOR ROAD AND BRIDGE CONSTRUCTION (IN STANDARD SPECIFICATIONS).

IN CASE OF CONFLICT, THE RHODE ISLAND LRFD BRIDGE DESIGN MANUAL SHALL GOVERN.

LOAD MODIFIERS

UNLESS NOTED OTHERWISE, THE LOAD MODIFIERS FOR THIS PROJECT ARE AS FOLLOWS:

- THE LOAD MODIFIER FOR DUCTILITY SHALL BE TAKEN AS 1.0 FOR ALL LIMIT STATES.
- THE LOAD MODIFIER FOR REDUNDANCY SHALL BE TAKEN AS 1.0 FOR ALL LIMIT STATES.
- THE LOAD MODIFIER FOR OPERATIONAL IMPORTANCE SHALL BE TAKEN AS 1.0 FOR ALL LIMIT STATES.

LOAD FACTORS

ALL LOAD FACTORS SHALL BE IN ACCORDANCE WITH THE AASHTO LRFD BRIDGE DESIGN SPECIFICATIONS, EXCEPT AS MODIFIED IN THE RHODE ISLAND BRIDGE DESIGN MANUAL.

- THE LOAD FACTOR FOR LIVE LOAD FOR THE EXTREME EVENT I LIMIT STATE SHALL BE TAKEN AS ZERO.
- THE LOAD FACTOR FOR DEAD LOAD FOR THE EXTREME EVENT I AND EXTREME EVENT II LIMIT STATE SHALL BE TAKEN AS 1.0.
- THE LOAD FACTOR FOR SETTLEMENT FOR ALL LIMIT STATES SHALL BE TAKEN AS 1.0.

LIVE LOADS

- THE DESIGN VEHICULAR LIVE LOAD SHALL BE THE H15-44 DESIGNATION ADJUSTED FOR THE DYNAMIC LOAD ALLOWANCE, MULTIPLE PRESENCE FACTOR AND PER RI TAC 0347.

WIND LOADING DESIGN DATA

- THE WIND LOADING DESIGN SHALL BE IN ACCORDANCE WITH THE AASHTO LRFD BRIDGE DESIGN SPECIFICATIONS, THE RHODE ISLAND LRFD BRIDGE DESIGN MANUAL, AND AS MODIFIED HEREIN.
- EXCEPT DURING CONSTRUCTION, THE DESIGN WIND PRESSURE IS BASED ON A DESIGN WIND SPEED OF 140 MPH.
- THE WIND PRESSURES DURING CONSTRUCTION SHALL BE AS SPECIFIED UNDER THE NOTES TITLED "GENERAL NOTES REGARDING TEMPORARY CONSTRUCTION CONDITIONS".

TRAFFIC DATA

NOT APPLICABLE

THERMAL DESIGN FORCE DATA

UNIFORM TEMPERATURE EFFECTS HAVE BEEN TAKEN INTO CONSIDERATION IN ACCORDANCE WITH THE PROCEDURE B OF THE AASHTO LRFD BRIDGE DESIGN SPECIFICATIONS. THE MINIMUM DESIGN TEMPERATURE SHALL BE -10 DEGREES F, AND THE MAXIMUM TEMPERATURE SHALL BE 105 DEGREES F.

SEISMIC DESIGN DATA

PER RIDOT LRFD BRIDGE MANUAL AND AASHTO LRFD BRIDGE DESIGN SPECIFICATIONS, EAST BAY BIKE PATH BRIDGES 083751 & 083851 SHALL MEET SEISMIC ZONE 1 DESIGN CRITERIA AND RFP ADDENDUM 3 CRITERIA.

FOUNDATION DESIGN DATA:

SPREAD FOUNDATIONS:

BEARING RESISTANCE FOR THE VARIOUS SHALLOW FOUNDATION TYPES ARE AS FOLLOWS:

LOCATION	TYPE OF BEARING MATERIAL	BEARING RESISTANCE (KSF)	
		STRENGTH LIMIT STATES (φ=0.45)	SERVICE LIMIT STATES (φ=1.0)
ABUTMENTS	UNDISTURBED NATURAL GRANULAR SOILS	7	3.2

DEEP FOUNDATIONS:

THE FACTORED AXIAL AND UPLIFT RESISTANCES FOR THE VARIOUS DEEP FOUNDATION TYPES ARE AS FOLLOWS:

LOCATION	TYPE	FACTORED AXIAL RESISTANCE (KIPS)	
		STRENGTH LIMIT STATES	EXTREME LIMIT STATES
BR. 083751 PIER	DMP	200	286
BR. 083851 PIER	DMP	220	315
BR. 083751 ABUTMENT	DMP	218	312

LOCATION	TYPE	FACTORED UPLIFT RESISTANCE (KIPS)	
		STRENGTH LIMIT STATES	EXTREME LIMIT STATES
BR. 083751 PIER	DMP	123	141
BR. 083851 PIER	DMP	127	145
BR. 083751 ABUTMENT	DMP	23	26.5

- THE FACTORED DESIGN AXIAL RESISTANCE AT EACH LOCATION IS THE LESSER VALUE OF THE FACTORED GEOTECHNICAL AND THE FACTORED STRUCTURAL RESISTANCES INDICATED.
- THE FACTORED GEOTECHNICAL AXIAL RESISTANCE FOR THE STRENGTH LIMIT STATE IS BASED ON THE NOMINAL AXIAL RESISTANCE AS DETERMINED USING A NOMINAL END RESISTANCE OF 3.6 KSF AND A RESISTANCE FACTOR OF 0.7 FOR COMPRESSION LOADING.
- THE FACTORED GEOTECHNICAL AXIAL RESISTANCE FOR THE EXTREME LIMIT STATE IS BASED ON THE NOMINAL AXIAL RESISTANCE AS DETERMINED USING A NOMINAL END RESISTANCE OF 3.6 KSF AND A RESISTANCE FACTOR OF 1.0 FOR COMPRESSION LOADING.
- THE FACTORED GEOTECHNICAL AXIAL RESISTANCE FOR THE STRENGTH LIMIT STATE IS BASED ON THE NOMINAL AXIAL RESISTANCE AS DETERMINED USING A NOMINAL BOND RESISTANCE OF 3.6 KSF AND A RESISTANCE FACTOR OF 0.7 (FOR TENSION).
- THE FACTORED GEOTECHNICAL AXIAL RESISTANCE FOR THE EXTREME LIMIT STATE IS BASED ON THE NOMINAL AXIAL RESISTANCE AS DETERMINED USING A NOMINAL BOND RESISTANCE OF 3.6 KSF AND A RESISTANCE FACTOR OF 0.8 (FOR TENSION).

NOTE:

MODULAR WALLS SHALL BE DESIGNED BY THE WALL SUPPLIER. THE CONTRACTOR SHALL SUBMIT FOR REVIEW AND APPROVAL DESIGN CALCULATIONS AND WORKING DRAWINGS SIGNED AND STAMPED BY A PROFESSIONAL ENGINEER REGISTERED IN THE STATE OF RHODE ISLAND.

EARLY RELEASE FOR CONSTRUCTION (ERC 1) APRIL 2023



RHODE ISLAND
DEPARTMENT OF TRANSPORTATION



1 Cedar Street
Providence, RI 02903
602.772.8100



ATMA
Pro Bridge Company

PROJECT NO. 083751 & 083851
BRIDGE NO. 083751 & 083851
ENVIRONMENTAL PERMITTING
SARASWATIMARRON
RHODE ISLAND

SCALE:

DESIGNED BY:	NO.	DATE	BY	NO.	DATE	BY
CHECKED BY:						
DATE:						
SHEET:	3			38		

EAST BAY BIKE PATH BRIDGE REPLACEMENT
(BARRING OX RIVER AND WARREN BRIDGES)

JOB SPECIFIC GENERAL NOTES 1

STRUCTURAL STEEL:

- AASHTO DESIGN

- REINFORCING STEEL:

- ## HARDWARE AND FASTENERS:

- COMPOSITE TOP RAIL:

- CONCRETE STRENGTHS:

- CLASS MC $\frac{3}{4}$ " F'C= 3,500 PSI @ 28 DAYS, F'C=5,000 PSI @ 56 DAYS

- CLASS A CONCRETE $\frac{3}{4}$ " F'C=3,000 PSI
PEDESTRIAN BRIDGE RAIL POSTS

1. CLASSES OF CONCRETE SHALL BE HIGH PERFORMANCE CLASS HP, CLASS MC AND CLASS XX, AS DESCRIBED THE RHODE ISLAND STANDARD SPECIFICATIONS FOR ROAD AND BRIDGE CONSTRUCTION AND THE SPECIAL PROVISIONS OF THE SPECIFICATIONS. REFER TO THE "MATERIALS" NOTES FOR CLASSES OF CONCRETE SPECIFIED FOR VARIOUS COMPONENTS.

2. THE CONTRACTOR MAY, AT THE APPROVAL OF THE ENGINEER, PROPOSE THE USE OF SECTION 608 SELF CONSOLIDATING CONCRETE (SCCC) CONTAINING THE REINFORCING STEEL. ALL CLASSES OF CONCRETE MIX DESIGN FOR SELF-CONSOLIDATING APPLICATIONS, THE MAXIMUM WATER-CEMENT RATIO FOR SCC SHALL BE 0.40.
3. ALL PORTLAND CEMENT CONCRETE SHALL BE AIR-ENTRAINED.
4. ALL REINFORCING STEEL SHALL BE GALVANIZED. ALL WIRE TIES AND MISCELLANEOUS GALVANIZED USED FOR PLACEMENT OF GALVANIZED REINFORCING SHALL ALSO BE GALVANIZED. HARDWARE COATING FOR REINFORCING STEEL SHALL CONFORM TO ASTM A757 CLASS 1.
5. ALL LAP SPICES NOT SHOWN ON THE PLANS SHALL BE LAPPED IN ACCORDANCE WITH THE AASHTO LRFD BRIDGE DESIGN SPECIFICATIONS FOR CLASS B LAP SPICES.

THE CONTRACTOR'S REINFORCING BAR FABRICATOR SHALL VERIFY THE CORRECTNESS IN PREPARING HIS ORDER LISTS AND BENDING DIAGRAMS. SHOP DRAWINGS FOR ALL REINFORCEMENT DETAILS AND SCHEDULE SHALL BE SUBMITTED TO THE ENGINEER IN SUFFICIENT TIME TO PERMIT CAREFUL CHECKING.

- ALL OTHER BARS 2*

- B. ALL ANCHOR BOLTS SHALL BE SET BY TEMPLATES PRIOR TO PLACEMENT OF CONCRETE UNLESS OTHERWISE INDICATED ON THE PLANS OR AUTHORIZED BY THE ENGINEER.

2. ALL EXPOSED EDGES AND REENTRANT CORNERS NOT OTHERWISE DETAILED ON THE PLANS SHALL HAVE A MINIMUM $\frac{3}{4}$ " CHAMFER.

4. ALL JOINT SEALANT SHALL BE POLYURETHANE, POLYURETHANE ELASTOMERIC, OR SILICONE SEALANT AS DESIGNATED ON THE PLANS. THE COLOR OF THE JOINT SEALANT, WHEN EXPOSED, SHALL BE NEUTRAL (LIGHT GRAY OR TAN). THE COLOR OF THE SEALANT, WHEN NOT EXPOSED, WILL BE AT THE DISCRETION OF THE CONTRACTOR.

6. EMBEDMENT LENGTHS FOR DRILLED AND GROUTED DOWELS SHALL BE IN ACCORDANCE WITH SECTION 819 OF THE RI STANDARD SPECIFICATIONS, UNLESS OTHERWISE INDICATED ON THE PLANS.

- CONSTRUCTED THAT THEY CAN BE REMOVED TO AT LEAST TWO INCHES BELOW THE EXPOSED SURFACE OF THE CONCRETE WITHOUT CAUSING DAMAGE TO THE CONCRETE SURFACE. SNAP TESTS MAY BE USED ONLY IF APPROVED BY THE ENGINEER. IF THE CONTRACTOR PROPOSES TO USE THEM, A CATALOG CUT AND OTHER NECESSARY INFORMATION MUST BE SUBMITTED TO THE ENGINEER TO DEMONSTRATE THAT THE TESTS WILL SNAP-OFF FAR ENOUGH INTO THE CONCRETE TO ALLOW FOR PROPER PATCHING. SNAP TESTS MUST PROVIDE ADEQUATE STRENGTH TO SUPPORT THE FORMS. ALL CAVITIES SHALL BE FILLED WITH AN APPROVED CEMENT MORTAR MEETING THE REQUIREMENTS OF ASTM C 928.

9. WATER STOPS ARE REQUIRED FOR HORIZONTAL AND VERTICAL CONSTRUCTION JOINTS IN ABUTMENTS AND WALLS WHEN EXPOSED TO BACKFILL EARTH MATERIAL. WATER STOPS SHALL BE INSTALLED AT THE LOCATIONS DETAILED ON THE PLANS, AT THE LOCATIONS AS SPECIFIED

10. UNLESS OTHERWISE DIMENSIONED ON THE PLANS, ALL REINFORCEMENT BENDS SHOWN ARE STANDARD HOOKS.

2. ANY METALLIC ELEMENTS THAT ARE TO BE LEFT IN PLACE AND NOT STATED HEREIN SHALL BE GALVANIZED. THIS INCLUDES, BUT IS NOT LIMITED TO REINFORCING STEEL, WIRE MESH, SNAP TIES, METAL TIES, ANCHORAGES FOR FORM WORK, SUPPORTS FOR MASS CONCRETE COOLING PIPES, ETC.



1 Cedar Street
Suite 400
Providence, RI 02903
401.272.8100

RHODE ISLAND
DEPARTMENT OF TRANSP

[illegible]

EAST BAY BIKE PATH BRIDGE REPLACEMENT
(BARRINGTON RIVER AND WARREN BRIDGES)
BRIDGE NO. 083751 & 083951
ENVIRONMENTAL PERMITTING
BARRINGTON/WARREN

JOB SPECIFIC GENERAL NOTES 2

STRUCTURAL STEEL NOTES

1. ALL STRUCTURAL STEEL SHALL BE IN ACCORDANCE WITH CODE 801.9801 PREFABRICATED MODULAR BRIDGE AND SECTION 824 OF THE RI STANDARD SPECIFICATIONS AS APPLICABLE.

TIMBER CONSTRUCTION NOTES

1. ALL TIMBER SHALL BE PRESSURE TREATED WOOD SHALL BE PRESSURE TREATED IN ACCORDANCE WITH THE AMERICAN WOOD PROTECTION ASSOCIATION (AWPA).
2. GROUP CONTACT POSTS SHALL BE TREATED WITH PRESERVATIVES TO THE REQUIREMENTS FOR GROUND CONTACT/PRESERVATION CONDITIONS (UC4A) IN ACCORDANCE WITH AWPA STANDARD U1 OR ICC-ES EVALUATION REPORTS.
3. ALL BOLTS SHALL BE ASTM A307 OR AS ALTERNATE A3125, GRADE A325.
4. ALL BOLTED CONNECTIONS SHALL INCLUDE WASHERS AT BOLT HEADS AND NUTS.
5. LAG SCREWS SHALL BE LOW CARBON STEEL, ASTM A307 OR BETTER.
6. ALL BOLTS, WASHERS AND OTHER HARDWARE SHALL BE GALVANIZED IN ACCORDANCE WITH AASHTO M232.
7. TIMBER WHICH AT THE DISCRETION OF THE ENGINEER IS SEVERELY WARPED, BOWED, SPLIT, OR SPLINTERED SHALL NOT BE USED.
8. RAILS AND RAIL CAPS SHALL BE CONTINUOUS OVER 1 POST MINIMUM BUT JOINTS IN RAILS AND RAIL CAPS SHALL BE STAGGERED AS SHOWN ON SHEET 35 TYPICAL ELEVATION OF PEDESTRIAN BRIDGE RAIL.
9. ALL TIMBER RAILING COMPONENTS SHALL BE TREATED WITH PRESERVATIVES TO THE REQUIREMENTS FOR AN ABOVE GROUND EXPOSE SERVICE CONDITION (UC3B) IN ACCORDANCE WITH AWPA STANDARD U1 OR ICC-ES EVALUATION REPORTS.
10. TREAT ALL CUT ENDS, HOLES, NOTCHES AND RECESSES WITH COPPER NAPHTHENE PRESERVATIVE.
11. ALL TIMBER SIZES ARE NOMINAL DIMENSION LUMBER UNLESS OTHERWISE NOTED.
12. LUMBER SUPPLIED SHALL MEET THE REQUIREMENTS OF "SECTION 806 OF THE STANDARD SPECIFICATIONS" AND THE 2018 NATIONAL DESIGN SPECIFICATIONS FOR WOOD CONSTRUCTION CONDITION AND TREAT STRUCTURAL TIMBER AND LUMBER IN ACCORDANCE WITH THE "2018 NATIONAL DESIGN SPECIFICATIONS FOR WOOD CONSTRUCTION".
13. GALVANIZED CARRIAGE BOLTS TO BE USED FOR ALL RAILING/POST CONNECTIONS.

DEMOLITION NOTES

1. DIMENSIONS ARE BASED ON ORIGINAL DESIGN DRAWINGS AND ARE FOR INFORMATION ONLY. THE CONTRACTOR SHALL VERIFY ALL DIMENSIONS IN THE FIELD PRIOR TO COMMENCEMENT OF CONSTRUCTION.
2. ALL ABUTMENTS SHALL REMAIN IN PLACE, SO AS NOT TO CAUSE ANY SHORELINE DISTURBANCES. ONCE CONSTRUCTION OF THE NEW BRIDGES HAS BEEN GRANTED, THE EXISTING ABUTMENTS MAY BE DEMOLISHED.
3. IF THE CONTRACTOR'S DEMOLITION OPERATIONS CAUSE ANY DAMAGE TO ACCESS ROUTES AND THE EXISTING SUBSTRATE LINE, THE CONTRACTOR SHALL IMMEDIATELY REPAIR THE DAMAGE TO THE SATISFACTION OF THE ENGINEER.
4. ALL DEMOLITION MATERIALS SHALL BE CONTAINED, COLLECTED, AND LEGALLY DISPOSED. IF DEBRIS FALLS TO THE RIVER, THE CONTRACTOR SHALL IMMEDIATELY REMOVE THE DEBRIS FROM THE WATER.
5. TIMBER PILES SHALL BE REMOVED IN THEIR ENTIRETY. STEEL PILES, THE STONE PIER IN THE BARRINGTON RIVER, AND ANY TIMBER PILES THAT BREAK MUST BE TRIMMED A MINIMUM OF 2'-0" BELOW THE RIVERBED SUBSTRATE LINE.
6. ALL DEMOLITION MATERIALS SHALL BE TAKEN FROM THE SITE TO AN APPROVED DESTINATION AS THE WORK PROGRESSES.
7. THE CONTRACTOR IS NOTIFIED THAT THE EXISTING PAINT SYSTEM OF THE STEEL AND THE TIMBER MAY CONTAIN TOXIC SUBSTANCES, SUCH AS LEAD, CHROMIUM, OR CREOSOTE, WHICH MAY REQUIRE SPECIAL HANDLING AND MAY BE HAZARDOUS WASTE WHEN REMOVED. PROTECT PERSONS AND ENVIRONMENT DURING REMOVAL OF THE EXISTING STEEL, IN ACCORDANCE WITH SECTION 826 OF THE STANDARD SPECIFICATIONS.
8. THE CONTRACTOR SHALL SUBMIT TO THE ENGINEER, IN WRITING, HIS PROPOSED METHOD OF DEMOLITION OPERATIONS. THIS SUBMISSION SHALL INCLUDE THE DEMOLITION PLANS, EQUIPMENT, SEQUENCE AND METHOD THE CONTRACTOR PROPOSED TO USE, IN DETAIL.
- THE DEMOLITION AND FALSEWORK SUBMITTALS MUST BE STAMPED BY A PROFESSIONAL ENGINEER REGISTERED IN THE STATE OF RHODE ISLAND. THE FURNISHING OF DEMOLITION AND FALSEWORK SUBMITTALS AND PMS SHALL NOT SERVE TO RELIEVE THE CONTRACTOR OF ANY PART OF HIS/HER RESPONSIBILITY FOR THE SAFETY OF THE WORK OR FOR THE SUCCESSFUL COMPLETION OF THE WORK.

REV	DATE	BY	DESCRIPTION	NO	DATE	BY	DESCRIPTION
1	1	1	1	1	1	1	1

EARLY RELEASE FOR
CONSTRUCTION
(EERC 1)
APRIL 2023

EAST BAY BIKE PATH BRIDGE REPLACEMENT (BARRINGTON RIVER AND WARREN BRIDGES)		BRIDGE NO. 060791 & 060851 BARRINGTON RIVER AND WARREN BRIDGES		RHODE ISLAND	
RHODE ISLAND		DEPARTMENT OF TRANSPORTATION		JOB SPECIFIC GENERAL NOTES 3	
SCALE:		REVISIONS		NO.	
NO.		DATE		BY	
1		1		1	
2		2		2	
3		3		3	
4		4		4	
5		5		5	
6		6		6	
7		7		7	
8		8		8	
9		9		9	
10		10		10	
11		11		11	
12		12		12	
13		13		13	
14		14		14	
15		15		15	
16		16		16	
17		17		17	
18		18		18	
19		19		19	
20		20		20	
21		21		21	
22		22		22	
23		23		23	
24		24		24	
25		25		25	
26		26		26	
27		27		27	
28		28		28	
29		29		29	
30		30		30	



1 Cedar Street
Providence, RI 02903
401.272.8100

NO.	DATE	REVISION	BY	DATE	NO.	DATE	REVISION	BY	DATE
1	01/01/2022	01/01/2022	01/01/2022	01/01/2022	01/01/2022	01/01/2022	01/01/2022	01/01/2022	01/01/2022

GENERAL NOTES REGARDING TEMPORARY CONSTRUCTION CONDITIONS:

- DESIGN WIND PRESSURES FOR CONSTRUCTION:
MINIMUM WIND PRESSURES TO BE USED BY THE CONTRACTOR FOR DESIGN DURING THE CONSTRUCTION CONTRACT (WITH THE EXCEPTION OF SIGNS) SHALL BE FROM THE FOLLOWING TABLE:

HEIGHT ABOVE GROUND	WIND PRESSURE (PSF)
UP TO 17'	33
OVER 17' AND UP TO 33'	37
OVER 33' AND UP TO 50'	41
OVER 50' AND UP TO 75'	44
OVER 75' AND UP TO 100'	47

TABLE NOTES:

A. APPLICATION OF THE TABULAR PRESSURE:

- BRIDGE COMPONENTS DURING CONSTRUCTION, PRIOR TO THE INSTALLATION OF THE FALSE WORK, SHALL BE DESIGNED TO WITHSTAND THE WIND PRESSURES SPECIFIED IN THE SPECIFICATION FOR BRIDGE TEMPORARY WORKS, EXCLUDING 3-DIMENSIONAL LATTICED OR TRUSS FRAMES OR TOWERS;
- TEMPORARY SHIELDING.

WIND PRESSURES FOR ALL OTHER STRUCTURES SHALL BE CALCULATED BASED ON ASCE DESIGN LOADS ON STRUCTURES DURING CONSTRUCTION, SE/ASCE 37-02 (ALL REFERENCES TO THE ASCE 7 IN THE SE/ASCE 37-02 PUBLICATION, SHALL BE THE LATEST REVISION OF ASCE 7). THE EXPOSURE CATEGORY SHALL BE C.

B. WHERE APPLICABLE HIGHER AMTRAK WIND REQUIREMENTS SHALL SUPERSEDE THESE REQUIREMENTS.

C. FOR STRUCTURES SITUATED ABOVE LIVE INTERSTATE TRAFFIC, THE TABULAR VALUES SHALL BE INCREASED BY 5 PSF.

2. ERECTION OF BRIDGE COMPONENTS:

FOR THE ERECTION OF STRUCTURES, THE FOLLOWING SHALL APPLY:

- THE CONTRACTOR SHALL SUBMIT AN ERECTION PLAN THAT PROVIDES COMPLETE DETAILS OF THE ERECTION SEQUENCE, INCLUDING: SCHEDULING, CRANE SELECTION, CRANE PLACEMENT, AND ASSUMED LOADS. THE CONTRACTOR SHALL STRESS DESIGN VARYING STAGES OF LIFTING. THIS APPLIES TO STRUCTURES OF ANY KIND, INCLUDING THE CRANE AND ALL LIFTING AND CONNECTING DEVICES SHALL BE DESIGNED TO WITHSTAND THE TOTAL PICK LOAD OF THE CRANE AND ALL LIFTING AND CONNECTING DEVICES. THE CONTRACTOR SHALL SUBMIT A SAFETY PLAN TO THE ENGINEER FOR REVIEW AND APPROVAL. THE CONTRACTOR SHALL BE REQUIRED TO PERFORM DAILY INSPECTIONS OF THE ERECTED GIRDERS UNTIL THE BRIDGE DECK IS COMPLETELY POURED.
- A REGISTERED PROFESSIONAL ENGINEER, LICENSED IN THE STATE OF RHODE ISLAND, WILL BE REQUIRED TO STAMP THE CONTRACTOR'S ERECTION PLAN.
- THE CONTRACTOR'S PROFESSIONAL ENGINEER WILL BE REQUIRED TO INSPECT AND PROVIDE WRITTEN APPROVAL OF INSTALLATION, PRIOR TO ALLOWING VEHICLES OR PEDESTRIANS ON OR BELOW THE BRIDGE DECK. THE CONTRACTOR SHALL SUBMIT ALL CHANGES TO THE CONTRACTOR'S ERECTION PLAN, ADDITIONALLY, ALL PROPOSED CHANGES MUST BE SUBMITTED TO RIDOT FOR REVIEW AND APPROVAL PRIOR TO IMPLEMENTATION.
- A MANDATORY PRE-ERECTION CONFERENCE WILL BE HELD AT LEAST TWO WEEKS PRIOR TO THE START OF THE GIDER INSTALLATION TO DISCUSS THE PLAN AND PROCEDURES. THE CONTRACTOR'S PROFESSIONAL ENGINEER AND ERECTION SUBCONTRACTOR WILL BE REQUIRED TO ATTEND. THE CONTRACTOR SHALL SUBMIT A PRE-ERECTION CONFERENCE MINUTES TO THE ENGINEER AND THE DESIGN CONSULTANT. BASED UPON DISCUSSIONS AT THE PRE-ERECTION CONFERENCE, THE CONTRACTOR SHALL BE REQUIRED TO SUBMIT A REVISION TO THE ERECTION PLAN TO THE ENGINEER FOR REVIEW AND APPROVAL.
- THE CONTRACTOR WILL BE REQUIRED TO PERFORM DAILY INSPECTIONS OF THE ERECTED GIRDERS UNTIL THE BRIDGE DECK IS COMPLETELY POURED.

CONSTRUCTION NOTES:

- THE CONTRACTOR IS RESPONSIBLE FOR THE IMPLEMENTATION, CONSTRUCTION, OPERATION AND SAFETY OF ALL EQUIPMENT AND PROCEDURES.
- THE CONTRACTOR SHALL SUBMIT WORKING DOCUMENTS SHOWING PROPOSED METHODS OF LIFTING, SEQUENCING OF LIFTING, LOCATION OF CRANES, AND THE LOCATION OF CRANES. THE CONTRACTOR SHALL SUBMIT WORKING DOCUMENTS SHOWING PROPOSED METHODS OF LIFTING, SEQUENCING OF LIFTING, LOCATION OF CRANES, AND THE LOCATION OF CRANES. THE CONTRACTOR SHALL SUBMIT WORKING DOCUMENTS SHOWING PROPOSED METHODS OF LIFTING, SEQUENCING OF LIFTING, LOCATION OF CRANES, AND THE LOCATION OF CRANES.
- COORDINATE ALL CONSTRUCTION ACTIVITIES WITHIN THE WORKING AREA WITH RIDOT REGARDING UTILITIES, PROTECTION OF TRAFFIC AND SCHEDULE.
- THE CONTRACTOR SHALL EXERCISE EXTREME CARE TO AVOID DAMAGE TO EXISTING STRUCTURES. ALL STRUCTURES DAMAGED AS A RESULT OF THE CONTRACTOR'S OPERATION SHALL BE REPAIRED TO THE SATISFACTION OF THE ENGINEER.
- ALL SHOP DRAWINGS SHALL BE SUBMITTED TO THE ENGINEER IN SUFFICIENT TIME TO PERMIT CAREFUL CHECKING AS NOT TO DELAY THE PROJECT.
- ALL RIGGING IS TO BE IN EXCELLENT WORKING CONDITION.
- UNLOADED CRANES ARE ALLOWED TO TRAVEL IN THE WORKING AREA.
- CRANE DELIVERY LOCATIONS MAY VARY AS LONG AS MAXIMUM CRANE RADIUS IS NOT EXCEEDED.
- TEMPORARY EXCAVATION SUPPORT SYSTEM SHALL BE DESIGNED, FURNISHED AND INSTALLED BY THE CONTRACTOR AND SUBMITTED TO THE ENGINEER FOR REVIEW AND APPROVAL PRIOR TO THE START OF ANY EXCAVATION.
- CONTRACTOR SHALL SECURE ALL WORK AREAS AT ALL TIMES TO PREVENT UNAUTHORIZED ACCESS.
- STOCKPILED SOIL SHALL BE NOT CLOSER THAN 30 FEET FROM PIERS, WALLS AND ABUTMENTS.

UTILITY NOTES:

- EXISTING UTILITIES SHOWN ON THE PLANS ARE APPROXIMATE AND WERE LOCATED USING THE BEST AVAILABLE INFORMATION. NO BUILDING SERVICE CONNECTIONS (ELECTRIC, TELEPHONE, GAS, WATER, SANITARY AND OTHERS) ARE SHOWN. THE CONTRACTOR IS TO ASSUME THAT SERVICES TO ALL BUILDINGS ARE PRESENT.
- BOTH FEDERAL AND STATE LAW (RI GENERAL LAW 39-1-2) REQUIRE NOTIFICATION OF APPROPRIATE UTILITY COMPANIES BEFORE ANY EXCAVATION, BORING, BACKFILLING, GRADING, LANDSCAPING, OR OTHER EARTH MOVING OPERATION. THE CONTRACTOR'S RESPONSIBILITY TO NOTIFY ALL UTILITIES, BOTH UNDERGROUND AND OVERHEAD, "DIG SAFE" PROGRAM) TO ENSURE THAT ALL UTILITIES, BOTH UNDERGROUND AND OVERHEAD, HAVE BEEN MARKED BEFORE COMMENCEMENT OF SUCH WORK. THE CONTRACTOR SHOULD UNDERSTAND THAT NOT ALL UTILITIES SUBSCRIBE TO THE "DIG SAFE" PROGRAM. ANY DAMAGE TO EXISTING UTILITIES MARKED IN THE FIELD, OR AS A RESULT OF FAILING TO CONTACT THE APPROPRIATE UTILITY COMPANIES, SHALL BE REPAIRED OR REPLACED (AS DEEMED APPROPRIATE BY THE STATE AND/OR THE IMPACTED UTILITY COMPANY) AT NO ADDITIONAL COST TO THE STATE.
- CONSTRUCTION EQUIPMENT OR PERSONNEL SHALL FOLLOW OSHA REGULATION IN REGARDS TO MINIMUM CLEARANCE TO ENERGIZED OVERHEAD LINES.
- UNDERGROUND UTILITY LINES MAY BE IN CONFLICT WITH REQUIRED TEMPORARY OR PERMANENT CONSTRUCTION, OR THE EQUIPMENT NECESSARY TO PERFORM THIS REQUIRED CONSTRUCTION. TO BE RELOCATED. THE CONTRACTOR'S METHOD OF CONSTRUCTION, THESE UTILITIES MAY NEED TO BE RELOCATED. THE CONTRACTOR SHALL BE RESPONSIBLE FOR THE RELOCATION OF ALL PERMANENT LOCATIONS WHICH MAY BE OTHER THAN UNDERGROUND. THE CONTRACTOR SHALL BE RESPONSIBLE FOR THE RELOCATION OF ALL PERMANENT LOCATIONS WHICH MAY BE OTHER THAN UNDERGROUND. THE CONTRACTOR SHALL BE RESPONSIBLE FOR THE RELOCATION OF ALL PERMANENT LOCATIONS WHICH MAY BE OTHER THAN UNDERGROUND. THE CONTRACTOR SHALL BE RESPONSIBLE FOR THE RELOCATION OF ALL PERMANENT LOCATIONS WHICH MAY BE OTHER THAN UNDERGROUND.

TEMPORARY CONSTRUCTION STRUCTURAL STEEL NOTES:

- STRUCTURAL STEEL SHAPES AND PLATES SHALL CONFORM TO THE LATEST PROVISIONS OF THE ASTM DESIGNATION A 709 GRADE 36 OR AS DESIGNATED ON THE PLANS.
- HIGH STRENGTH STEEL BOLTS SHALL CONFORM TO ASTM DESIGNATION A F3125 GRADE A325. THE CONTRACTOR SHALL REFER TO SECTION 824 "CONNECTIONS USING HIGH STRENGTH BOLTS" OF THE STATE OF RHODE ISLAND STANDARD SPECIFICATIONS FOR ROAD AND BRIDGE CONSTRUCTION (1997) FOR MATERIAL AND INSTALLATION REQUIREMENTS. ALL HIGH STRENGTH BOLTS SHALL BE 7/8" DIAMETER ON 15/16" DIAMETER HOLES UNLESS OTHERWISE NOTED.
- WASHERS MEETING ASTM DESIGNATION F 436 ARE TO BE USED OVER ALL PILES THAT ARE MORE THAN 1/16" IN DIAMETER GREATER THAN THE BOLT DIAMETER AND UNDER ALL PORTS TURNED DURING ASSEMBLY.
- WELDING SHALL BE IN ACCORDANCE WITH THE LATEST STRUCTURAL WELDING CODE AWS/AASHTO/AWS D1.5-2015 (INCLUDING ALL INTERIMS TO DATE) AND APPLICABLE SUPPLEMENTAL AWS PUBLICATIONS. ALL SHOP CONNECTIONS SHALL BE WELDED AND ALL FIELD CONNECTIONS SHALL BE BOLTED UNLESS OTHERWISE NOTED.
- WELDING ELECTRODES SHALL HAVE THE SAME CORROSION RESISTANCE AS THE BASE METAL.
- NO SHOP FILLET WELD SHALL BE LESS THAN 3/16", UNLESS OTHERWISE SPECIFIED.
- PRIOR TO FABRICATION, ALL MATERIALS SHALL BE BLAST CLEANED TO AT LEAST SSPC-SP6 TO REMOVE ALL OIL, DIRT, GREASE, MILL SCALE AND OTHER DELETERIOUS MATERIALS FROM THE SURFACES OF THE STEEL TO BE FABRICATED.
- WHEN STEEL DIE STAMPS ARE USED TO IDENTIFY PIECES AND MEMBERS, FABRICATORS SHALL UTILIZE LOW STRESS STAMPS.


DESIGN TIDAL INFORMATION

UNITED STATES ARMY CORPS ENGINEERS HIGH TIDE LINE (USACE HTL) =	EL. 3.78
MEAN HIGH WATER (MHW) =	EL. 2.12
MEAN LOW WATER (MLW) =	EL. -1.90
MEAN LOW LOW WATER (MLLW) =	EL. -2.47
100 YEAR FLOOD (BARRINGTON RIVER) =	EL. 9.70
100 YEAR FLOOD (PALMER RIVER) =	EL. 8.20

THE CONTRACTOR SHALL NOTE THAT HIGHER AND LOWER TIDES ARE POSSIBLE.


EARLY RELEASE FOR CONSTRUCTION (ERC 1)
APRIL 2023

		RHODE ISLAND DEPARTMENT OF TRANSPORTATION		EAST BAY BIKE PATH BRIDGE REPLACEMENT (BARRINGTON RIVER AND WARREN BRIDGES) BRIDGE NO. 0037F1 & 0038F1 ENVIRONMENTAL PERMITTING		JOB SPECIFIC GENERAL NOTES 4	
SCALE:		REVISION BY:		NO. DATE BY NO. DATE BY		RIDOT JOB NO. 2022-0000000000	
CHECKED BY:		DATE:		SHEET:		OF:	

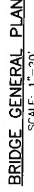


WORKING POINTS

REV	DATE	BY	CHKD	APPD	DESCRIPTION
1	08/08/2022				

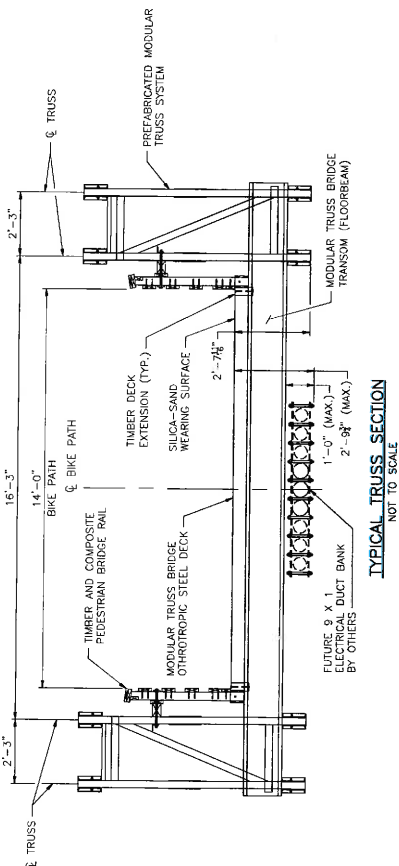

NOTES:

1. FUTURE DUCT BANK AND SUPPORTS BY OTHERS, DRILLING AND WELDING TO THE MODULAR TRUSS BRIDGE TRANSOM BEAMS OR OTHERS SHALL BE THE RESPONSIBILITY OF THE USER. SUCH WORK IS NOT ALLOWED WITHOUT PERMISSION FROM THE MODULAR TRUSS BRIDGE MANUFACTURER.

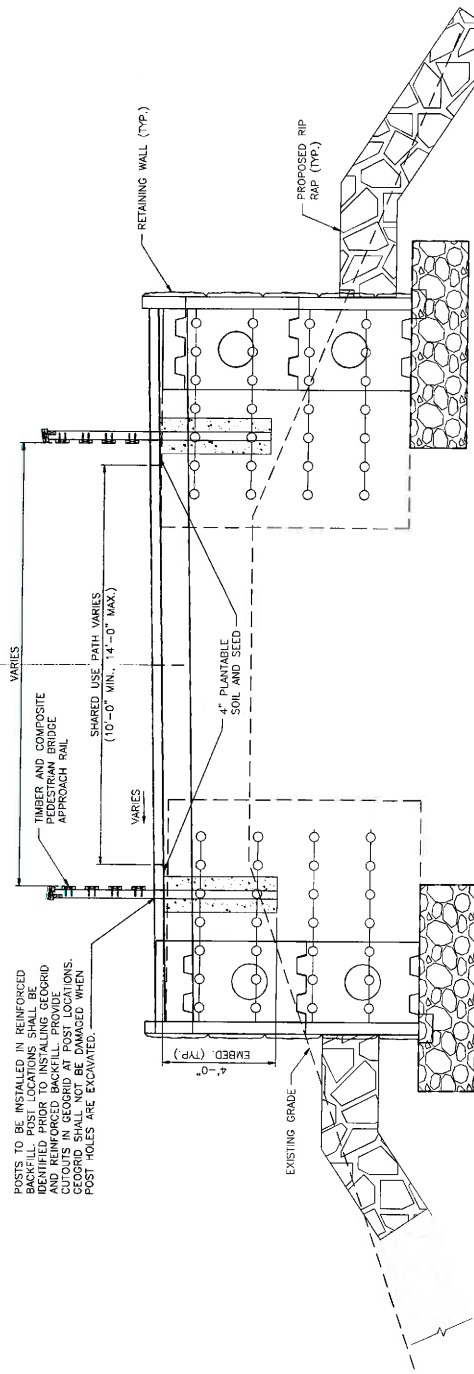

PROPOSED APPROACH SECTION
NOT TO SCALE

RHODE ISLAND
DEPARTMENT OF TRANSPORTATION

EAST BAY BIKE PATH BRIDGE REPLACEMENT
(BARRINGTON RIVER AND WARREN BRIDGES)

BRIDGE NO. 083751 & 083851
ENVIRONMENTAL PERMITTING

BRIDGE NO. 083751
BARRINGTON WARREN

BR. 083751 BRIDGE TYPICAL SECTION

SCALE:

NO.	DATE	BY	CHKD	APPD
1	08/08/2022			

DESIGNED BY:
CHECKED BY:
DATE:
PROJECT:
OFF:
SHEET: 8 OF 38

AETNA
PRO Bridge Company

1 Cedar Street
Providence, RI 02903
401.272.8100

2777024
Rhode Island Department of Transportation



RECEIVED
2/17/2024
CONVALL BRIDGE COLLEGE
MANASSAS CAMPUS



Rhode Island
Department of Transportation

EAST BAY BIKE PATH BRIDGE REPLACEMENT
(BARRINGTON RIVER AND WARREN BRIDGES)
BRIDGE NO. 083751 & 083851
ENVIRONMENTAL PERMITTING


REVISIONS		REVISIONS	
NO.	DATE	NO.	DATE
1	2/1/24		
2			
3			

PROJECT MODIFICATIONS SINCE OCTOBER 24, 2023 CRMC FULL COUNCIL PUBLIC HEARING.	DESIGNED BY: CHECKED BY: DATE: SHEET: OF:
--	---

BR. 083751 PROFILE


REV.	DATE	BY	CHKD.	APPD.	REVISION
1	11/11/2022	BR	BR	BR	BR

R-1

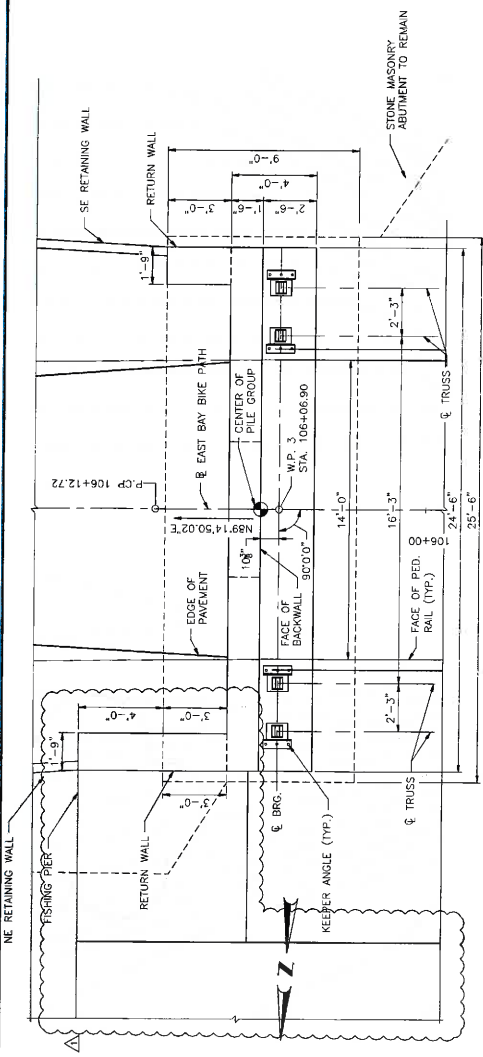

EAST ABUTMENT PLAN

SCALE: 3/8"=1'-0"

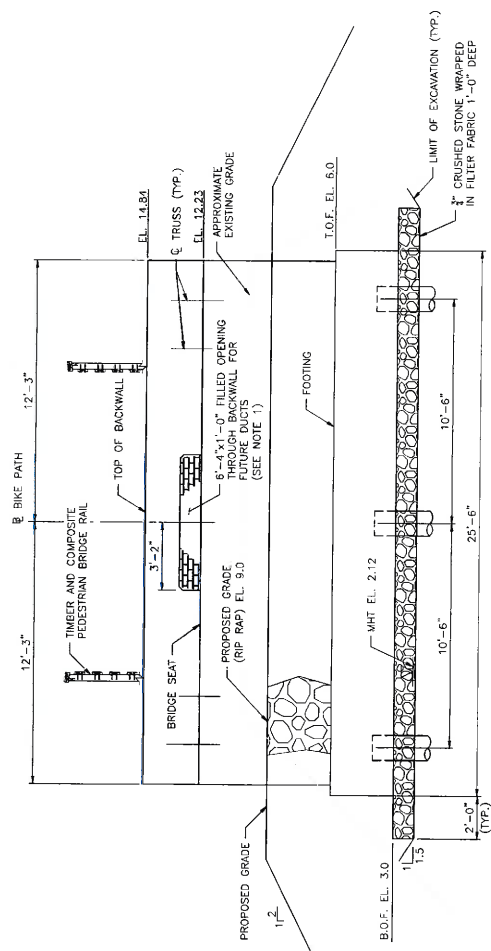


EAST ABUTMENT ELEVATION

SCALE: 3/8"=1'-0"


- NOTE:
1. FILL FUTURE DUCT OPENING WITH CLAY BUILDING BRICK (M.D.04.03.1) FOR FULL THICKNESS OF BACKWALL.
 2. SEE BR 083751 EAST ABUTMENT PLAN AND ELEVATION FOR BACKWALL OPENING DETAILS.

			EAST BAY BIKE PATH BRIDGE REPLACEMENT (BARRINGTON RIVER AND WARREN BRIDGES) BRIDGE NO. 083751 & 083871 ENVIRONMENTAL PERMITTING										
			SCALE:										
PROJECT NO. 2022-0001 PROJECT NAME: EAST BAY BIKE PATH BRIDGE REPLACEMENT PROJECT LOCATION: BARRINGTON RIVER AND WARREN BRIDGES PROJECT DATE: 10/20/2022 PROJECT STATUS: PUBLIC FULL CONSTRUCTION		REVISIONS <table border="1"> <tr> <th>NO.</th> <th>DATE</th> <th>BY</th> <th>CHKD.</th> <th>APPD.</th> </tr> <tr> <td>1</td> <td>3/7/24</td> <td>BR</td> <td>BR</td> <td>BR</td> </tr> </table>		NO.	DATE	BY	CHKD.	APPD.	1	3/7/24	BR	BR	BR
NO.	DATE	BY	CHKD.	APPD.									
1	3/7/24	BR	BR	BR									
PROJECT NO. 2022-0001 PROJECT NAME: EAST BAY BIKE PATH BRIDGE REPLACEMENT PROJECT LOCATION: BARRINGTON RIVER AND WARREN BRIDGES PROJECT DATE: 10/20/2022 PROJECT STATUS: PUBLIC FULL CONSTRUCTION		BR 083751 EAST ABUTMENT PLAN AND ELEVATION SCALE: 3/8"=1'-0"											


FED. ROAD DIST. NO.	STATE	FEDERAL AID PROJECT NO.	FISCAL YEAR	SHEET NO.	TOTAL SHEETS
1	RI		2022	14	38

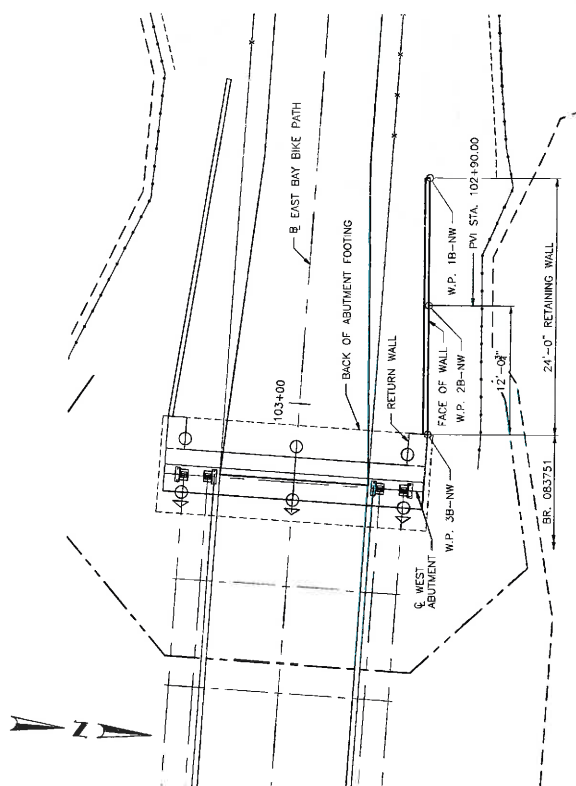

NORTHWEST RETAINING WALL PLAN
SCALE: 3/16"=1'-0"

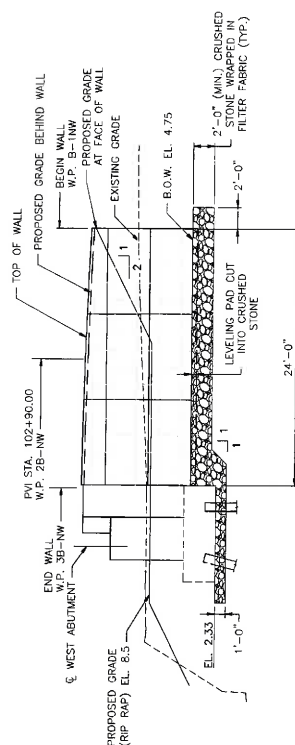

NORTHWEST RETAINING WALL ELEVATION
SCALE: 3/16" = 1'-0"

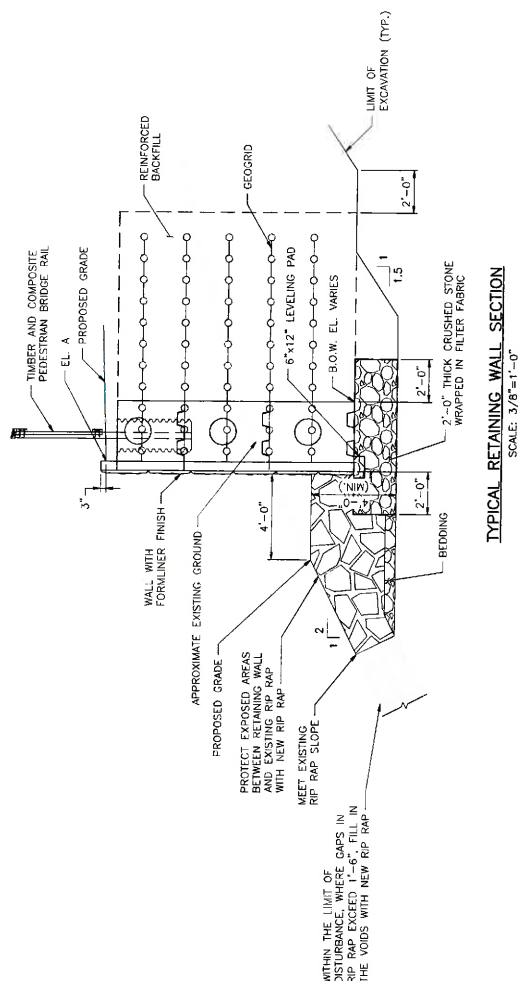

TYPICAL RETAINING WALL SECTION
SCALE: 3/8"=1'-0"

NORTHWEST RETAINING WALL					
WORKING POINT	STATION	OFFSET	NORTHING	EASTING	EL. A*
W.P. 1B-NW	102+78.09	-10.69	239491.7362	383679.9507	14.02
W.P. 2B-NW	102+90.00	-11.47	238492.6676	383691.8458	14.50
W.P. 3B-NW	103+02.04	-12.25	238493.6093	383703.6737	14.77

* ELEVATION IS GIVEN AT PROPOSED GRADE BEHIND WALL. SEE TYPICAL RETAINING WALL SECTION THIS SHEET.

NOTES:

1. REFER TO HIGHWAY PLANS FOR COMPLETE GEOMETRY AND CURVE DATA FOR BIKE PATH.
2. PANEL SLIP JOINTS ARE NOT SHOWN. SLIP JOINT LOCATION AND QUANTITY SHALL BE DETERMINED BY THE WALL MANUFACTURER.

RHODE ISLAND
DEPARTMENT OF TRANSPORTATION




1 Cedar Street
Suite 400
Providence, RI 02903
401.272.8100

EAST BAY BIKE PATH BRIDGE REPLACEMENT
(BARRINGTON RIVER AND WARREN BRIDGES)
BRIDGE NO. 033751 & 053951
ENVIRONMENTAL PERMITTING
BARRINGTONWARREN

BR. 083751 RETAINING WALL PLAN 1

[illegible]

PROJECT NO.	BRD-083751(002)	DATE	2022	SHEET NO.	15	TOTAL SHEETS	38
-------------	-----------------	------	------	-----------	----	--------------	----

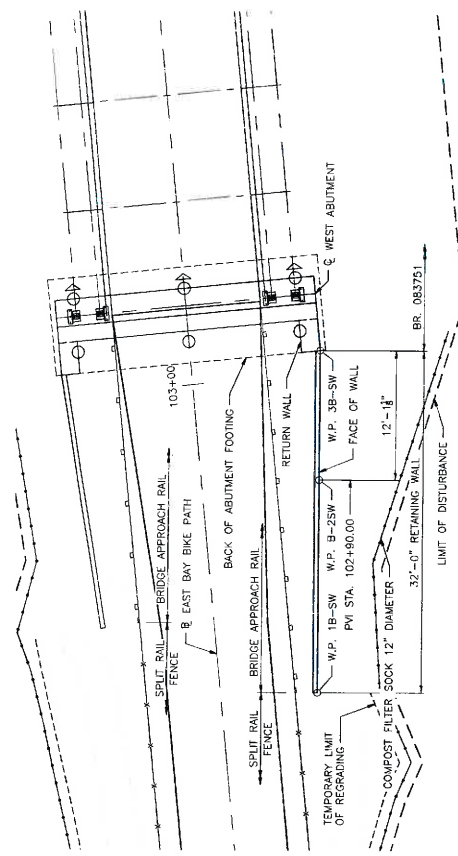


SOUTHWEST RETAINING WALL PLAN
SCALE: 3/16"=1'-0"

SOUTHWEST RETAINING WALL					
WORKING POINT	STATION	OFFSET	NORTHING	EASTING	EL. A*
W.P. 1B-SW	102+70.19	9.09	238471.8537	383972.3115	13.65
W.P. 2B-SW	102+90.00	11.06	238470.1482	383992.1417	14.51
W.P. 3B-SW	103+02.04	12.25	238469.1114	383704.1960	14.77

* ELEVATION IS GIVEN AT PROPOSED GRADE BEHIND WALL. SEE TYPICAL RETAINING WALL SECTION.

NOTES:


- SEE BR. 083751 RETAINING WALL 1 SHEET FOR TYPICAL RETAINING WALL SECTION AND NOTES.

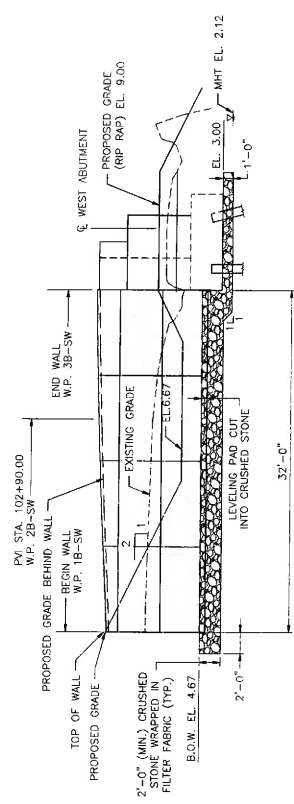


SOUTHWEST RETAINING WALL ELEVATION
SCALE: 3/16"=1'-0"

			EAST BAY BIKE PATH BRIDGE REPLACEMENT (BARRINGTON RIVER AND WARREN BRIDGES) BRIDGE NO. 083751 & 083851 ENVIRONMENTAL PERMITTING BARRINGTON/WARREN RHODE ISLAND BR. 083751 RETAINING WALL PLAN 2												
<table border="1"> <tr> <th colspan="4">SCALE:</th> </tr> <tr> <td>DESIGNED BY:</td> <td>CHECKED BY:</td> <td>DATE:</td> <td>DATE:</td> </tr> <tr> <td>DATE:</td> <td>DATE:</td> <td>DATE:</td> <td>DATE:</td> </tr> </table>				SCALE:				DESIGNED BY:	CHECKED BY:	DATE:	DATE:	DATE:	DATE:	DATE:	DATE:
SCALE:															
DESIGNED BY:	CHECKED BY:	DATE:	DATE:												
DATE:	DATE:	DATE:	DATE:												

REV	DATE	BY	CHKD	APPD	DESCRIPTION	SHEET NO.	TOTAL SHEETS
1	11/15/2022	BR	BR	BR	BRIDGE NO. 083751	18	38

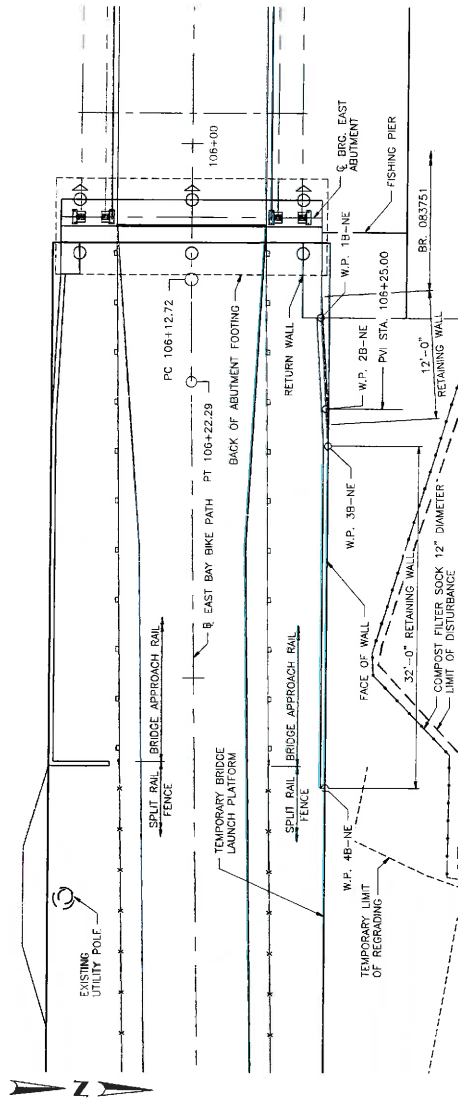

NORTHEAST RETAINING WALL PLAN
SCALE: 3/16"=1'-0"

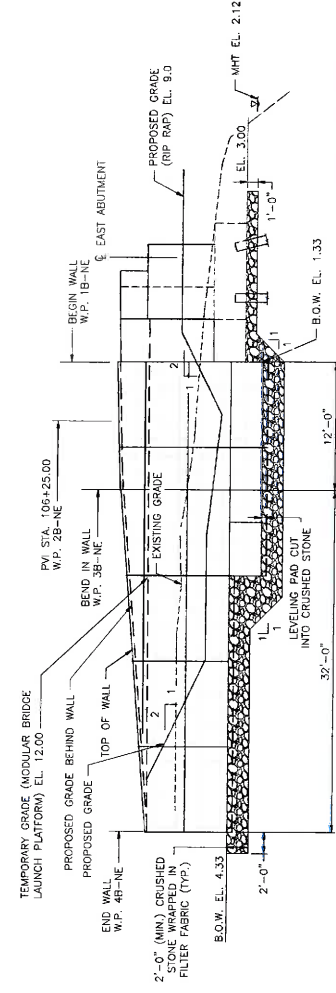

NORTHEAST RETAINING WALL ELEVATION - DEVELOPED
SCALE: 3/16"=1'-0"

WORKING POINT	STATION	OFFSET	NORTHING	EASTING	EL. A*
W.P. 1B-NE	106+14.30	-12.25	238497.7121	384016.0762	14.73
W.P. 2B-NE	106+25.00	-12.79	238498.5088	384026.5060	14.45
W.P. 3B-NE	106+26.45	-12.86	238498.6180	384026.0418	14.40
W.P. 4B-NE	106+56.45	-12.35	238499.0365	384060.0403	11.82

* ELEVATION IS GIVEN AT PROPOSED GRADE BEHIND WALL. SEE TYPICAL RETAINING WALL SECTION.

NOTES:

- SEE BR. 083751 RETAINING WALL 1 SHEET FOR TYPICAL RETAINING WALL SECTION AND NOTES.


RHODE ISLAND
DEPARTMENT OF TRANSPORTATION

RHODE ISLAND
DEPARTMENT OF TRANSPORTATION


1 Cedar Street
Providence, RI 02903
801.772.8100

BRIDGE NO. 083751 & 083851
BARRINGTON RIVER AND WARREN BRIDGES
ENVIRONMENTAL PERMITTING
BR. 083751 RETAINING WALL PLAN 3

REV	DATE	BY	CHKD	APPD	NO.	SHEET	TOTAL
1	1	BR	BR	BR	083751	17	38

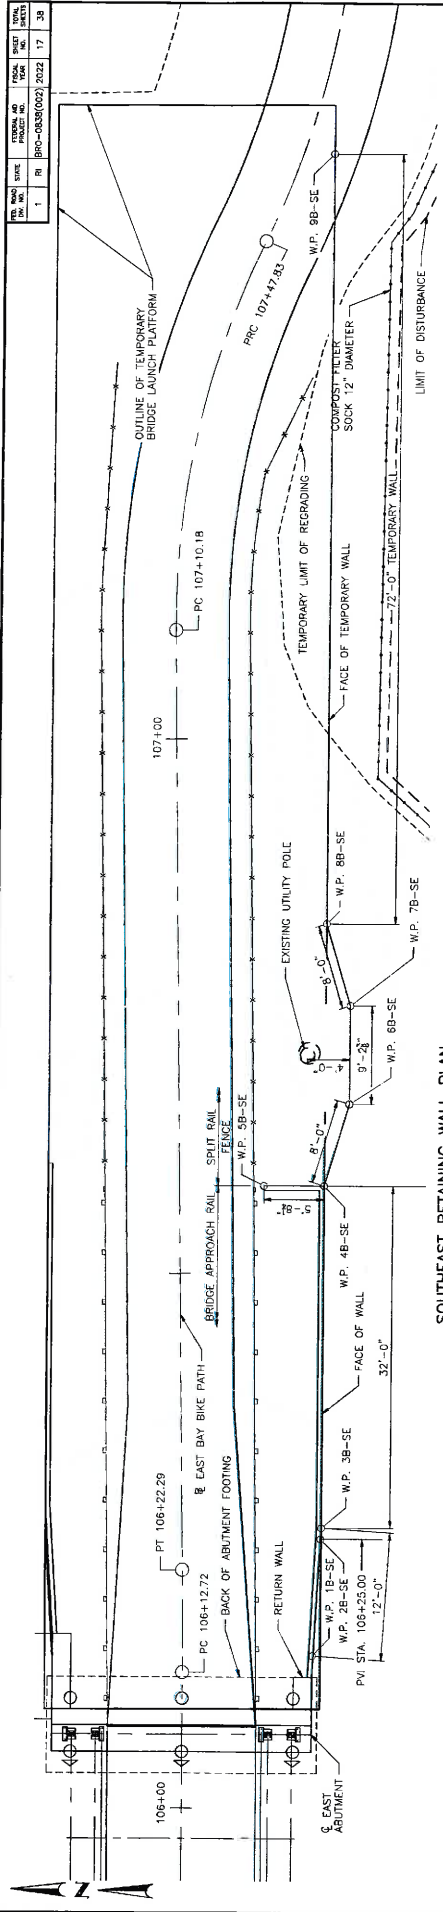

SOUTHEAST RETAINING WALL PLAN
SCALE: 3/16"=1'-0"

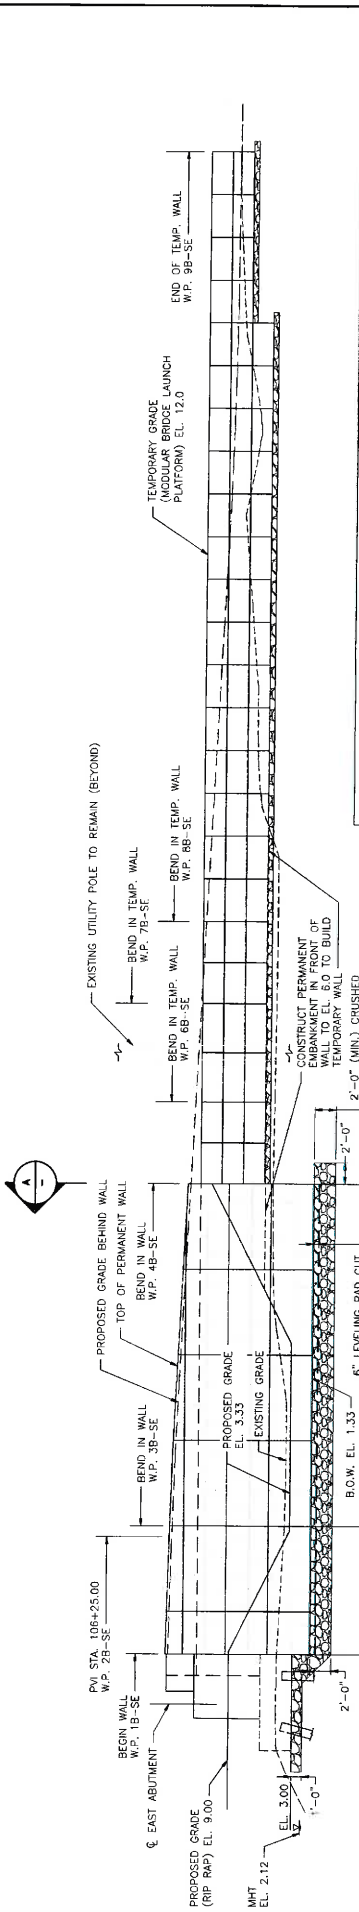

SOUTHEAST RETAINING WALL ELEVATION
SCALE: 3/16"=1'-0"

WORKING POINT	STATION	OFFSET	NORTHING	EASTING	EL. A*
W.P. 1B-SE	106+14.24	12.25	238473.2138	364016.3985	14.73
W.P. 2B-SE	106+25.00	13.06	238472.6894	364027.3479	14.43
W.P. 3B-SE	106+26.04	13.14	238472.6179	364028.3833	14.40
W.P. 4B-SE	106+58.03	13.05	238473.0383	364060.3806	12.94
W.P. 5B-SE	106+58.12	7.96	238478.7268	364060.3058	12.94
W.P. 6B-SE	106+55.65	16.08	238470.8290	364068.0694	12.00**
W.P. 7B-SE	106+74.85	16.23	238470.8500	364077.2620	12.00**
W.P. 8B-SE	106+82.54	14.04	238473.3619	364084.8929	12.00**
W.P. 9B-SE	107+57.66	2.75	238474.3079	364156.8867	12.00**

* ELEVATION IS TAKEN AT TOP OF PROPOSED GRADE BEHIND WALL. SEE TYPICAL RETAINING WALL SECTION.
** THIS GRADE IS TEMPORARY FOR THE LAUNCHING PLATFORM.

NOTES:
1. SEE BR. 083751 RETAINING WALL 1 SHEET FOR TYPICAL RETAINING WALL SECTION AND NOTES.

RHODE ISLAND
DEPARTMENT OF TRANSPORTATION

EAST BAY BIKE PATH BRIDGE REPLACEMENT
(BARRINGTON RIVER AND MARSHES BRIDGES)
BRIDGE NO. 083751 & 083851
ENVIRONMENTAL PERMITTING
BARRINGTON TOWN

BR. 083751 RETAINING WALL PLAN 4

1 Cedar Street
Providence, RI 02903
401.222.8700

SCALE: 3/16"=1'-0"

SECTION
SCALE: 3/16"=1'-0"



DROP EDGE DETAIL
SCALE: NOT TO SCALE

--	--

--	--

1


NOTES:

1. ALL PIER CAP SURFACES SHALL RECEIVE A FILM-FORMING SEALER PROTECTIVE COATING.
2. ONCE PILES ARE INSTALLED, SUBMIT AS-BUILT LOCATIONS TO DESIGN ENGINEER TO VERIFY AND APPROVE THE LOCATIONS.


 Aetna Bridge Company		 1 Cedar Street Suite 400 Waltham, MA 02453 401.272.8100		 Rhode Island Department of Transportation		<table border="1"> <tr> <td colspan="2">SCALE:</td> <td colspan="2">CHECKED BY:</td> <td colspan="2">DESIGNED BY:</td> </tr> <tr> <td>NO.</td> <td>DATE</td> <td>BY</td> <td>NO.</td> <td>DATE</td> <td>BY</td> </tr> <tr> <td>18</td> <td></td> <td></td> <td>19</td> <td></td> <td></td> </tr> <tr> <td colspan="2">SHEET:</td> <td colspan="2">OF:</td> <td colspan="2"></td> </tr> </table>		SCALE:		CHECKED BY:		DESIGNED BY:		NO.	DATE	BY	NO.	DATE	BY	18			19			SHEET:		OF:			
SCALE:		CHECKED BY:		DESIGNED BY:																											
NO.	DATE	BY	NO.	DATE	BY																										
18			19																												
SHEET:		OF:																													
EAST BAY BIKE PATH BRIDGE REPLACEMENT (BARRINGTON RIVER AND WASHNETT CREEK) BRIDGE NO. 083751 & 083851 BARRINGTON WARREN ENVIRONMENTAL PERMITTING				RHODE ISLAND BRIDGE ISLAND BR. 083751 PIER DETAILS																											

NO.	DATE	BY	CHKD.	DATE	BY	NO.	DATE	BY	CHKD.	DATE	BY
1	10/27/2022	BR	BR	10/27/2022	BR	19	10/27/2022	BR	BR	10/27/2022	BR

R-1

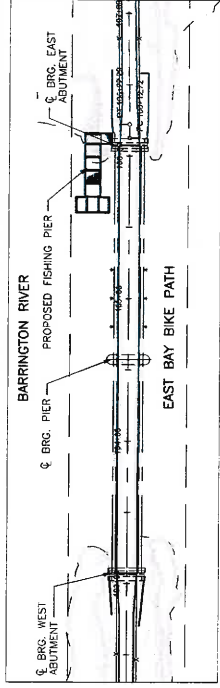

LOCATION MAP
SCALE: 1"=40'

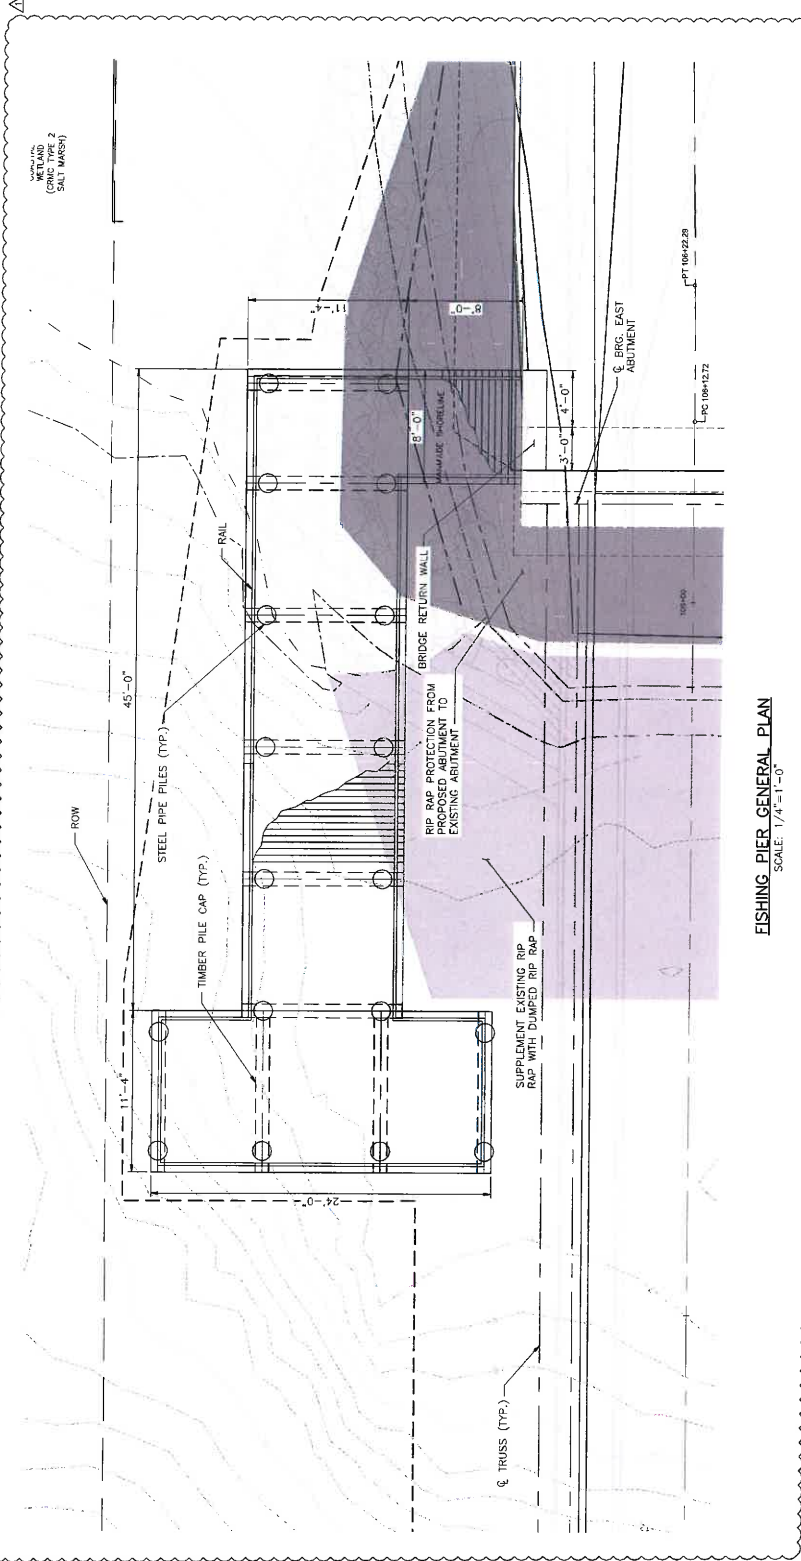

FISHING PIER GENERAL PLAN
SCALE: 1/4"=1'-0"


 277/7024 FEDERAL BRIDGE COMPANY 1 Cedar Street Providence, RI 02903 401.773.8100	 1 Cedar Street Providence, RI 02903 401.773.8100	 RHODE ISLAND DEPARTMENT OF TRANSPORTATION	PROJECT: FISHING PIER CHECKED BY: [blank] DATE: [blank] PUBLIC HEARING: [blank]	REVISIONS NO. DATE BY 1 10/27/22 BR	SCALE: NO. DATE BY 1 10/27/22 BR	EAST BAY BIKE PATH BRIDGE REPLACEMENT (BARRINGTON RIVER AND WARREN BRIDGES) ENVIRONMENTAL PERMITTING
						BRIDGE/ROADWAY ENVIRONMENTAL PERMITTING

Br. 083751 FISHING PIER GENERAL PLAN

01804-02-019-03751_GENERAL_PIER

REV	DATE	BY	CHKD	APPD	NO.	TOTAL
1	08/03/2022	RS	08/03/2022	08/03/2022	20	46



R-1

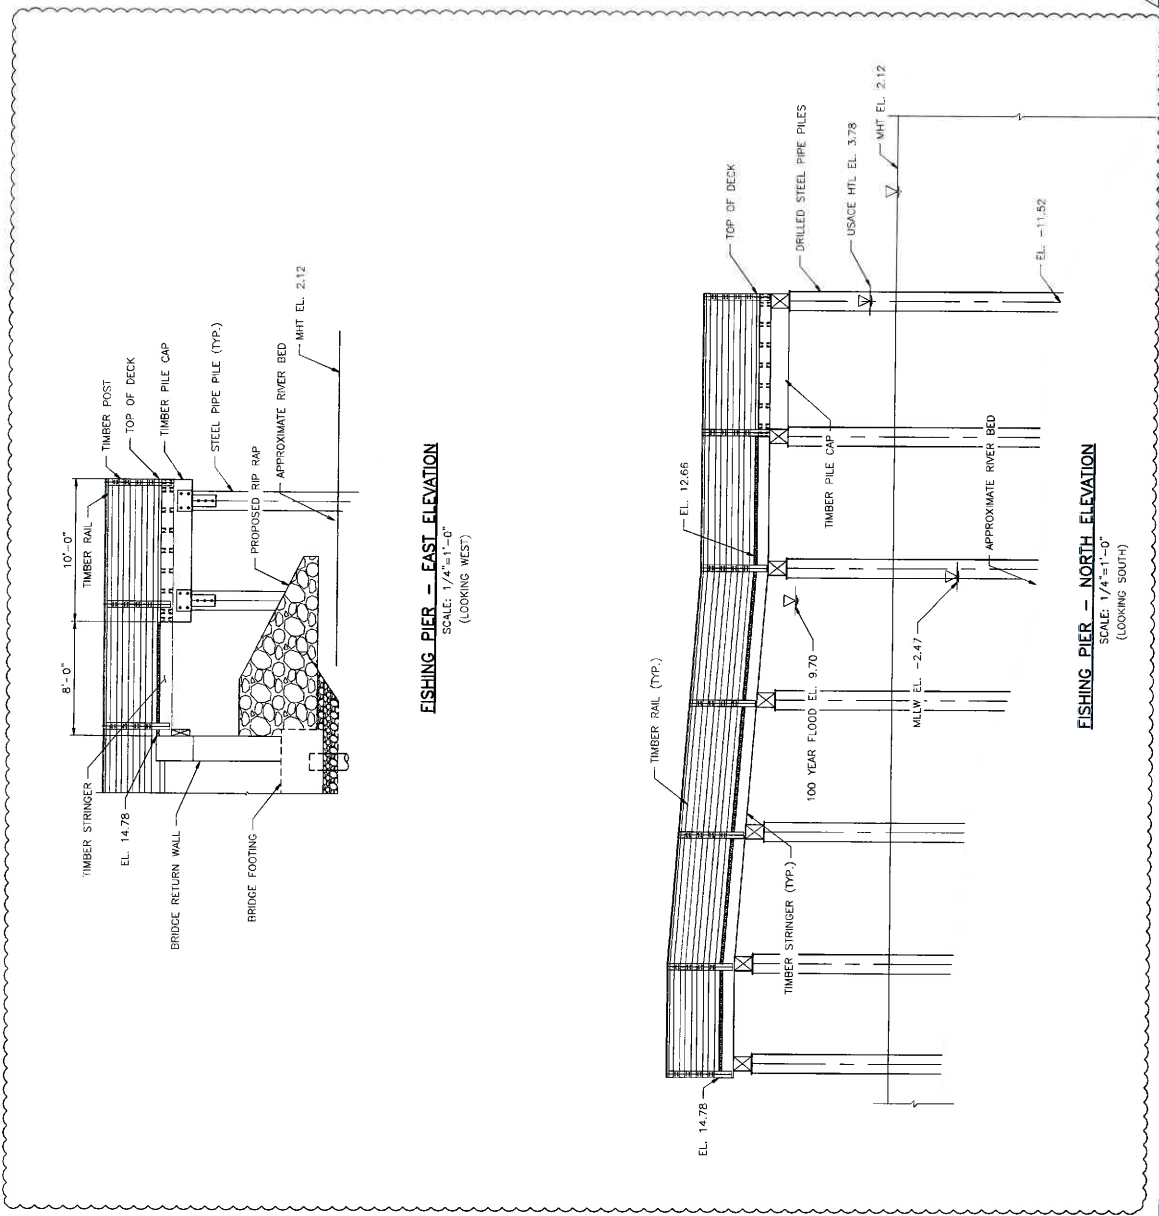

FISHING PIER - EAST ELEVATION
SCALE: 1/4"=1'-0"
(LOOKING WEST)

FISHING PIER - NORTH ELEVATION
SCALE: 1/4"=1'-0"
(LOOKING SOUTH)


			EAST BAY BIKE PATH BRIDGE REPLACEMENT (BARRINGTON RIVER AND WARREN BRIDGES) BRIDGE NOS. 083751 & 088851 VOLUME 2								
			BR. 083751 FISHING PIER ELEVATION								
PROJECT NO. 083751-001 CONTRACT NO. 083751-001 DATE: 08/03/2022 SHEET: 20 OF 46		REVISIONS <table border="1"> <tr> <th>NO.</th> <th>DATE</th> <th>BY</th> <th>CHKD</th> </tr> <tr> <td>1</td> <td>08/03/2022</td> <td>RS</td> <td>08/03/2022</td> </tr> </table>		NO.	DATE	BY	CHKD	1	08/03/2022	RS	08/03/2022
NO.	DATE	BY	CHKD								
1	08/03/2022	RS	08/03/2022								
1 Cedar Street Suite 400 Pawtucket, RI 02861 401.772.8100 											

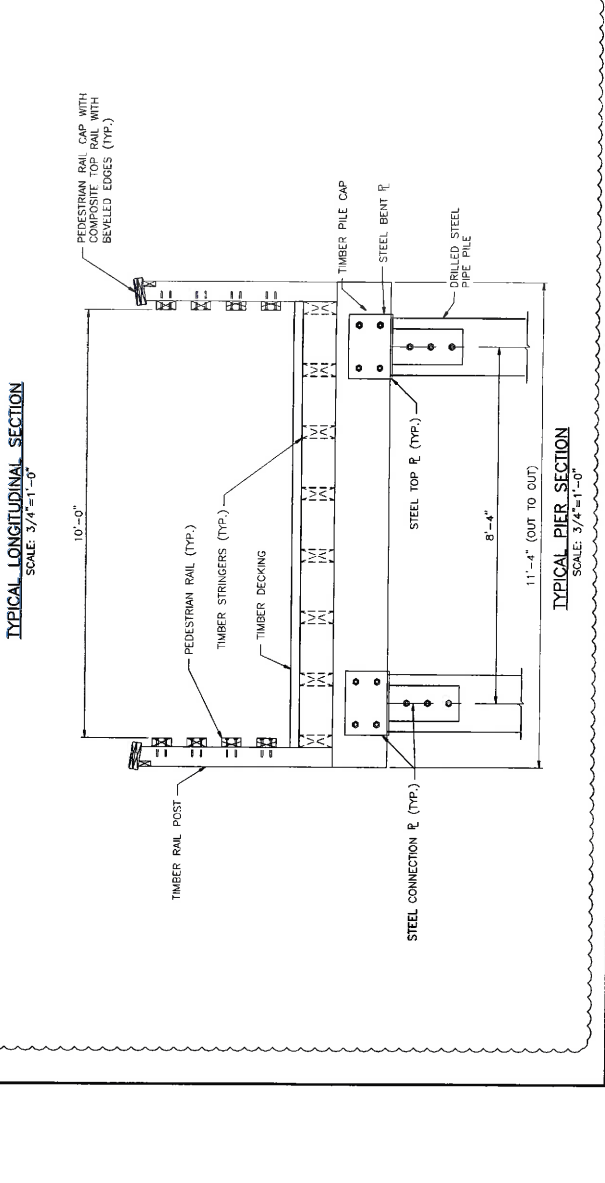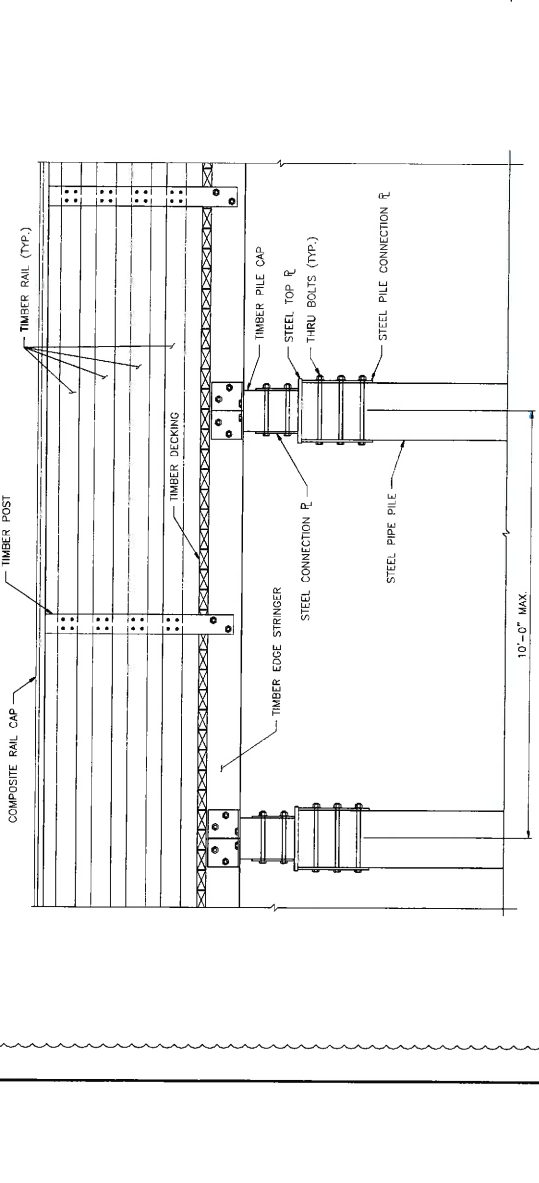

 AEMA Pro Bridge Company 1077024 100% Satisfaction Guaranteed or Your Money Back	 1 Cedar Street Suite 400 R1 02893 401.272.8100	 RI DOT RHODE ISLAND DEPARTMENT OF TRANSPORTATION	PROJECT: ACTON TOWN & TOWN OF ACTON ACTON TOWN & TOWN OF ACTON CIVIL & TOWN COUNCIL CIVIL & TOWN COUNCIL Ground In: Section #: Date: Sheet: OF:	SCALE: <table border="1" style="width: 100%; border-collapse: collapse; margin-top: 10px;"> <tr> <th colspan="2">BRIDGES</th> <th colspan="2">ROADS</th> <th colspan="2">TOTAL</th> </tr> <tr> <th>NO.</th> <th>DATE</th> <th>NO.</th> <th>DATE</th> <th>NO.</th> <th>DATE</th> </tr> <tr> <td>1</td> <td>2/7/24</td> <td>1</td> <td>2/7/24</td> <td>2</td> <td>2/7/24</td> </tr> </table>	BRIDGES		ROADS		TOTAL		NO.	DATE	NO.	DATE	NO.	DATE	1	2/7/24	1	2/7/24	2	2/7/24	EAST BAY BIKE PATH BRIDGE REPLACEMENT (BARRINGTON RIVER AND WARREN BRIDGES) BRIDGE NO. 083751 & 083851 ENVIRONMENTAL PERMITTING BARRINGTON/WARREN BR. 083751 FISHING PIER TYPICAL SECTION
BRIDGES		ROADS		TOTAL																			
NO.	DATE	NO.	DATE	NO.	DATE																		
1	2/7/24	1	2/7/24	2	2/7/24																		

NO.	REV.	DATE	BY	CHKD.	APP'D.	SCALE
1		08/03/2022	BR	BR	BR	22

R-1

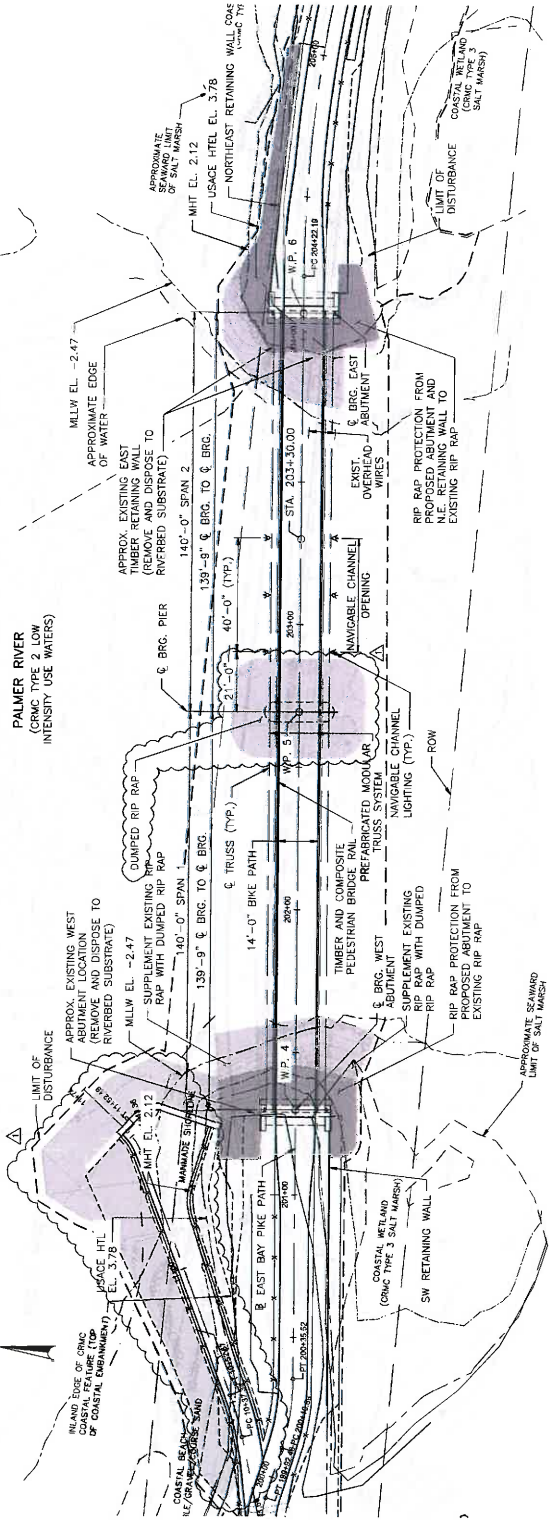

ROUTE 114

PALMER RIVER

(CRMC TYPE 3)

HIGH INTENSITY BOATING WATERS


BRIDGE GENERAL PLAN

SCALE: 1"=20'

LEGEND:

PLACED RIP RAP

DUMPED RIP RAP

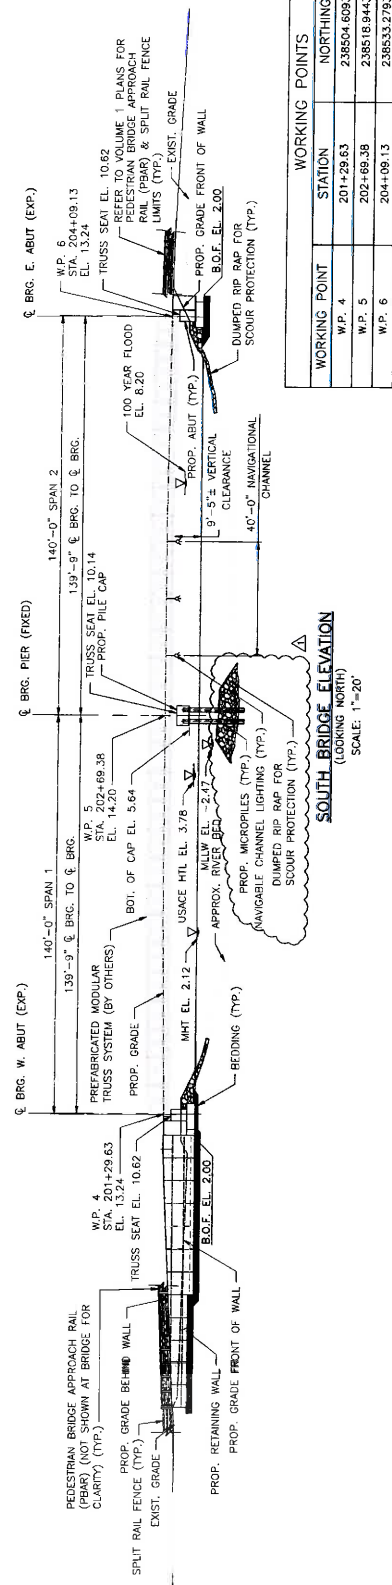

WORKING POINTS

WORKING POINT	STATION	NORTHING	EASTING
W.P. 4	201+29.63	238504.6093	385420.6628
W.P. 5	202+68.38	238518.9443	385559.6757
W.P. 6	204+09.13	238533.2793	385698.6865

2777024
2777024
2777024

RHODE ISLAND
DEPARTMENT OF TRANSPORTATION

EAST BAY BIKE PATH BRIDGE REPLACEMENT
(BARRINGTON RIVER AND MARSH BRIDGES)

BRIDGE NO. 083851 & 083857
BARRINGTON RIVER
ENVIRONMENTAL PERMITTING

BR. 083851 BRIDGE GENERAL PLAN


PROJECT NO. 2777024
DESIGNED BY: [blank]
CHECKED BY: [blank]
DATE: [blank]
SCALE: 1"=20'

REVISIONS

NO.	DATE	BY	CHKD.	APP'D.
1	7/7/24	BR		


BRIDGE NO. 083851 & 083857
BARRINGTON RIVER
ENVIRONMENTAL PERMITTING

REV	NO	DATE	BY	CHKD	APP'D	DESCRIPTION
1	1	08/03/2022	BR	BR	BR	BRIDGE NO. 003851

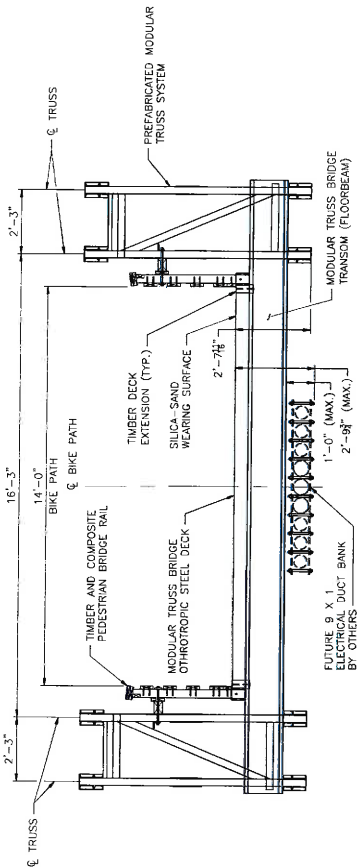

TYPICAL TRUSS SECTION
NOT TO SCALE

NOTES:
1. FUTURE DUCT BANK AND SUPPORTS BY OTHERS, DRILLING AND WELDING TO THE MODULAR TRUSS BRIDGE TRANSOM BEAMS OR ORTHOTROPIC STEEL DECK TO INSTALL UTILITY SUPPORTS IS NOT ALLOWED WITHOUT PERMISSION FROM THE MODULAR TRUSS BRIDGE MANUFACTURER.

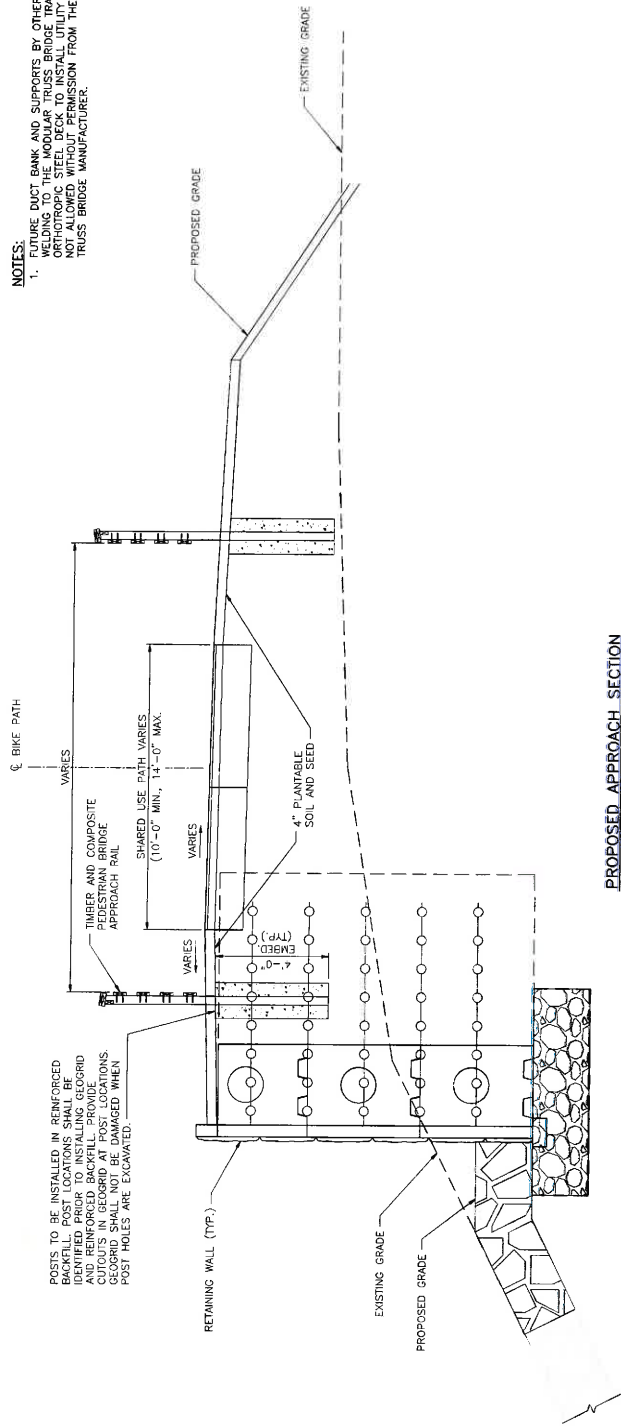

PROPOSED APPROACH SECTION
NOT TO SCALE

277702
CONSULTING ENGINEER
PROVIDENCE, RI 02903
801.772.8100


RHODE ISLAND
DEPARTMENT OF TRANSPORTATION

EAST BAY BIKE PATH BRIDGE REPLACEMENT
(BARRINGTON RIVER AND MARSH BRIDGES)
BRIDGE NO. 003851 & 003851
ENVIRONMENTAL PERMITTING

BR. 003851 BRIDGE TYPICAL SECTION

DESIGNED BY:		CHECKED BY:		SCALE:	
DATE:	NO.	DATE:	NO.	DATE:	NO.
22	23	23	23	23	23

R-1

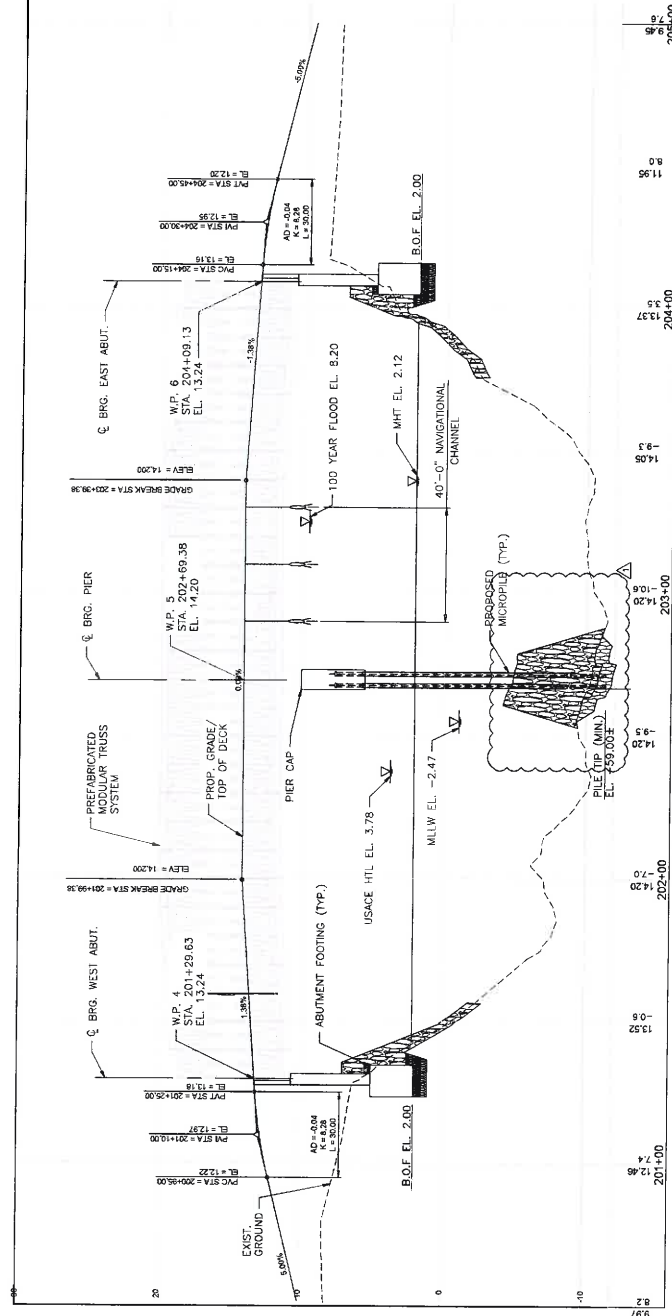


B WARREN PROFILE
SCALE HORIZONTAL: 1"=20'
SCALE VERTICAL: 1"=4'

NOTE: REFER TO HIGHWAY PLANS FOR ADDITIONAL INFORMATION.

[illegible]

REV	DATE	BY	CHKD	APPD	DATE
1	06/01/2023	BR	BR	BR	06/01/2023

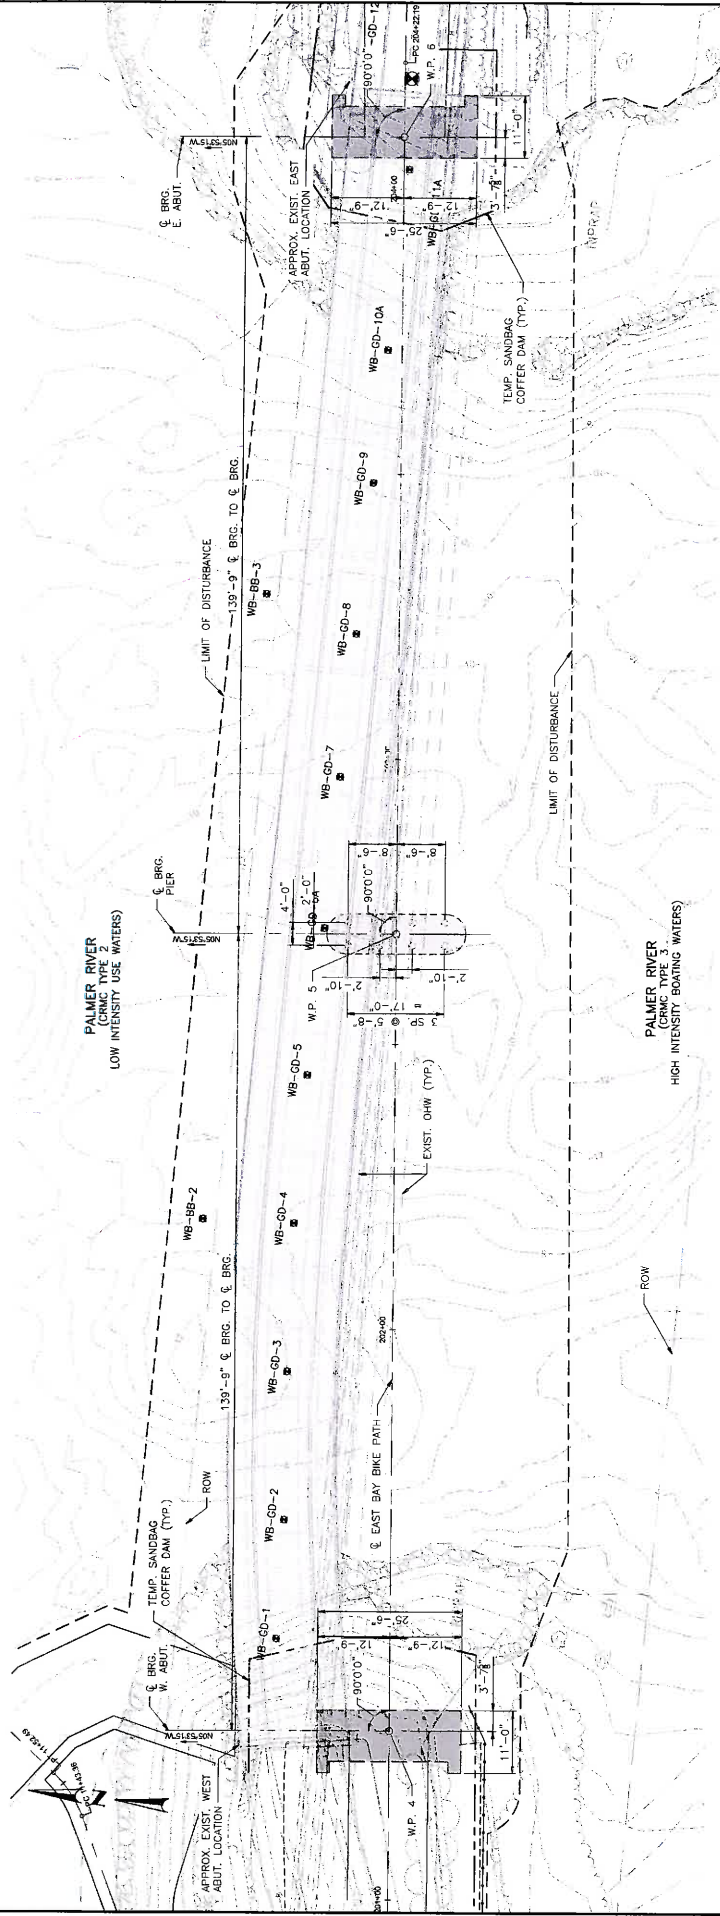

FOUNDATION PLAN
SCALE: 1" = 10'

- LEGEND**
- PROPOSED FOUNDATION
 - PIER CAP
 - PROPOSED DRILLED MICROPILE (14" DIA.) (VERTICAL)

EARLY RELEASE FOR
CONSTRUCTION
(ERC 2)
JUNE 2023



RHODE ISLAND
DEPARTMENT OF TRANSPORTATION


DESIGNED BY:	CHOKO BY:	SCALE:	NO.	DATE	BY	NO.	DATE	BY

EAST BAY BIKE PATH BRIDGE REPLACEMENT
(BARRINGTON RIVER AND WARREN BRIDGES)
BRIDGE NO. 00791 & 00881
ENVIRONMENTAL PERMITTING
BARRINGTON WARREN
BRIDGE ISLAND


BR. 0838851 FOUNDATION PLAN

08 MAY 12 03:51 PM GMT-07:00

REV	DATE	BY	CHKD	APP'D	DATE	TOTAL
1	08/03/2022	BR	BR	BR	25	38

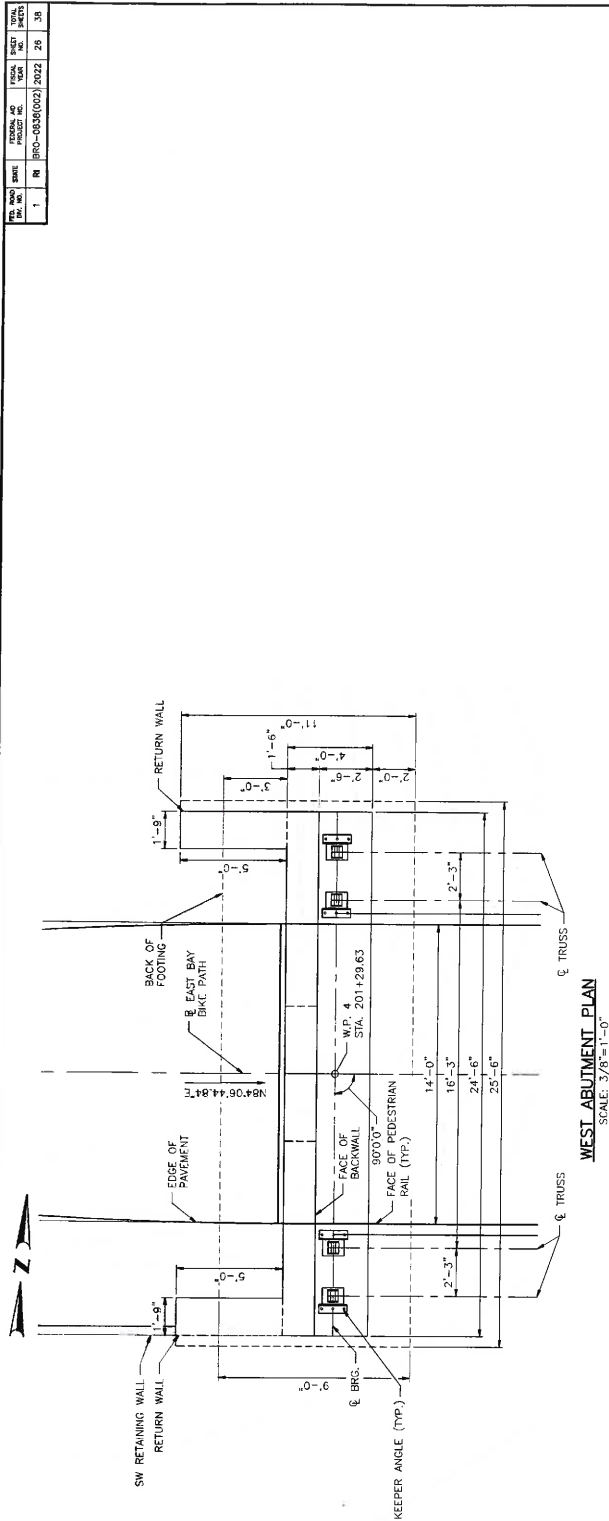

WEST ABUTMENT PLAN
SCALE: 3/8"=1'-0"

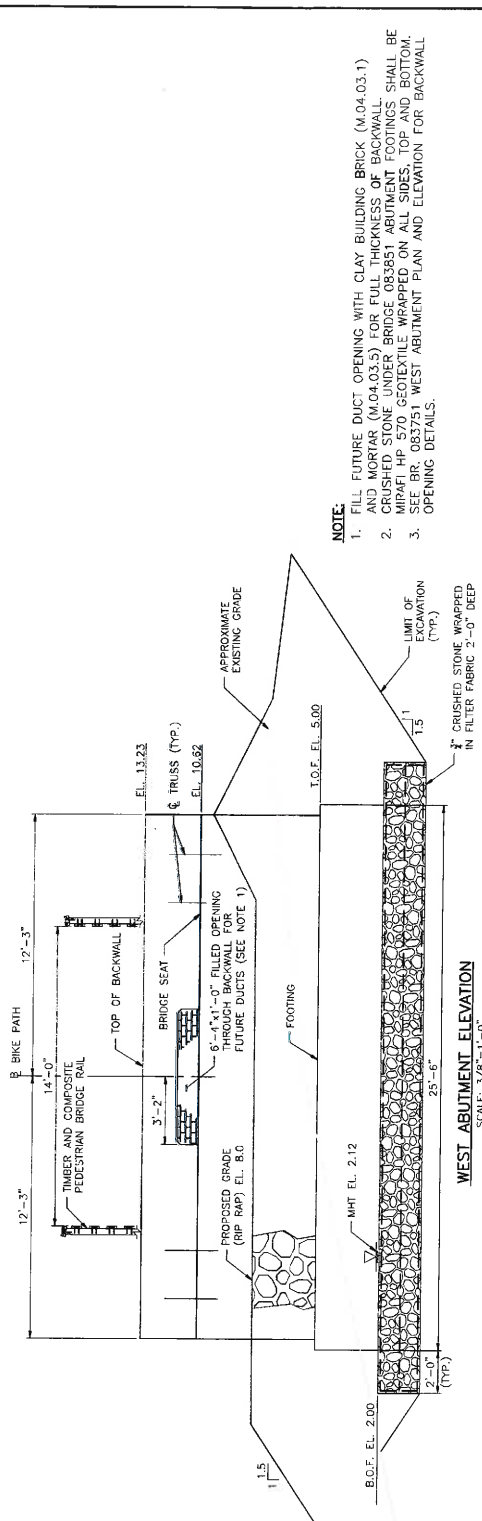

WEST ABUTMENT ELEVATION
SCALE: 3/8"=1'-0"

- NOTE:**
1. FILL FUTURE DUCT OPENING WITH CLAY BUILDING BRICK (M.04.03.1) AND MORTAR (M.04.03.5) FOR FULL THICKNESS OF BACKWALL.
 2. ALL STONE UNDER BRIDGE 083851 ABUTMENT FOOTINGS SHALL BE CRUSHED STONE (M.04.03.1) AND SHALL BE WRAPPED ON ALL SIDES, TOP AND BOTTOM.
 3. SEE BR 083751 WEST ABUTMENT PLAN AND ELEVATION FOR BACKWALL OPENING DETAILS.

EAST BAY BIKE PATH BRIDGE REPLACEMENT
(BARRINGTON RIVER AND WARREN BRIDGES)
BRIDGE NO. 083751 & 083851
BARRINGTON-WARREN
ENVIRONMENTAL PERMITTING
RIDGE ISLAND

NO.	DATE	BY	CHKD	APP'D
1	08/03/2022	BR	BR	BR







SCALE:
DESIGNED BY:
CHECKED BY:
DATE:
SHEET:
OF:

RHODE ISLAND
DEPARTMENT OF TRANSPORTATION

1 Cedar Street
Suite 400
Barrington, RI 02803
801.772.8100
vthb

AT&T
2777082
The Bridge Company

ED. ROAD DIV. NO.	STAGE	FEDERAL AID PROJECT NO.	FISCAL YEAR	SHEET NO.	TOTAL SHEETS
1	RI	BRO-0838(002)	2022	28	38

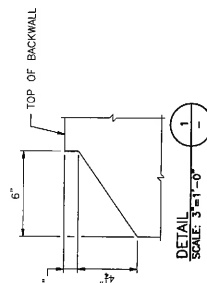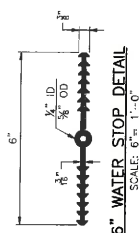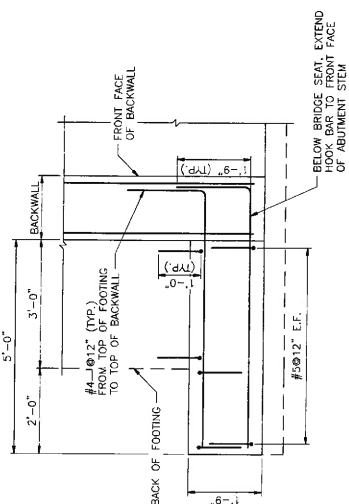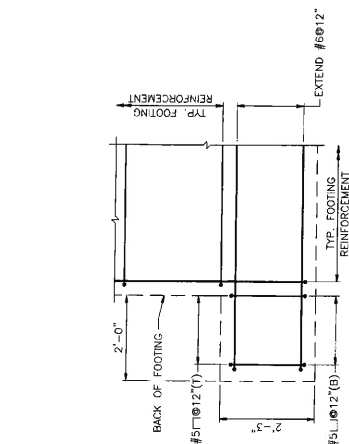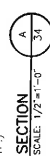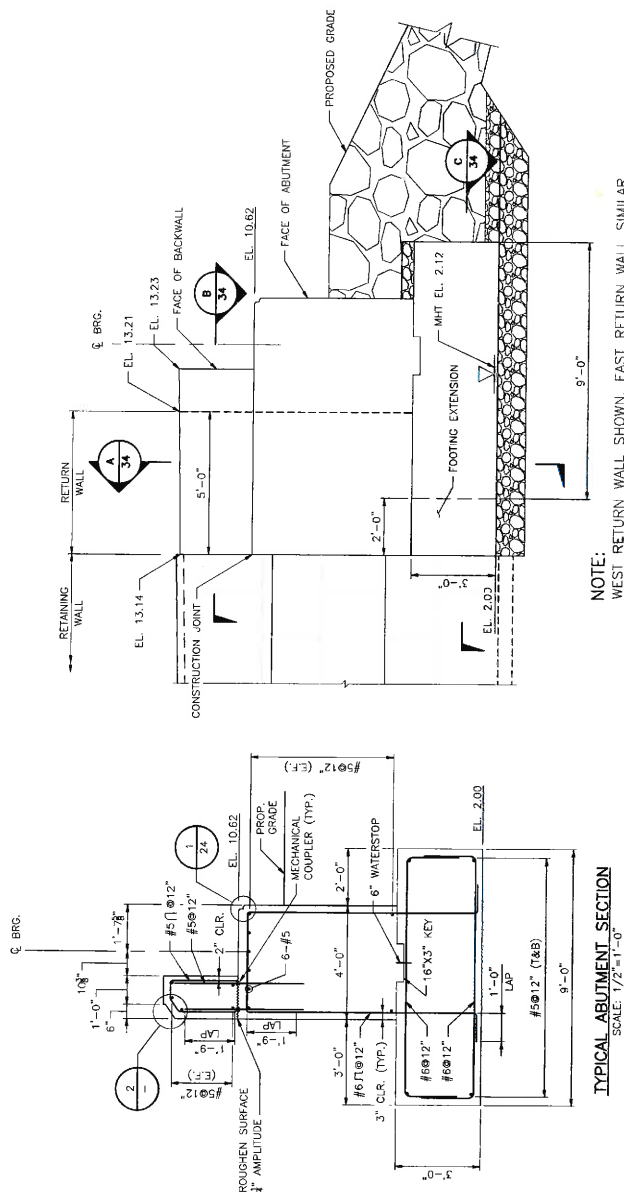

NOTE:

1. SEE Br. 083751 & 083851 RIP RAP DETAILS 1

THE PATH BRIDGE REPLACEMENT

STON RIVER AND WARREN BRIDGES)
BRIDGE NO. 083751 & 083851
ENVIRONMENTAL PERMITTING

ENVIRONMENTAL PERMITTING
RHODE ISLAND

851 ABUTMENT DETAILS

BR. 083851 ABUTMENT DETAILS

[illegible]

SHEET:	26	NO.	DATE
OF:	35		

OF TRANSFORMATION

DEPARTMENT OF THE ARMY

2


10

[illegible]

MANAGEMENT COLLEGE


018RA_V2_028_083651_AIRUTOTTI

REV.	DATE	BY	CHKD.	APP'D.	NO.	DESCRIPTION
1	08/03/2022	BR	BR	BR	083851	RETAINING WALL

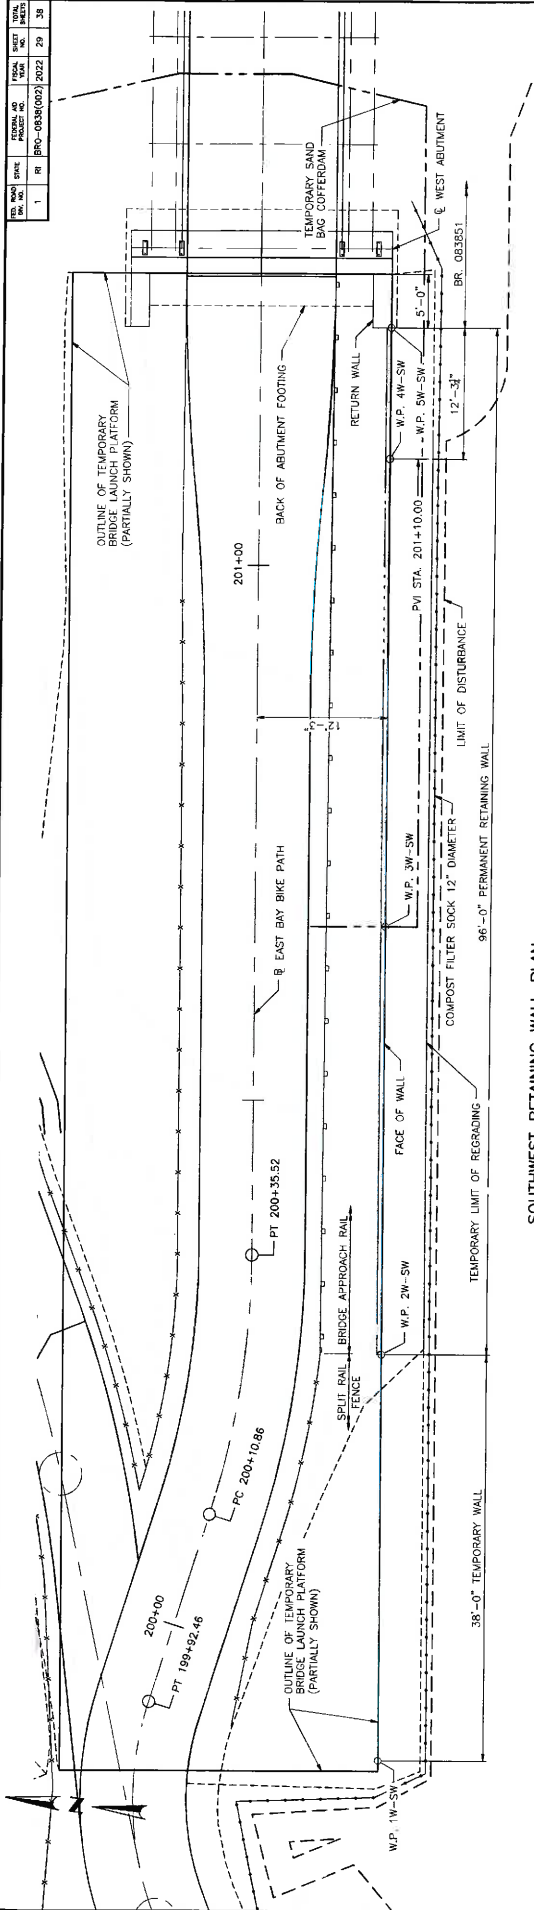

SOUTHWEST RETAINING WALL PLAN

SCALE: 3/16"=1'-0"

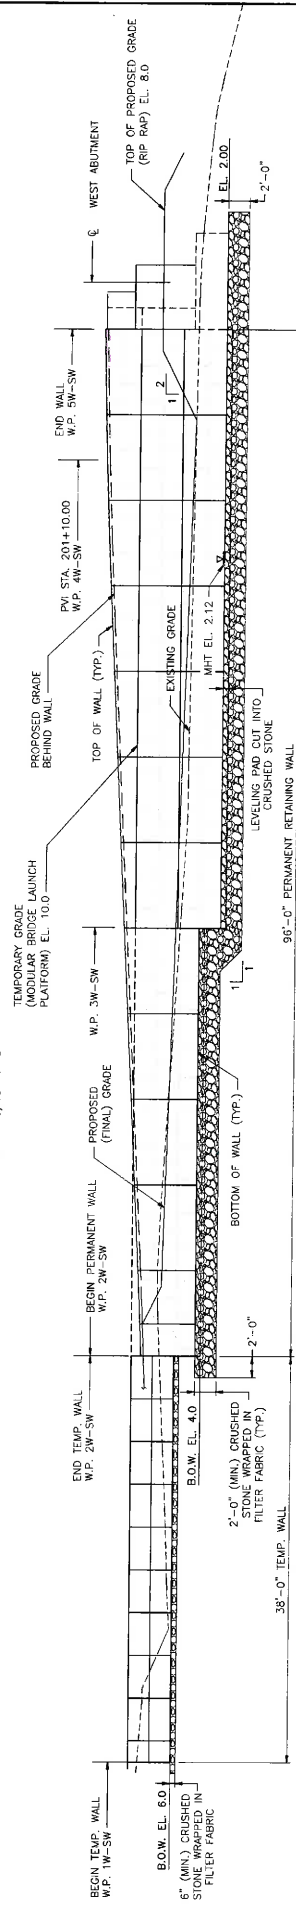

SOUTHWEST RETAINING WALL ELEVATION

SCALE: 3/16"=1'-0"

SOUTHWEST RETAINING WALL					
WORKING POINT	STATION	OFFSET	NORTHING	EASTING	EL. A*
W.P. 1W-SW	199+93.82	22.24	238477.9197	3852361.3009	10.00**
W.P. 2W-SW	200+27.52	12.72	238461.8185	385319.1003	8.85
W.P. 3W-SW	200+86.27	12.25	238485.9228	385358.8692	10.78
W.P. 4W-SW	201+10.00	12.25	238490.4098	385402.3925	12.83
W.P. 5W-SW	201+22.27	12.25	238491.6683	385414.5937	13.13

* ELEVATION IS GIVEN AT PROPOSED GRADE BEHIND WALL. SEE TYPICAL RETAINING WALL SECTION.
 ** THIS GRADE IS TEMPORARY FOR THE LAUNCHING PLATFORM

NOTES:

1. REFER TO HIGHWAY PLANS FOR COMPLETE GEOMETRY AND CURVE DATA FOR BIKE PATH.
2. PANEL SLIP JOINTS ARE NOT SHOWN. SLIP JOINT LOCATION AND QUANTITY SHALL BE DETERMINED BY THE WALL MANUFACTURER.
3. ALL RETAINING WALLS SHALL HAVE AN ASHLAR FORMER DETAIL FOR APPROVAL.
4. WALL FABRIC FOR WRAPPING CRUSHED STONE UNDER THE RETAINING WALL SHALL BE 12" MIN. STITCHES EQUAL TO 12" FOR TYPICAL RETAINING WALL SECTION.



RHODE ISLAND
DEPARTMENT OF TRANSPORTATION

EAST BAY BIKE PATH BRIDGE REPLACEMENT
(BARRINGTON RIVER AND WARREN BRIDGES)

BRIDGE NO. 06371 & 06381
ENVIRONMENTAL PERMITTING

SPRINGFORD/MARSH
BR: 083851 RETAINING WALL PLAN 1

DESIGNED BY: [blank]
CHECKED BY: [blank]
DATE: [blank]

SCALE: [blank]
NO. [blank] DATE [blank] BY [blank]
NO. [blank] DATE [blank] BY [blank]

BRIDGE NO. 06371 & 06381
ENVIRONMENTAL PERMITTING
SPRINGFORD/MARSH
BR: 083851 RETAINING WALL PLAN 1


FEED. ROAD DRA. NO.	STATE	FEDERAL AID PROJECT NO.	FISCAL YEAR	SHEET NO.	TOTAL SHEETS
1	RN	BRO-0838(002)	2022	30	38

MINIMUM REQUIRED REINFORCEMENT (GEOGRID) LENGTHS	
RETAINING WALL LOCATION	LENGTH (L)*
SOUTHWEST	0.7H
NORTHEAST	0.7H

H = EL. A - B.O.W. EL.


NOTE:

NOTE: GEOGRID LENGTH "L" SHALL BE THE MINIMUM LENGTHS SHOWN TO SATISFY GLOBAL STABILITY. WALL DESIGNER'S DESIGN SHALL INCLUDE AN INTERNAL STABILITY ANALYSIS.

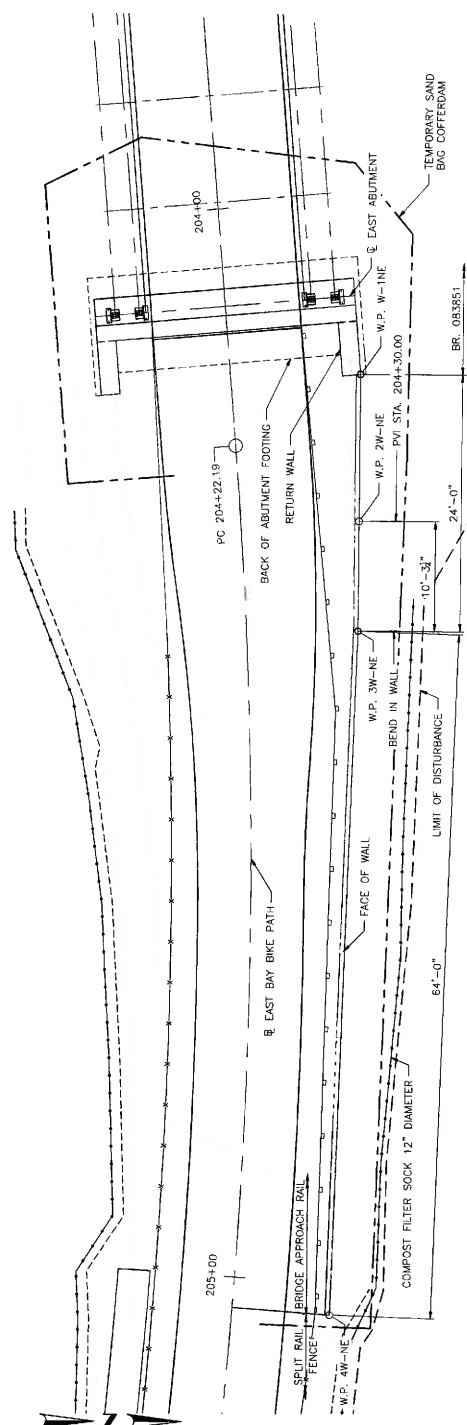

NORTHEAST RETAINING WALL PLAN

SCALE: 3/16"=1'-0"

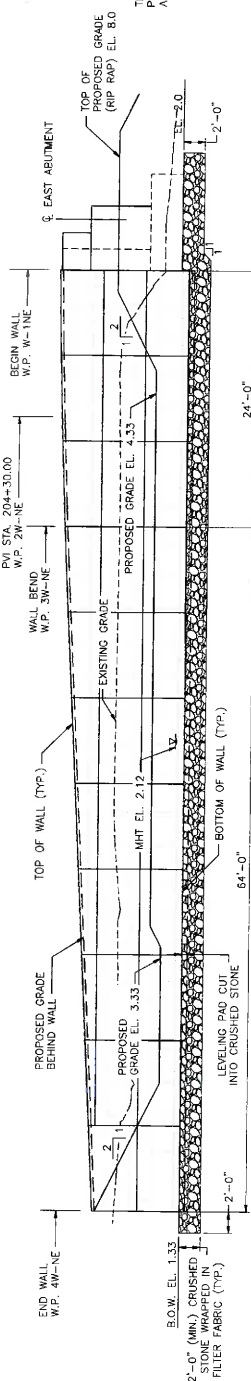


~~NORTHEAST RETAINING WALL ELEVATION -- DEVELOPED~~

SCALE: 3/16"=1'-0"

WORKING POINT		NORTHEAST RETAINING WALL			EL. A*
		OFFSET	NORTHING	EASTING	
W.P. 1W-NE	204+16.50	-12.25	235546.2201	385704.7577	13.15
W.P. 2W-NE	204+30.00	-11.13	235546.4429	385718.4901	12.84
W.P. 3W-NE	204+40.03	-10.50	235546.6093	385728.7545	12.47
W.P. 4W-NE	205+02.83	-9.20	235545.5894	385732.7464	9.54

* ELEVATION IS GIVEN AT PROPOSED GRADE BEHIND WALL. SEE TYPICAL RETAINING WALL SECTION.

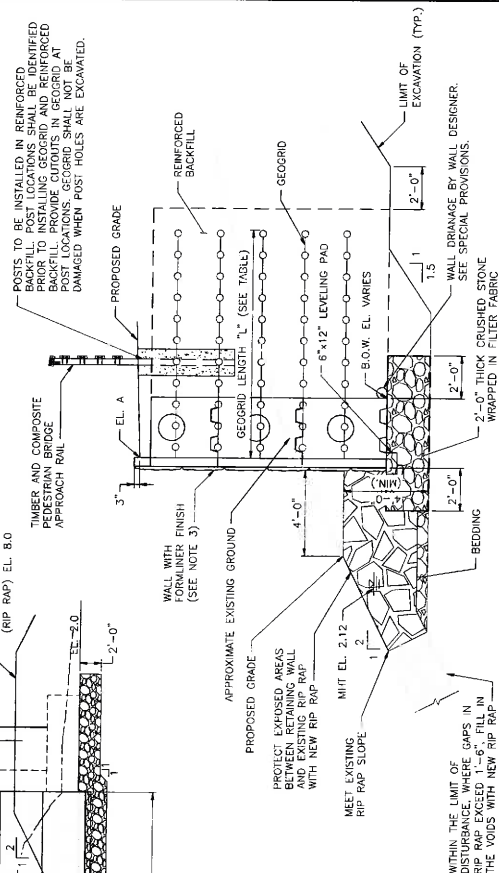

TYPICAL RETAINING WALL SECTION

SCALE: 3/8"=1'-0"

NO.	REVISIONS		REVISIONS	
	DATE	BY	DATE	BY
30				
30				

SCALE:

DESIGNED BY: _____

CHECKED BY: _____

DATE: _____

SHEET: _____

OF: _____

RHODE ISLAND

DEPARTMENT OF TRANSPORTATION



1 Cedar Street
Suite 400
Providence, RI 02903
401.773.8500

RECEIVED
21/7/2024


EAST BAY BIKE PATH BRIDGE REPLACEMENT

BRIDGE NO. 083751 & 083851
ENVIRONMENTAL PERMITTING


33R. 083851 RETAINING WALL PLAN 2

SIERRA V2 030 BRUNNEN'S PATENT

W.P. #	LOCATION	STATION	NORTHING	EASTING
5	WARREN	202+60.38	218518.0471	185550.6757

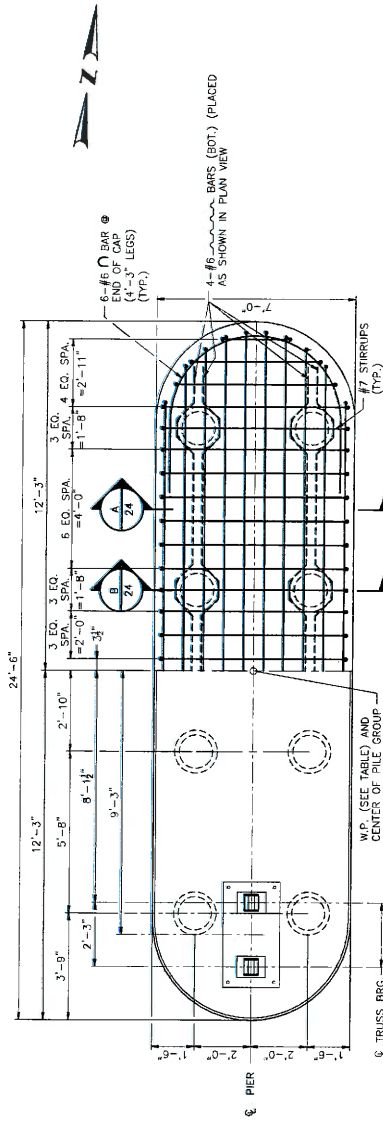

PIER PLAN
(PIER IS SYMMETRICAL ABOUT THE CENTERLINE)
SCALE: $\frac{1}{8}" = 1' - 0"$

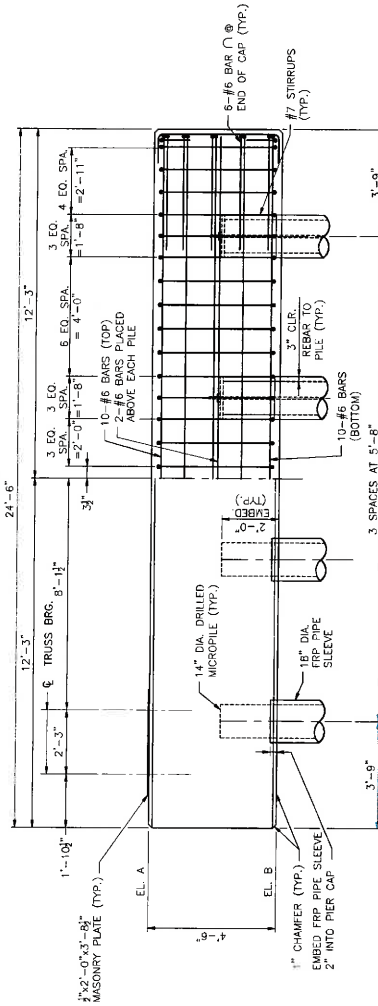

PIER ELEVATION
(PIER IS SYMMETRICAL ABOUT THE CENTERLINE)
SCALE: $\frac{1}{8}'' = 1' - 0''$

NOTES:

1. SEE NOTES AND DRIP EDGE DETAIL ON BR. 083751 PIER DETAILS.
2. ONCE PILES ARE INSTALLED, SUBMIT AS-BUILT LOCATIONS TO DESIGN ENGINEER TO VERIFY AND APPROVE THE LOCATIONS.

RECEIVED
2/7/2024
COASTAL MOUNTAIN
LIBRARY


EAST BAY BIKE PATH BRIDGE REPLACEMENT
(BARRINGTON RIVER AND WARREN BRIDGES)
BRIDGE NO. 063751 & 083851
ENVIRONMENTAL PERMITTING
BARRINGTON/WARREN
RIDGE ISLAND

BR. 083851 PIER DETAILS


010BA_V2_031_PIER_083M51

	 1 Cedar Street Suite 400 Providence, RI 02903 401.717.0765	 RHODE ISLAND DEPARTMENT OF TRANSPORTATION	REVISION: 11/11 CHECKED BY: [blank] DATE: 11/11/11 31 01	SCALE: [blank]										EAST BAY BIKE PATH BRIDGE REPLACEMENT (BARRETT PATH AND BARRINGTON WARREN BRIDGES) BRIDGE NO. 063791 & 030351 BARRINGTON WARREN ENVIRONMENTAL PERMITTING BR. 063851 PIER DETAILS									
				REVISIONS NO. DATE BY					REVISIONS NO. DATE BY														
				[blank]					[blank]														

NO.	DATE	BY	CHKD.	APP'D.	SCALE	SHEET NO.	TOTAL SHEETS
1	11/1/2022	BR	BR	BR	1/4" = 1'-0"	32	38

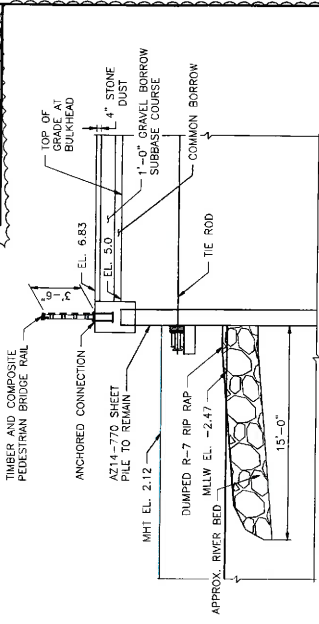

TYPICAL SECTION AT SHEETING
SCALE: 1/4" = 1'-0"

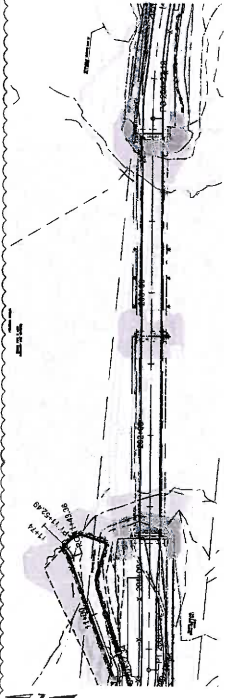


LOCATION MAP
SCALE: 1" = 40'



FISHING PIER GENERAL PLAN
SCALE: 1" = 10'

		EAST BAY BIKE PATH BRIDGE REPLACEMENT (BARRINGTON RIVER AND WARREN BRIDGES) BRIDGE NO. 083751 & 083851 ENVIRONMENTAL PERMITTING	
PROJECT NO. 083851 SHEET NO. 083851-32 DATE: 11/1/2022 BY: BR CHKD: BR APP'D: BR		PROJECT NO. 083851 SHEET NO. 083851-32 DATE: 11/1/2022 BY: BR CHKD: BR APP'D: BR	
1 Cedar Street South Providence, RI 02903 401.272.8100 			

 R-1

— MICROPILE (TYP.)


NOTES:

1. ON 2014 EAST RIVER PIKE PATH DESIGN STUDY REPORTS FOR BARRINGTON RIVER BRIDGE AND PALMER RIVER BRIDGE, THE PROPOSED RIP RAP IS INTENDED TO BE 10 FEET AT BARRINGTON RIVER BRIDGE AND 5.0 FEET AT PALMER RIVER BRIDGE. THE PROPOSED RIP RAP IS INTENDED TO PREVENT LOCAL SCOUR AT THE PIERS.

2. THE HEAVY DUTY-WEAVED NONWOVEN GEOTEXTILE DESIGNED FOR FILTERATION AND STRENGTH IN BAGS SHALL BE PLACED WITH ENOUGH OVERLAP TO ENSURE FULL COVERAGE UNDER THE RIP RAP. ONCE THE GEOTEXTILE CONTAINERS ARE INSTALLED THERE SHALL BE A CONTINUOUS BLANKET OF SAND AT LEAST 6" THICK AND WRAPPED IN A PLASTIC LINER. THE CONTRACTOR MAY DO THIS WITH MULTIPLE BAGS PLACED INDIVIDUALLY OR WITH A PREFABRICATED PANEL. THE RECOMMENDED MATERIAL FOR THE SAND FILLED GEOTEXTILE CONTAINERS ARE AS FOLLOWS:

MASS PER UNIT AREA	AOS	PERMEABILITY	GEOTEXTILE TYPE	Kg/Ks
278 g/m ²	0.18mm	0.21 cm/s	NONWOVEN NEEDLE PUNCHED	5.25

3. CONTRACTOR SHALL AVOID DAMAGE TO THE GEOTEXTILE CONTAINERS WHILE PLACING RIP RAP.

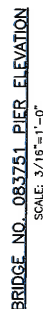

PROJECT MODIFICATIONS SINCE
OCTOBER 24, 2023
CRMC FULL COUNCIL
PUBLIC HEARING.

**RHODE ISLAND
DEPARTMENT OF TRANSPORTATION**



1 Cedar Street
Suite 400
Providence, RI 02903
401.272.8100


ETNA
Etna Bridge Company

EAST BAY BIKE PATH BRIDGE REPLACEMENT
(BARRINGTON RIVER AND WARREN BRIDGES)
BRIDGE NO. 083751 & 083851
ENVIRONMENTAL PERMITTING
BARRINGTON/WARREN
RHODE ISLAND


BR. 083751 & 083851 RIP RAP DETAILS 2

LOCATION


REV.	DATE	DESCRIPTION	BY	CHKD.
1	08/03/2022	BR-083851	BR	BR

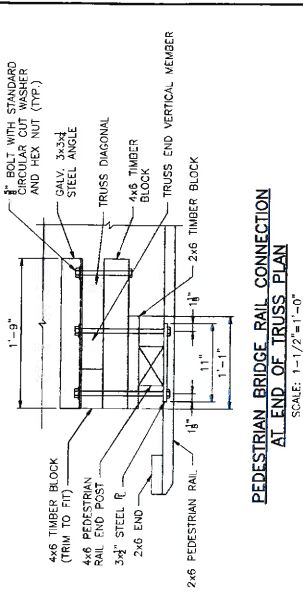


PEDESTRIAN BRIDGE RAIL CONNECTION
AT END OF TRUSS PLAN
SCALE: 1"=1'-0"

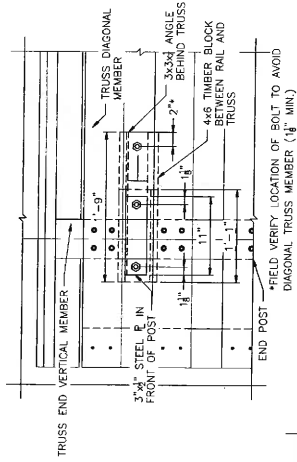


PEDESTRIAN BRIDGE RAIL CONNECTION
AT END OF TRUSS ELEVATION
SCALE: 1"=1'-0"

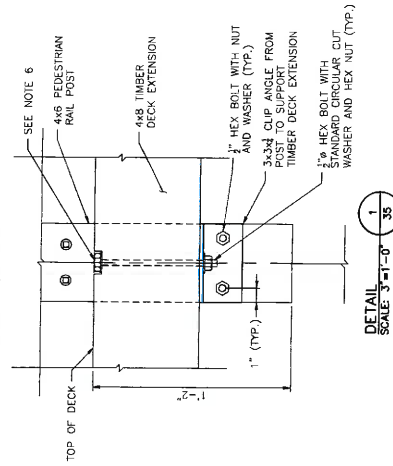


DETAIL
SCALE: 3"=1'-0" 1/35

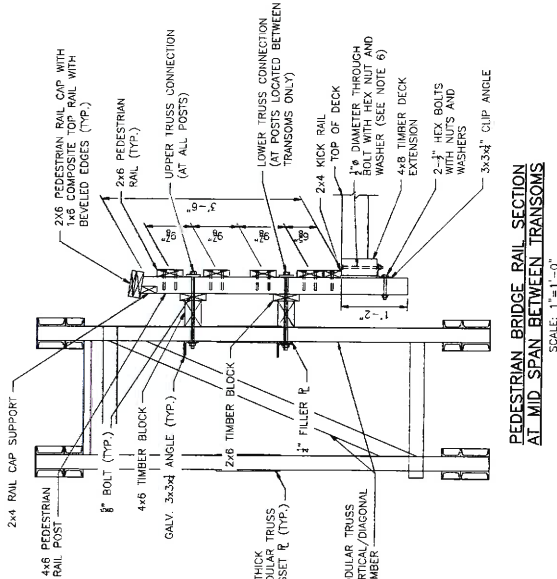

PEDESTRIAN BRIDGE RAIL SECTION
AT MID SPAN BETWEEN TRANSOMS
SCALE: 1"=1'-0"

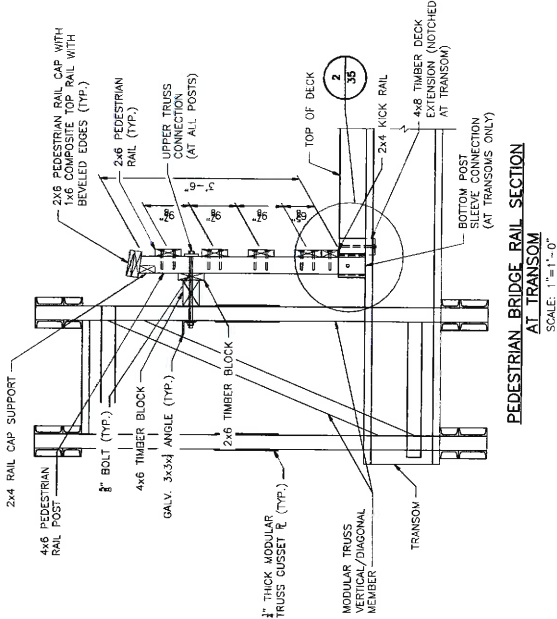

PEDESTRIAN BRIDGE RAIL SECTION
AT TRANSOM
SCALE: 1"=1'-0"

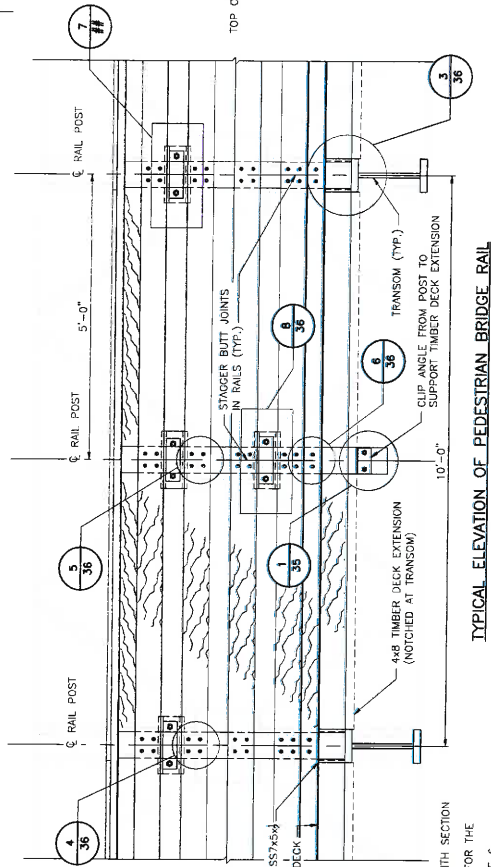

TYPICAL ELEVATION OF PEDESTRIAN BRIDGE RAIL
SCALE: 1"=1'-0"

- NOTES:**
1. ALL TIMBER, HARDWARE AND CONSTRUCTION FOR THE BRIDGE RAIL SHALL BE IN ACCORDANCE WITH SECTION 806 OF THE RIDOT STANDARD SPECIFICATIONS.
 2. SURFACED FOUR SIDES LUMBER IS LABELED WITH NOMINAL DIMENSIONS. ALL TIMBER SPECIFIED FOR THE BRIDGE RAIL SHALL BE GALVANIZED PER SHEET 5 NOTE 6.
 3. ALL BOLTS, NUTS, WASHERS AND STRUCTURAL STEEL ARE TO BE GALVANIZED PER SHEET 5 NOTE 6.
 4. PROVIDE OPEN JOINT IN COMPOSITE TOP RAIL AT PANELS ADJACENT TO EXPANSION JOINTS.
 5. BEVEL TOP FACE AND EDGES AT END CUT (ENDS OF BRIDGE).
 6. COUNTERBORE RECESS WITH SLOANE SQUARE AFTER TIMBER DECK EXTENSION BOLTS ARE INSTALLED AND TIGHTENED.

PLAN AT BOTTOM POST SLEEVE
SCALE: 1"=1'-0"

RHODE ISLAND
DEPARTMENT OF TRANSPORTATION

BRIDGE NO. 083751 & 083851
(BARRINGTON RIVER AND WARREN BRIDGES)

BRIDGE ISLAND

BRIDGE NO. 083751 & 083851
(BARRINGTON RIVER AND WARREN BRIDGES)

BRIDGE ISLAND

ED. ROAD DW. NO.	STATE	FEDERAL AND PRODUCT NO.	FISCAL YEAR	SHEET NO.	TOTAL SHEETS
1	RI	BRO-0836(002)	2022	36	38

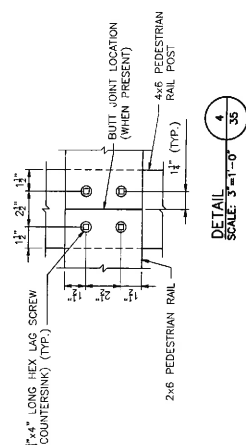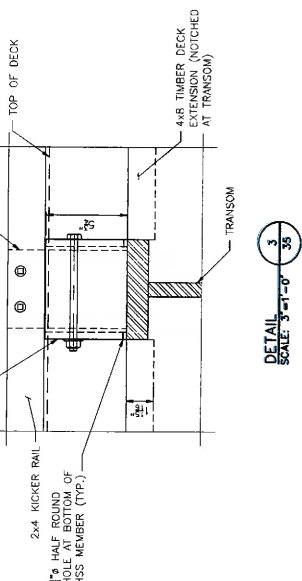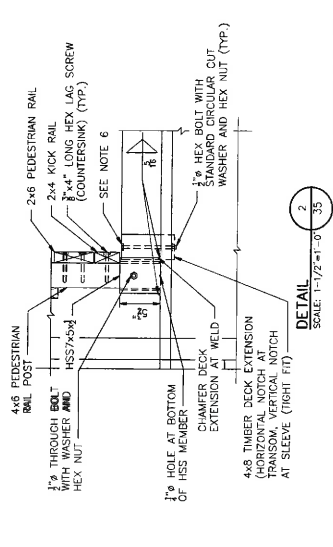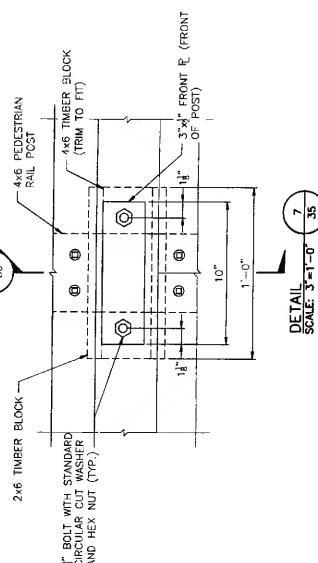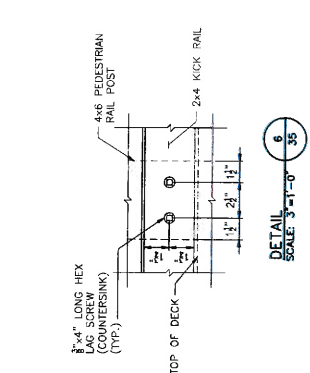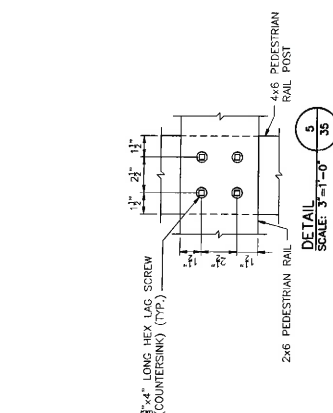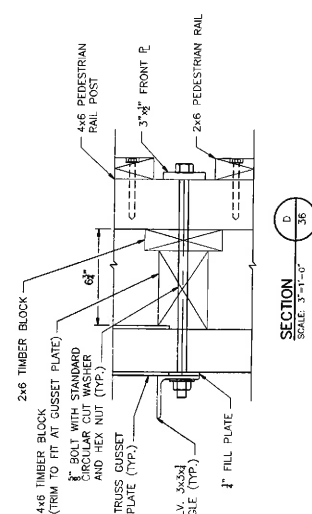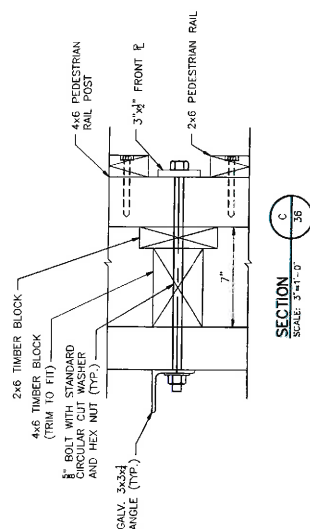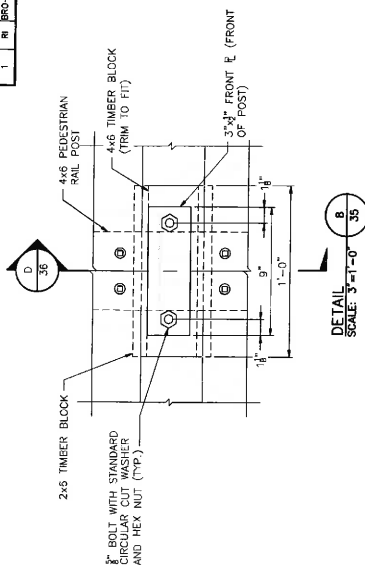

NOTES:

1. SEE NOTES ON BR. 083751 & 083851 BRIDGE RAIL DETAILS 1.

EAST BAY BIKE PATH BRIDGE REPLACEMENT (BARRINGTON RIVER AND WARREN BRIDGES) BRIDGE NO. 083751 & 083851 BARRINGTONWARREN ENVIRONMENTAL PERMITTING BRIDGE NO. 083751 & BR. 083851 RAIL DETAILS 2		SCALE:	
REVISIONS NO. DATE BY		REVISIONS NO. DATE BY	
DESIGNED BY:	CHECKED BY:	DATE:	SHEET:
56	58	59	60

RHODE ISLAND
DEPARTMENT OF TRANSPORTATION




--	--

 VHB
1 Cedar Street
Suite 400
Providence, RI 02903
401.272.8100


RECEIVED
2/17/2024
FEDERAL RESERVE BANK
WASHINGTON, DC 20563
MAIL ROOM

ETNA
The Bridge Company


REV	DATE	BY	CHKD	PROJECT NO.	DATE	SHEET NO.	TOTAL SHEETS
1	01	BR	BR	BR-08351(022)	2022	37	38

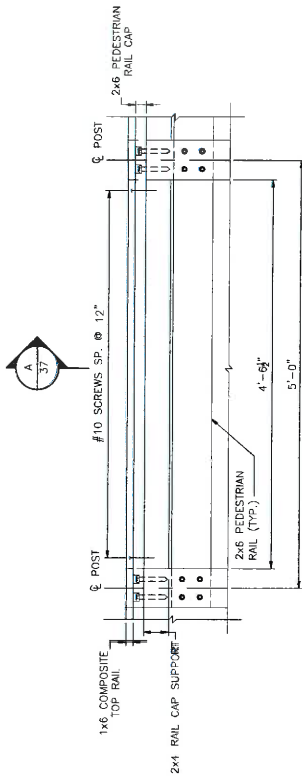

ELEVATION
TYPICAL RAIL CAP SUPPORT TO PEDESTRIAN
RAIL CAP CONNECTION
SCALE: 1-1/2"=1'-0"

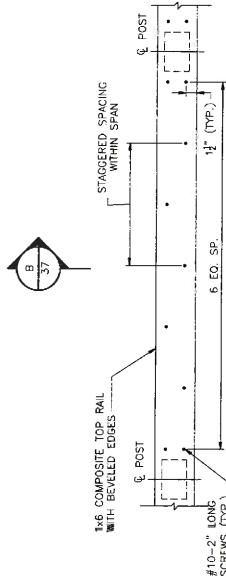


PLAN
TYPICAL COMPOSITE TOP RAIL TO
PEDESTRIAN RAIL CAP CONNECTION
SCALE: 1-1/2"=1'-0"

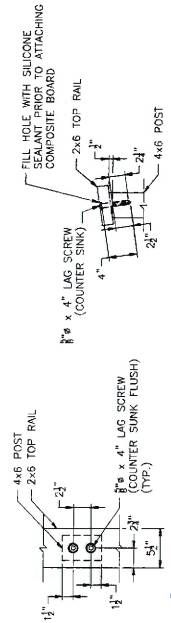


SECTION
RAIL CAP CONNECTION AT
RAILING POST
SCALE: 1-1/2"=1'-0"

NOTE: COMPOSITE TOP RAIL NOT SHOWN FOR CLARITY.

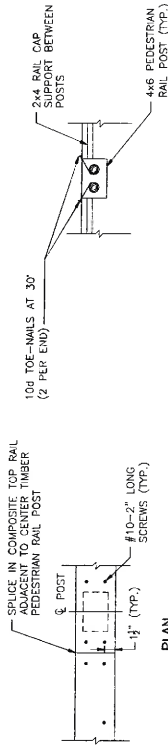

PLAN
TYPICAL RAIL CAP SUPPORT TO RAIL
CONNECTION
SCALE: 1-1/2"=1'-0"

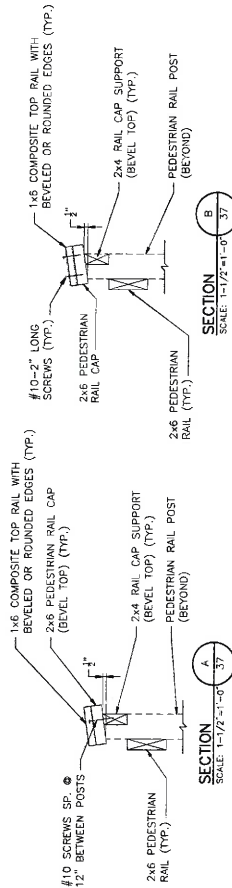

NOTES:
1. SEE NOTES ON BR. 083751 & 083851 BRIDGE RAIL DETAILS 1.

RHODE ISLAND
DEPARTMENT OF TRANSPORTATION

EAST BAY BIKE PATH BRIDGE REPLACEMENT
(BARRINGTON RIVER AND WARREN BRIDGES)
BRIDGE NO. 083751 & 083851
ENTIRE PROJECT ESTIMATING


BR. 083751 & 083851 RAIL DETAILS 3

REVISIONS		DATE		BY		CHECKED BY	
NO.	DATE	NO.	DATE	NO.	DATE	NO.	DATE
1		2		3		4	


1 Cedar Street
Suite 400
Barrington, RI 02803
401.272.2100

AETNA
277.072.072
Small Business
Insurance Broker


REV	NO.	DATE	BY	CHKD	APP'D	PROJECT NO.	DATE	SCALE	SHEET NO.	TOTAL SHEETS
1		08/03/2022	BR			BR0-083851	2022	38	38	38

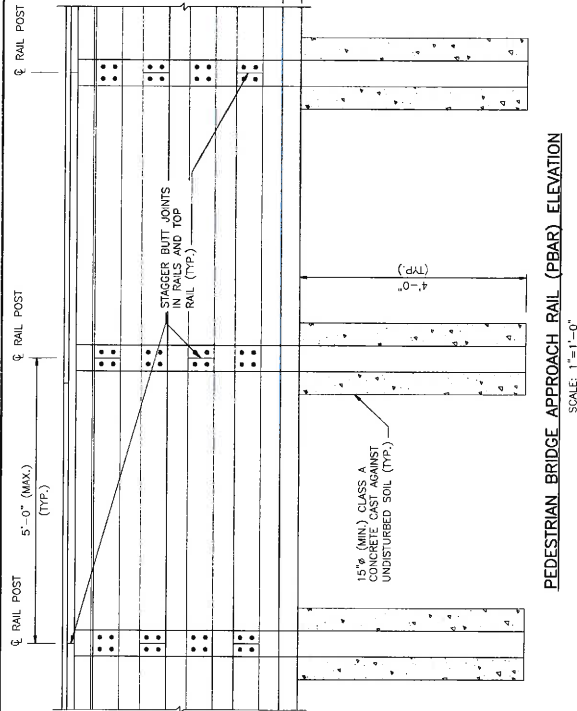


PEDESTRIAN BRIDGE APPROACH RAIL (PBAR) ELEVATION
SCALE: 1"=1'-0"

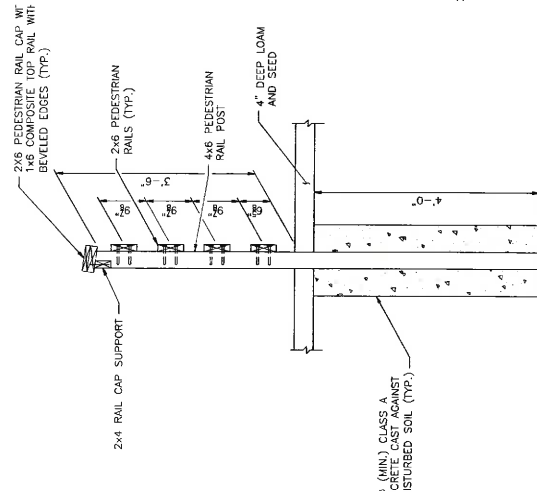


PEDESTRIAN BRIDGE APPROACH RAIL (PBAR) DETAIL
SCALE: 1"=1'-0"

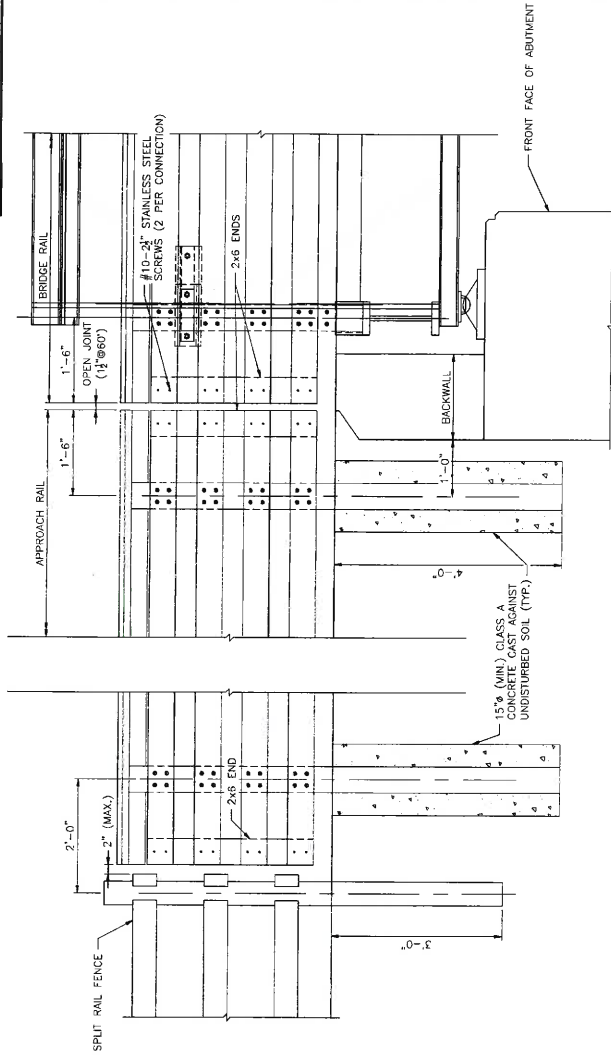

PEDESTRIAN RAIL TREATMENT AT
SPLIT RAIL FENCE DETAIL
SCALE: 1"=1'-0"

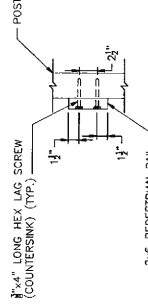

SECTION AT RAILING POST CONNECTION

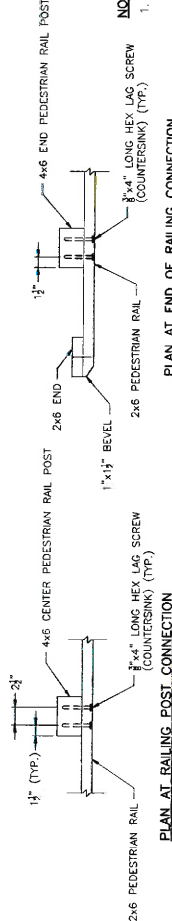

PLAN AT END OF RAILING CONNECTION

NOTES:

- WHERE POSTS ARE INSTALLED IN REINFORCED BACKFILL, POST LOCATIONS SHALL BE INDICATED BY A DOTTED LINE. PROVIDE CUTOUPS IN GEOTEXTILE REINFORCEMENT BACKFILL PROVIDE CUTOUPS IN GEOTEXTILE REINFORCEMENT. GEOTEXTILE SHALL NOT BE DAMAGED WHEN POST HOLES ARE EXCAVATED.
- SEE ADDITIONAL NOTES ON BR. 083751 & 083851 BRIDGE RAIL DETAILS 1.

TYPICAL RAIL CONNECTION DETAILS
SCALE: 1/2"=1'-0"

1 Cedar Street
Suite 400, #02083
401.272.6106

RHODE ISLAND
DEPARTMENT OF TRANSPORTATION

BRIDGE NO. 083751 & 083851
BARRINGTON RIVER AND WARREN BRIDGES
ENVIRONMENTAL PERMITTING
BRIDGE ISLAND

BR. 083751 & 083851 RAIL DETAILS 4

SCALE: 1/2"=1'-0"

BR. 083751 & 083851 RAIL DETAILS 4

CRMC Mailing List for Department of Transportation
CRMC File Number 2023-04-094

Department of Transportation Attn: Alisa Richardson 360 Lincoln Avenue Warwick, RI 02888 Alisa.Richardson@dot.ri.gov Erik.Johnston@dot.ri.gov Hamid.Akinfolarin@dot.ri.gov Anthony.pompei@dot.ri.gov	CRMC (2023-04-094) O. S. Government Center 4808 Tower Hill Road Wakefield, RI 02879 LTurner@crmc.ri.gov
RIDEM/ Technical & Customer Asst. 235 Promenade Street Providence, RI 02908-5767	Grace M. Anderson 23 Surrey Road Barrington, RI 02806
Town of Barrington 283 County Road Barrington, RI 02806	Christopher & Kerin Lowe 14 New Meadow Road Barrington, RI 02806
Warren German American Club 27 Kelly Street Warren, RI 02885	Scott Hobson VHB shobson@vhb.com
Town of Warren 514 Main Street Warren, RI 02885	Howard Dooley Howard.dooley@gmail.com
RI Salt Water Anglers Association Scott Travers travers@risaa.org	Stephen and Jane Mainella 81 County Road; Barrington, RI 02806 mainellaj@gmail.com
Richard Hittinger hittinger@risaa.org	Alex Brown al.brownman@gmail.com
Adam Rojek arojek1212@gmail.com	Benjamin Carlson carlsonb21@icloud.com
William Hayes whayesri@gmail.com	Bill Laird bl52752@gmail.com
Tom Horn th.4000@icloud.com	Geoffrey McNally 84 Crest Road; Tiverton, RI 02878 jeff_ri@cox.net
William Hitchcock w.tim.hitchcock@gmail.com	A. Elhusseini amelhusseini@gmail.com
Brian Hunt BHunt@barrington.ri.gov	Nelson Hawkins nelson.hawkins.jr@wellsfargoadvisors.com
Caroline Contrata ccontrata@gmail.com	William Jacobson wjacob7991@aol.com
M Woods NE Chapter Backcountry Hunters & Anglers rhodeisland@backcountryhunters.org	