



State of Rhode Island
Coastal Resources Management Council
Oliver H. Stedman Government Center
4808 Tower Hill Road, Suite 3
Wakefield, RI 02879-1900

(401) 783-3370
Fax (401) 783-2069

PUBLIC NOTICE

File Number: 2025-12-033

Date: January 6, 2026

This office has under consideration the application of:

BDPS, LLC
c/o Charles E. Booth III
100 Water Street.
East Providence, RI 02914

for a State of Rhode Island Assent to:

As part of a previously issued CRMC assent, temporary improvements were approved to an existing work trestle in conjunction with the Washington Bridge Demolition Project. In this application under consideration, the applicant is proposing no additional work but is seeking assent to retain these temporary improvements to the trestle and establish a structural perimeter limit (SPL) around the structure.

Project Location:	100 Water Street
City/Town:	East Providence
Plat/Lot:	Plat 16; Lots 1-1
Waterway:	Seekonk River

Plans of the proposed work can be requested at Cstaff1@crmc.ri.gov.

In accordance with the Administrative Procedures Act (Chapter 42-35 of the Rhode Island General Laws) you may request a hearing on this matter.

You are advised that if you have good reason to enter protests against the proposed work it is your privilege to do so. It is expected that objectors will review the application and plans thoroughly, visit site of proposed work if necessary, to familiarize themselves with the conditions and cite what law or laws, if any, would in their opinion be violated by the work proposed.


If you desire to protest, you must attend the scheduled hearing and give sworn testimony. A notice of the time and place of such hearing will be furnished you as soon as possible after receipt of your request for hearing. If you desire to request a hearing, to receive consideration, it should be in writing (**with your correct mailing address, e-mail address and valid contact number**) and be received at this office on or before **February 6, 2025**.

Please email your comments/hearing requests to: cstaff1@crmc.ri.gov; or mail via USPS to: Coastal Resources Management Council; O. S. Government Center, 4808 Tower Hill Road, Rm 116; Wakefield, RI 02879.

PROPERTY OF BDPS, LLC EXISTING CONDITIONS TRESTLE PERMIT

CITY OF EAST PROVIDENCE
COUNTY OF PROVIDENCE

SHEET NO.	DESCRIPTION
1	COVER SHEET AND GENERAL NOTES
2	SURVEY PLAN AND EXISTING LAYOUT
3	TRESTLE PLAN
4	TRESTLE PROFILE
5	TRESTLE FRAMING PLAN
6	SECTION AND DETAILS

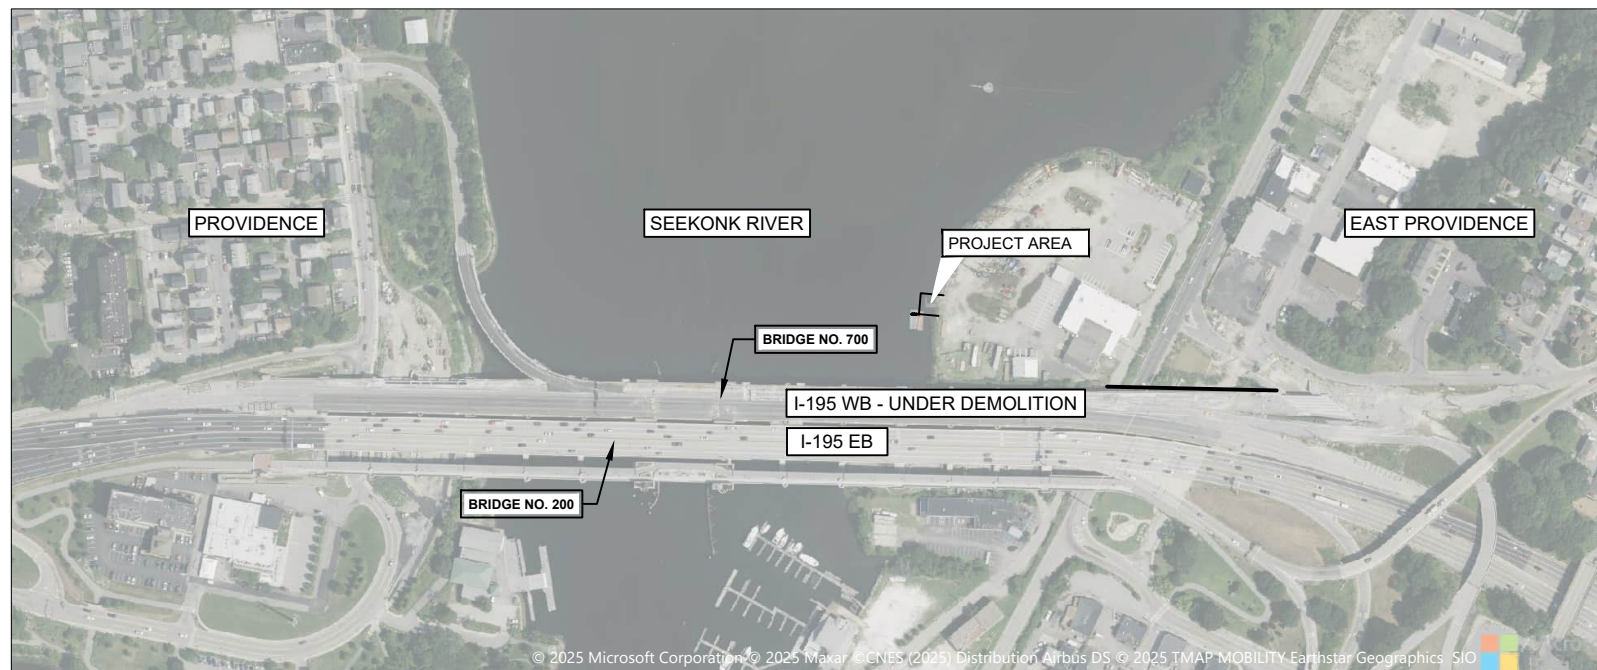

LAYOUT PLAN
SCALE: 1"=200'

GENERAL NOTES

- LANDSIDE TOPOGRAPHY AND EXISTING CONDITIONS PLAN INFORMATION FOR THE PROPOSED AREA IS DEVELOPED FROM THE SURVEY PERFORMED, PREPARED AND PROVIDED BY NARRAGANSETT ENGINEERING INC., DATED 11/05/2025. REFER TO DRAWING SHEET 2 FOR SURVEY PLAN. ALL DIMENSIONS ARE IN FEET AND DECIMAL FEET. ELEVATIONS ARE REFERENCED TO THE NORTH AMERICAN VERTICAL DATUM OF 1988 (NAVD 88).
- CRMC WATER TYPE CLASSIFICATION AT THE PROPOSED SITE IS TYPE 4 PER RHODE ISLAND CRMC.
- WORK TRESTLE IMPROVEMENT TO THE DECK AND LANDSIDE FOOTING WERE AUTHORIZED AS TEMPORARY IMPROVEMENTS PER CRMC ASSENT A2025-02-013 ISSUED FEBRUARY 2025 AND USACE FILE NUMBER NAE-2020-01204 ISSUED IN JUNE 2025. CRMC ASSENT 1987-12-037 ISSUED IN DECEMBER OF 1987 AUTHORIZED THE EXISTING SHORELINE IMPROVEMENTS, INCLUDING THE EXISTING RIPRAP REVETMENT BORDERING THE SEEKONK RIVER.
- AS-BUILT DIMENSIONS AND MATERIALS IDENTIFIED ON THESE SHEETS FOR THE TRESTLE ARE FROM DRAWINGS AND CALCULATIONS DEVELOPED BY TRANSITION ENGINEERING INC., DATED 9/26/2024 TO AETNA BRIDGE COMPANY. THE DESIGN LOADS ARE BASED ON A CAT 390 EXCAVATOR.
- LOCATION OF WORK TRESTLE IS NOT IN A HIGH FETCH AREA PER REQUIREMENTS IN CRMC § 1.3.1.D.12

Jacobs
100 Great Meadow Road, Suite 707
Wethersfield, CT 06109

DESIGNED BY: MAA
CHECKED BY: MDA
DATE: NOVEMBER 2025
SHEET: 1
OF: 6


SCALE AS NOTED

REVISIONS			REVISIONS		
NO.	DATE	BY	NO.	DATE	BY

PROPERTY OF BDPS, LLC

EAST PROVIDENCE EXISTING CONDITIONS RHODE ISLAND

COVER SHEET AND GENERAL NOTES

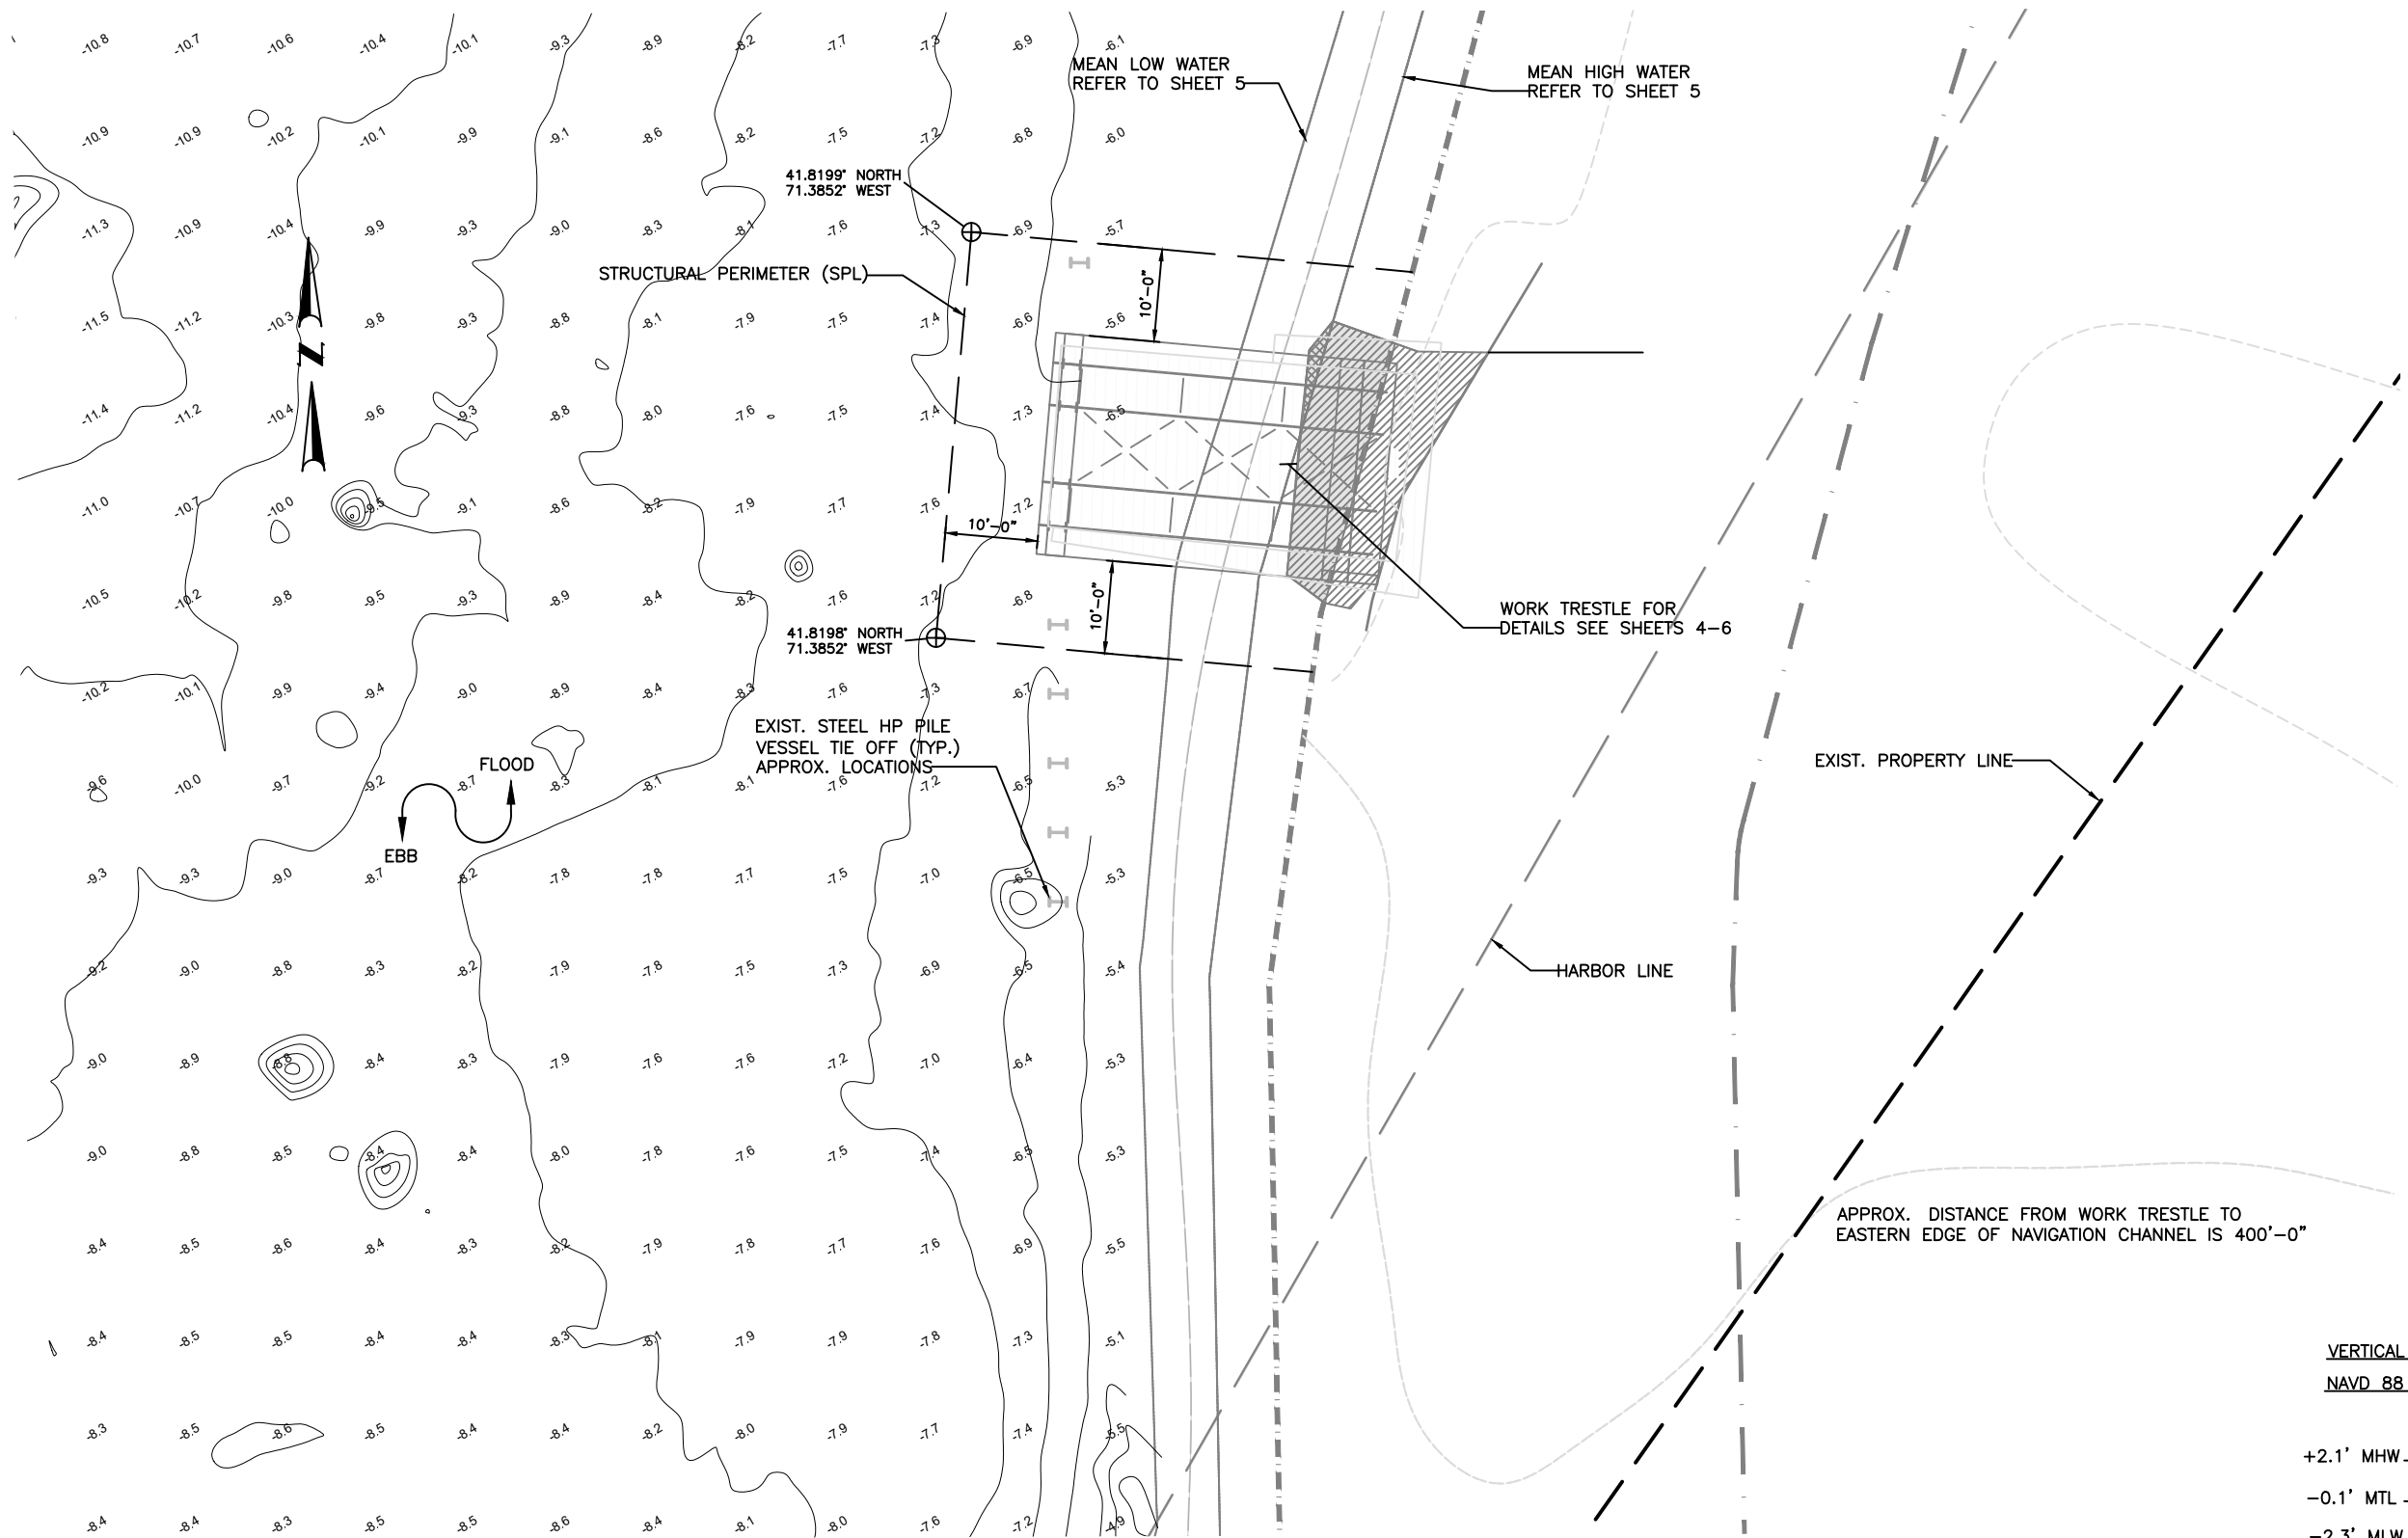

TRESTLE PLAN



*ORIGINAL SHEET SIZE IS 22"x34"

NOTES

1. TOPOGRAPHY AND EXISTING CONDITIONS INFORMATION ARE BASED ON THE FIELD SURVEY DRAWING DEVELOPED BY NARRAGANSETT ENGINEERING INC. DATED NOVEMBER 5, 2025.

VERTICAL DATUM CONVERSION
NAVD 88 DATUM MLW DATUM

+2.1' MHW	EL. 4.4' MHW
-0.1' MTL	EL. 2.2' MTL
-2.3' MLW	EL. 0' MLW

VERTICAL DATUM




GRAPHIC SCALE



DESIGNED BY:	MAA	SCALE AS NOTED					
CHECKED BY:	MDA						
DATE:	NOVEMBER 2025	REVISIONS			REVISIONS		
SHEET:	3	NO.	DATE	BY	NO.	DATE	BY
OF:	6						

PROPERTY OF BDPS, LLC
EAST PROVIDENCE EXISTING CONDITIONS RHODE ISLAND
TRESTLE PLAN

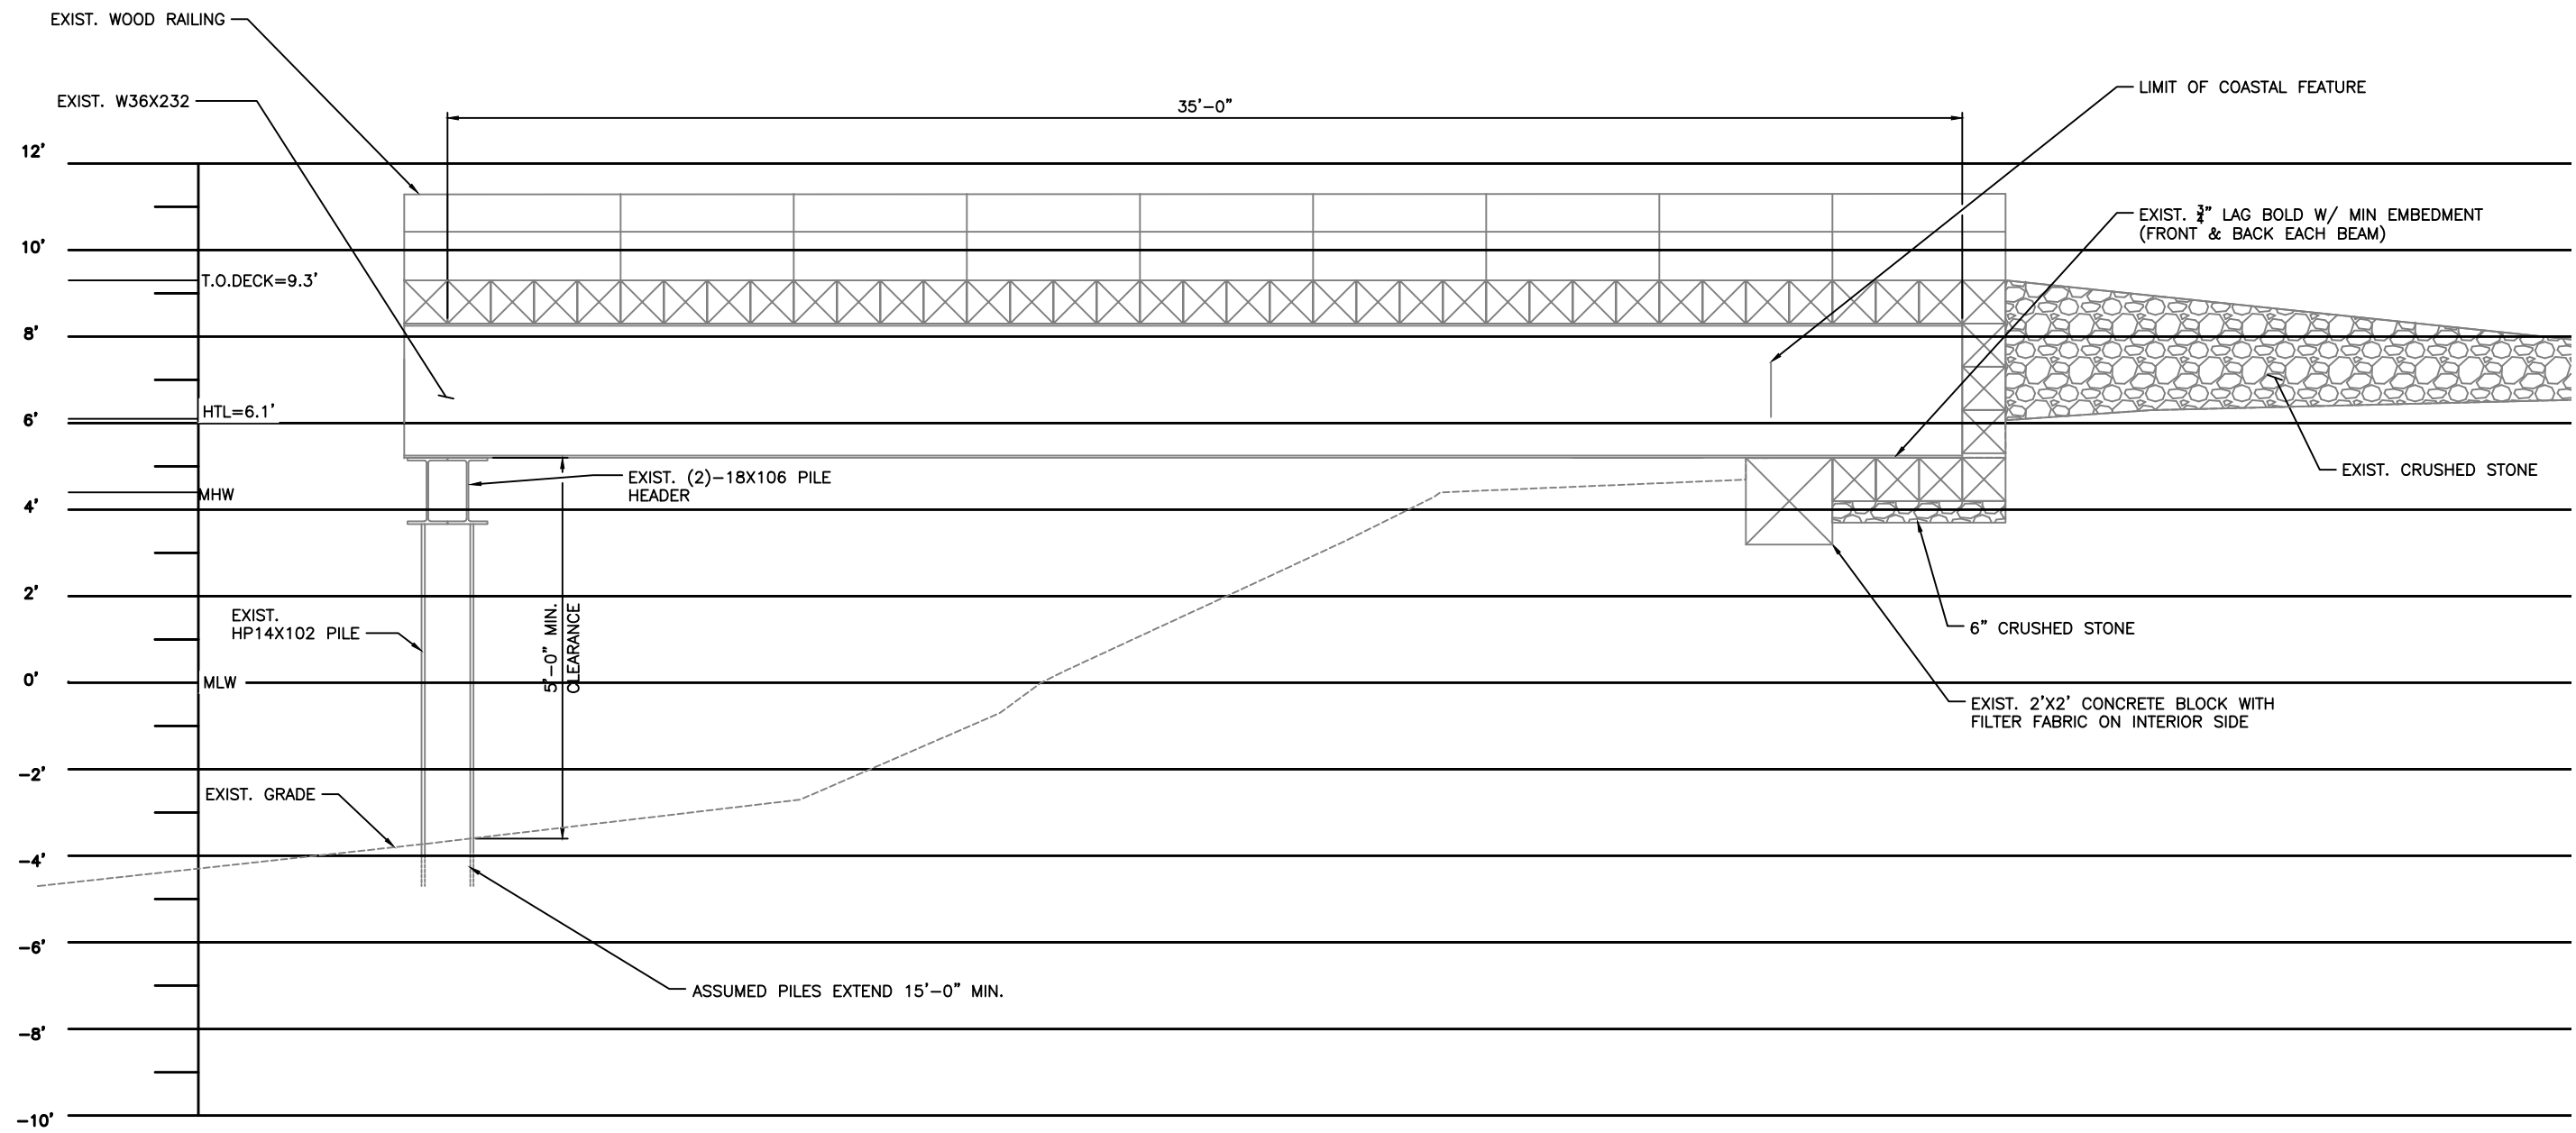

TRESTLE PROFILE



*ORIGINAL SHEET SIZE IS 22"X34"

- NOTES:
- TRESTLE WORK IMPROVEMENTS ARE MODELED BASED ON DRAWINGS DEVELOPED BY TRANSITION ENGINEERING INC. DATED 9/26/2024
 - SEDIMENT AT RIVER BOTTOM IS SANDY MUCK

VERTICAL DATUM CONVERSION
 NAVD 88 DATUM MLW DATUM

+2.1' MHW	EL. 4.4' MHW
-0.1' MTL	EL. 2.2' MTL
-2.3' MLW	EL. 0' MLW

VERTICAL DATUM



Jacobs
 100 Great Meadow Road, Suite 707
 Wethersfield, CT 06109

DESIGNED BY:	MAA	SCALE AS NOTED					
CHECKED BY:	MDA						
DATE:	NOVEMBER 2025	REVISIONS			REVISIONS		
SHEET:	4	NO.	DATE	BY	NO.	DATE	BY
OF:	6						

PROPERTY OF BDPS, LLC
 EAST PROVIDENCE EXISTING CONDITIONS RHODE ISLAND
TRESTLE PROFILE

CRMC Mailing List for BDPS, LLC
CRMC File Number 2025-12-033

BDPS, LLC
c/o Charles E. Booth III
100 Water Street
East Providence, RI 02914
Charlieb@american-equipment.com

Jacobs Engineering
Craig Wood
cwoodpws@gmail.com

CRMC (PN 2025-12-033)
O. S. Government Center
4808 Tower Hill Road
Wakefield, RI 02879
Cstaff1@crmc.ri.gov
msherman@crmc.ri.gov

RI Dept of Transportation
2 Capitol Hill
Providence, RI 02903

Diaz Holdings LLC
1129 W Linden St
Allentown, PA 18102

City of East Providence Email List
General Statewide Email List

Lisa Turner

From: Lisa Turner
Sent: Wednesday, January 7, 2026 11:52 AM
To: Charlieb@american-equipment.com; Craig Wood, NRPS
Cc: Mason Sherman; Lisa Turner
Subject: Public Notice - CRMC File 2025-12-033 - BDPS, LLC - East Providence
Attachments: Public Notice CRMC File 2025-12-033 - BDPS LLC - East Providence.pdf

Good Afternoon: The attached Public Notice is being sent to you, the applicant and consultant, via email. Please note the Public Notice closing date is February 6, 2026. Please feel free to contact CRMC if you have any questions.

The Public Notice is also being sent to:
Project Abutters via USPS;
City of East Providence Email List; and
CRMC General Statewide Mailing List.

Cordially,

Lisa Turner

Lisa A. Turner, Programming Services Officer
aka Office Manager and Record Keeper
Coastal Resources Management Council
Oliver Stedman Government Center
4808 Tower Hill Road; Room 116
Wakefield, RI 02879
401-783-3370

Lisa Turner

From: Lisa Turner
Sent: Wednesday, January 7, 2026 2:12 PM
To: Andreza Skipworth, East Providence City Clerk; Anna Sousa, East Providence Councilwoman; Daniel Borges, East Providence Public Wks Dept; Edward Pimentel AICP, East Providence Zoning Officer; Erik Skadberg, East Providence City Engineer; Francis Fogarty, East Providence Councilman; Frank Rego, East Providence Council VP; James Wertheimer; Jenni Furtado, Representative, E Providence, Pawtucket; Katherine Kazarian, Representative, E Providence, Pawtucket; Keith A Brynes, East Providence Planning Dir; Matt Dawson, Representative, East Providence; Michael Carey, Fire Chief, East Providence; Michael Rapoza, Chief of Police, East Providence; Raymond Lavey, Exec Dir, E Prov Waterfront Comm; Rick Lawson, East Providence Councilman; Robert Britto, Senator, East Providence; Robert Rodericks, East Providence Council President; Robert Walker, East Providence Building Official; Roberto L DaSilva, Mayor, East Providence; Sarah Frew, East Providence Tax Assessor; Scott Pickering, GM, Eastbay Newspapers; Valarie J. Lawson, Senator, East Providence; Wayne Barnes, East Providence Sr Planner
Subject: Public Notice - CRMC File 2025-12-033 - BDPS, LLC - East Providence
Attachments: Public Notice CRMC File 2025-12-033 - BDPS LLC - East Providence.pdf

Good Afternoon: Please see the attached 30-day Public Notice of CRMC Application 2025-12-033 BDPS, LLC, East Providence. Public comments must be submitted to CRMC on or before February 6, 2026.

Cordially,

Lisa Turner

Lisa A. Turner, Programming Services Officer
aka Office Manager and Record Keeper
Coastal Resources Management Council
Oliver Stedman Government Center
4808 Tower Hill Road; Room 116
Wakefield, RI 02879
401-783-3370

Lisa Turner

From: Lisa Turner
Sent: Wednesday, January 7, 2026 12:00 PM
To: Amanda Barker; Amy Rose Weinreich, Charlestown TC; Audubon Society of Rhode Island; Beth E. Ashman, Cranston Acting City Planner; Bruce Eastman RISA; Catherine Hall, Esq., Save The Bay; Catie Alves, STB CoastKeeper; Charlotte Taylor; Chris Dodge, Save The Bay; Christine Andrews, QDC; Chuck Horbert, RIDEM; Daniel B Breen, CIV USARMY CENAE; David Latham; David Murdock; Deborah Mongeau, Librarian; Edward A Mello, Jamestown Town Admin; Elizabeth Totten; Eric Schneider, RIDEM Fish and Wildlife; Frank Corrao, Acting Director, Cranston Public Works; Jean Bellm, Exec Asst, Barrington; Jeanne Spencer, Tiverton Town Clerk's Office; Jeannette Alyward, North Kingstown TC; Jed Thorp, Director of Advocacy, Save The Bay; Jeff Willis; Jeffrey C. Hall, Exec. Dir, ASRI; Jeffrey Gardner; Jennifer M. West , Portsmouth TC; Jessica Capaldi, Deputy Clerk Warren; Joan Chabot, Town Clerk, Tiverton; John Brown, THPO, Narragansett Indian Tribe; John Rago; John Torgan; John Williams, Warwick Cove Marina; Jude Zeh; Kathy & Steve Jacques; Kathy & Steve Jacques; Kevin R. Kotelly, USACOE; Laura C. Swistak, City Clerk, Newport; Laura Dwyer (CRMC); Leah Stoddard, E Prov Deputy Clerk; Leslie Martin, USARMY USACE; Lisa Turner; Lynn D'Abrosca, City Clerk, Warwick; Mary Leblanc, Westerly Town Clerk; Matt Gineo, Oldport Marine; Matt O'Brien, AP Reporter; Melissa Cordeiro, Bristol Town Clerk; Michael Arguello, RIDEM Water Resources; Michael McGiveney; Neal Personeus, RIDEM; Nichole Romane, Town Clerk, South Kingstown; Nick Donadio; Peter A. Healey; Peter M. Vieira, Marine Construction; Phil Capaldi; Philip Hervey, Town Manager; Providence City Clerk; Rebecca Russell RIDEM Water Resources; Reuben Macfarlan, RIDEM/DMF; RIAG/Environmental & Energy Unit; Rich Hittinger, RISAA; Richard DeSalvo, RI Moorings; Richard Goldstein Pawtucket TC; Richard Langseth; Robert Lyons, Ocean House Marina; Robin Barlow, RI Builders; Rodman R. Black Jr. HIIA; Sandra Speroni, Town Clerk's Office; Sarah Frazar, RIDEM; Scott Briggs, Librarian; Shirley Frietag, NRPA President; Stephanie Bernardo, Barrington Town Clerk; Sue Cornachia; Taylor Ellis; Thomas R. Evans, State Librarian; Topher Hamblett, Save The Bay, Executive Director; Tracy A. Nelson, Cranston City Clerk; US ACOE CENAE RI; Wendy J. W. Marshall, Middletown TC
Subject: Public Notice - CRMC File 2025-12-033 - BDPS, LLC - East Providence
Attachments: Public Notice CRMC File 2025-12-033 - BDPS LLC - East Providence.pdf

Good Afternoon: Please see the attached 30-day Public Notice of CRMC Application 2025-12-033 BDPS, LLC, East Providence. Public comments must be submitted to CRMC on or before February 6, 2026.

Cordially,
Lisa Turner

Lisa A. Turner, Programming Services Officer
aka Office Manager and Record Keeper
Coastal Resources Management Council
Oliver Stedman Government Center
4808 Tower Hill Road; Room 116
Wakefield, RI 02879
401-783-3370